
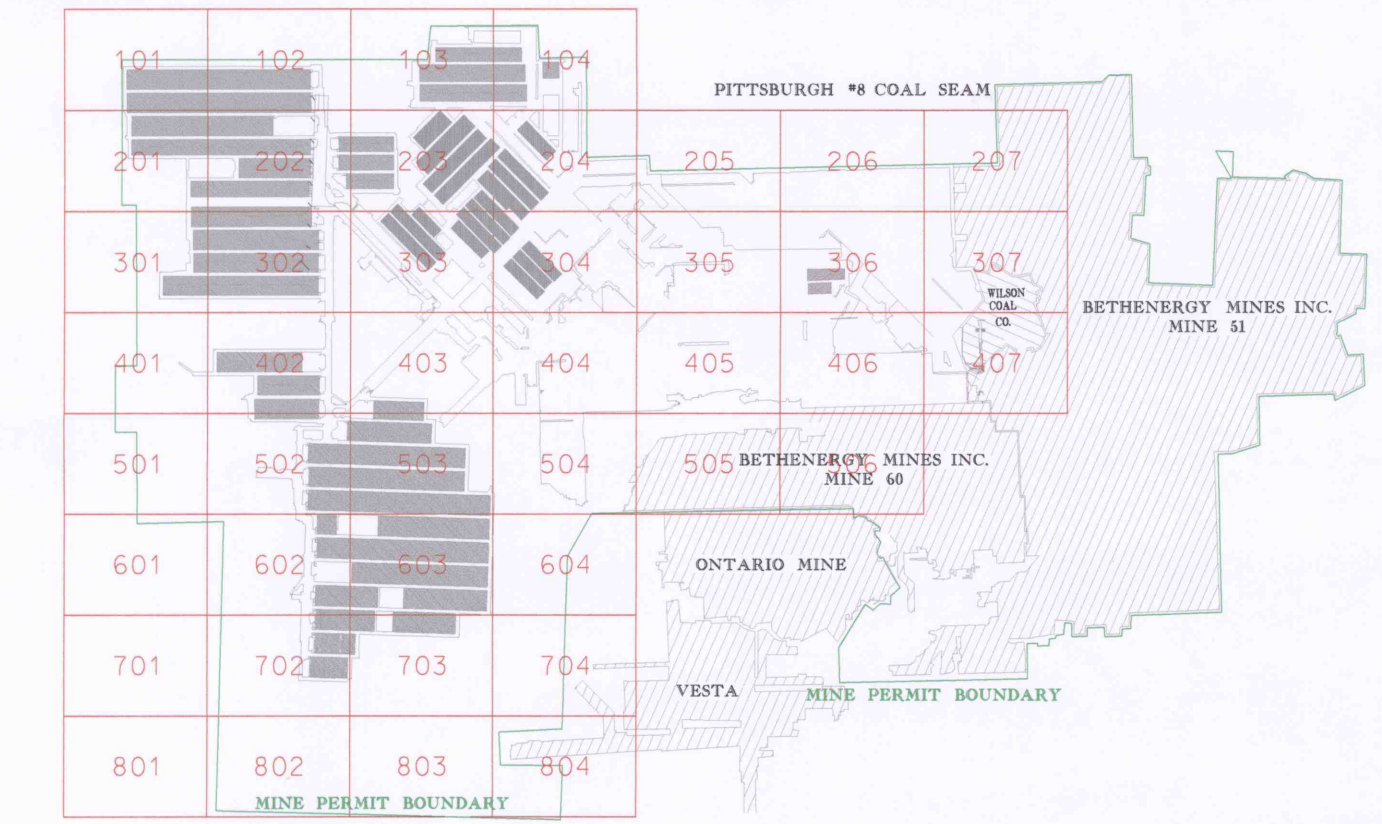


MATCH TO SHEET 403

MATCH TO SHEET 405

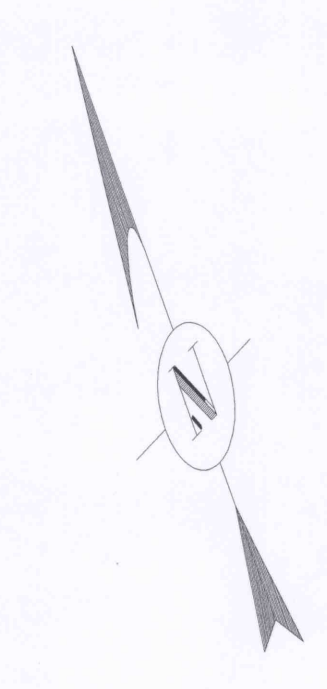

This map submitted in accordance with 30 CFR Sec. 75.1004 & PA Act 55 SB 949 Sec. 228. PERSONS PROVIDING INFORMATION ON MAP:  
 MARK HULTAY, MINE FOREMAN  
 NATHAN WOODS, MINE ENGINEER TRAINEE

INFORMATION INCORPORATED IN THIS MINE MAP HAS BEEN PROVIDED BY THE OPERATOR AND PREVIOUS OPERATORS AND MAY NOT HAVE ALL BEEN VERIFIED OR EVALUATED BY THE UNDERSIGNED. THIS MAP MAY ALSO INCORPORATE THE SURVEY RESULTS AND MAPPING PREPARED UNDER THE DIRECTION OF REGISTERED ENGINEERS OTHER THAN THE UNDERSIGNED, SUBJECT TO THE APPLICABLE QUALIFICATIONS TO THE BEST OF MY KNOWLEDGE AND BELIEF. THIS DRAWING CONTAINS ACCURATE INFORMATION AND HAS BEEN COMPILED IN ACCORDANCE WITH 2005 ENGINEERING PRACTICES. AS OF MARCH 15, 2005, MINE MAPS PREPARED BY STANDARDS ACCORDING TO PA DEP PERMITS NO. 33-200-010 SEC. 22.8 PENNSYLVANIA STATE PLANE COORDINATE GRID (NAD83 DATUM).

CHAIN OF OWNERSHIP  
 OWNER/LESSOR  
 RESERVE COAL PROPERTIES CO. 1/18/2001 - PRESENT  
 LUCERNE LAND CO. 12/30/1992 - 10/6/2000  
 BETHELEN STEEL CORP. 12/24/1968 - 12/30/1992  
 CONSOLIDATION COAL CO. 05/01/1958 - 12/24/1968  
 PITTSBURGH CONSOLIDATION COAL CO. 11/23/1945 - 05/01/1958

LESSEE/OPERATOR  
 EIGHTY FOUR MINING CO. 12/30/1992 - PRESENT  
 METENREY MINES, INC. 01/01/1991 - 12/30/1992

EIGHTY FOUR MINING COMPANY  
 MINE #4  
 P.O. BOX 1  
 CLAYSVILLE, PA 15233

MDHA I.D. NO. 36-00958  
 PA DEP CHMP NO. 63831502  
 SCALE: 1" = 200'  
 FINAL MINE MAP  
 NOVEMBER 28, 2011

RELIEF/WATER MONITORING BOREHOLE  
 HORIZONTAL & VERTICAL CONTROL  
 STREAM  
 IDENTIFIED GAS WELL  
 ALLEGED WELL  
 EXPLORATION CORE HOLE  
 SEAL  
 MINE PERMIT BOUNDARY  
 NO KNOWN MINE WORKINGS UNDERLYING OR OVERLYING THE MINE PROPERTY  
 MN SURVEY ACCURACY: +10,000 (CLOSED LOOP)

ALL BOREHOLES SEALED EXCEPT PRESSURE RELIEF/WATER MONITORING BOREHOLES  
 (HULLAW POWER, HESTAVA VENTILATION, WOODRIDGE, LIVINGSTON CONCRETE, LONG SHAFI BOREHOLE, ROBINSON POWER, WEST POWER, & ZENKER POWER)

