


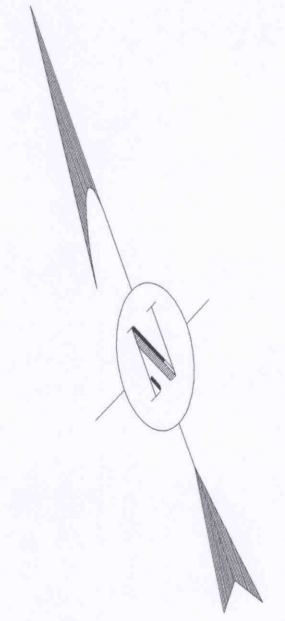


MATCH TO SHEET 503

MATCH TO SHEET 505

MATCH TO SHEET 604



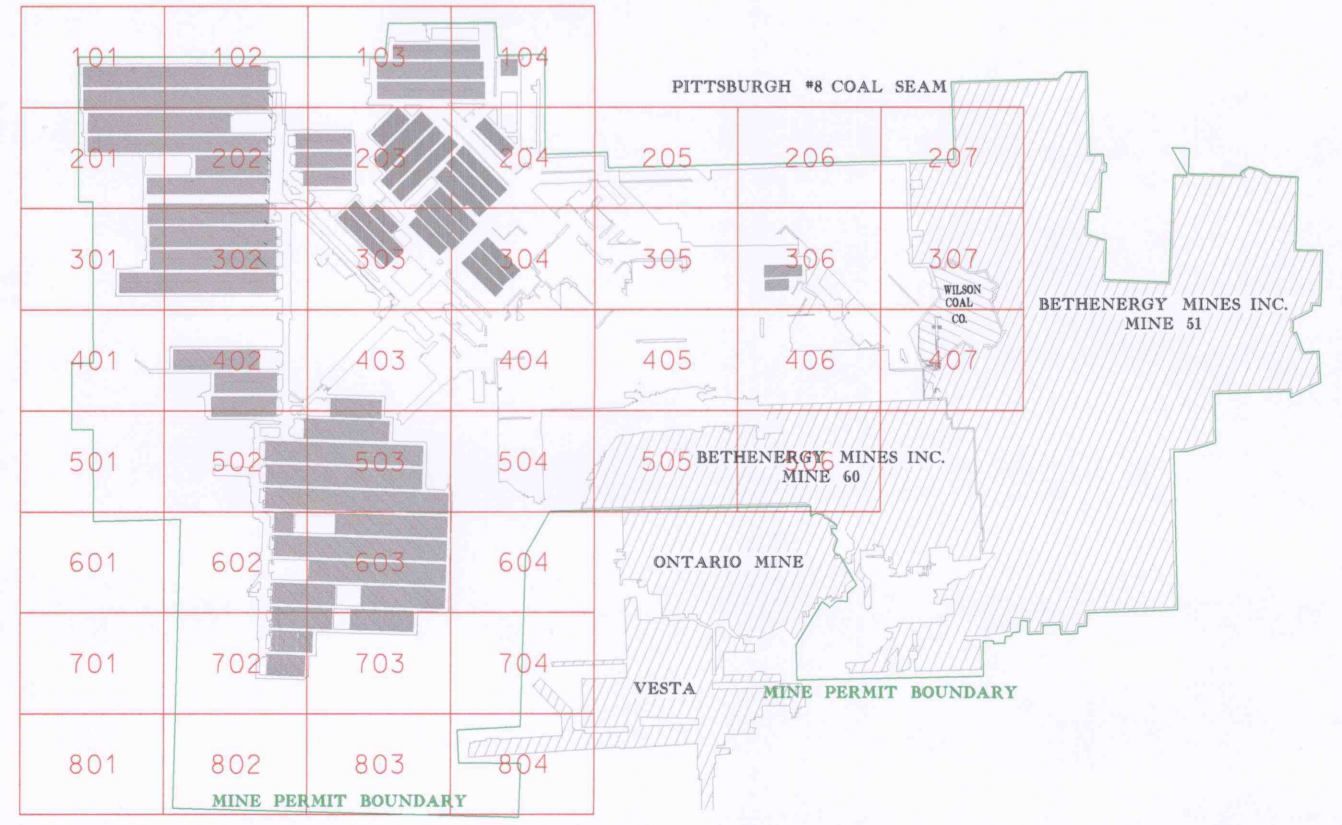

This map submitted in accordance with 30 CFR Sec. 75.1204 & PA Act 55 SB 949 Sec. 228. PERSONS PROVIDING INFORMATION ON MAP: MARK HULSHAY, MINE FOREMAN; NATHAN WOODS, MINE ENGINEER TRAINEE.

INFORMATION INCORPORATED IN THIS MINE MAP WAS PROVIDED BY THE OPERATOR AND PREVIOUS OPERATORS AND MAY NOT HAVE ALL BEEN VERIFIED OR EVALUATED BY THE UNDERSIGNED. THE MAP MAY ALSO INCORPORATE THE SURVEY RESULTS AND MAPPING PREPARED UNDER THE DIRECTION OF REGISTERED ENGINEERS OTHER THAN THE UNDERSIGNED, SUBJECT TO THE INFORMATION QUALIFICATIONS TO THE BEST OF MY KNOWLEDGE AND BELIEF. THIS DRAWING CONTAINS ACCURATE INFORMATION AND HAS BEEN COMPILED IN ACCORDANCE WITH GOOD ENGINEERING PRACTICES. AS OF MARCH 19, 2005, MINE MAPS PREPARED BY STANDARDS ACCORDING TO PA DEP 100-NO 50-3-200-8D SEC. 22.8 PENNSYLVANIA STATE PLANE COORDINATE GRID (NAD83 DATUM).

CHAIN OF OWNERSHIP:
 OWNER/LESSOR: REEVES COAL PROPERTIES CO. 11/18/2001 - PRESENT; LICENSURE LAND CO. 12/30/1992 - 10/16/2000; BETHLEHEM STEEL CORP. 12/24/1988 - 12/30/1992; CONSOLIDATION COAL CO. 05/01/1958 - 12/24/1988; PITTSBURGH CONSOLIDATION COAL CO. 11/23/1945 - 05/01/1958.
 LESSEE/OPERATOR: EIGHTY FOUR MINING CO. 12/30/1992 - PRESENT; BETHLEHEM MINES, INC. 07/09/1997 - 12/30/1992.

EIGHTY FOUR MINING COMPANY
 MINE #4
 P.O. BOX 1
 CLAYVILLE, PA 15323

MSHA I.D. NO. 38-00908
 PA DEP CMAP NO. 8363502
 SCALE: 1" = 250'
 FINAL MINE MAP
 NOVEMBER 26, 2011

RELIEF/WATER MONITORING BOREHOLE
 HORIZONTAL & VERTICAL CONTROL
 STREAM
 IDENTIFIED GAS WELL
 ALLEGED WELL
 EXPLORATION CORE HOLE
 SEAL
 MINE PERMIT BOUNDARY
 NO KNOWN MINE WORKINGS UNDERLYING OR OVERLYING THE MINE PROPERTY
 MN SURVEY ACCURACY: ±10,000 (CLOSED LOOP)

ALL BOREHOLES SEALED EXCEPT PRESSURE RELIEF/WATER MONITORING BOREHOLES
 HALLAM POWER, HUSTATA VENTILATION, KOBIRINGLINE, LYNNSTON CONCRETE, LONG SHAFY BOREHOLE, RICHARDSON POWER, WER POWER, & ZEDKER POWER.

