
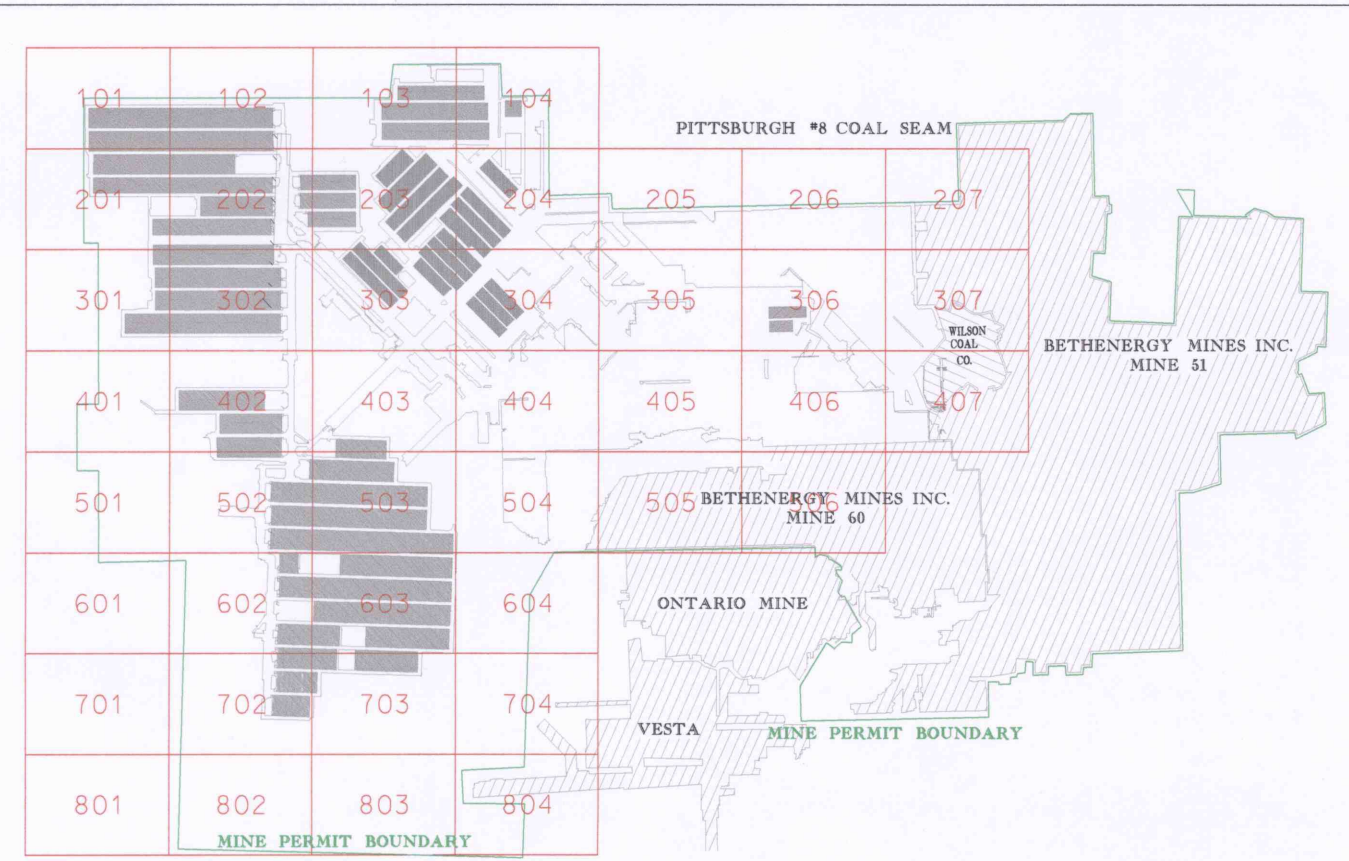


MATCH TO SHEET 701

MATCH TO SHEET 703

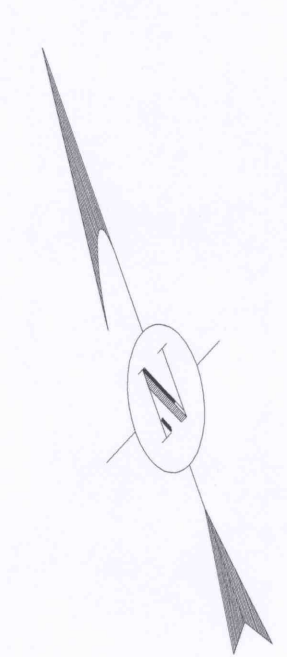

This map submitted in accordance with 32 CFR Sec. 75.1204 & PA Act 55 SB 949 Sec. 228
 PERSONS PROVIDING INFORMATION ON MAP:
 MARK HUSKAY, MINE FOREMAN
 NATHAN WOODS, MINE ENGINEER / TRAINER

INFORMATION INCORPORATED IN THIS MINE MAP WAS PROVIDED BY THE OPERATOR AND PREVIOUS OPERATORS AND MAY NOT HAVE ALL BEEN VERIFIED OR EVALUATED BY THE UNDERGROUND. THE MAP MAY ALSO INCORPORATE THE SURVEY RESULTS AND MAPPING PREPARED UNDER THE DIRECTION OF REGISTERED ENGINEERS OTHER THAN THE UNDERGROUND SUBJECT TO THE INFORMATIONED QUALIFICATIONS, TO INFORMATION AND HAS BEEN COMPILED IN ACCORDANCE WITH GOOD ENGINEERING PRACTICES AS OF MARCH 19, 2005. MINE MAPS PREPARED BY STANGROS ACCORDING TO PA DEP TCO NO. 963-2000-010 SEC. 22.8 PENNSYLVANIA STATE PLANE COORDINATE (NAD) DATUM.

CHAIN OF OWNERSHIP:
 OWNER/LESSOR
 RESERVE COAL PROPERTIES CO. 11/16/2001 - PRESENT
 LUCERNE LAND CO. 12/30/1992 - 11/16/2001
 BETHLEHEM STEEL CORP. 12/24/1988 - 12/30/1992
 CONSOLIDATION COAL CO. 05/01/1958 - 12/24/1988
 PITTSBURGH CONSOLIDATION COAL CO. 12/23/1945 - 05/01/1958

LESSEE/OPERATOR
 EIGHTY FOUR MINING CO. 12/30/1992 - PRESENT
 BETHLEHEM MINES, INC. 07/01/1987 - 12/30/1992

EIGHTY FOUR MINING COMPANY
 MINE #4
 P.O. BOX 1
 CLAYSVILLE, PA 15323

USMA ID. NO. 28-02858
 PA DEP OMP NO. 6283302
 SCALE: 1" = 200'
 FINAL MINE MAP
 NOVEMBER 28, 2011

RELIEF/WATER MONITORING BOREHOLE
 HORIZONTAL & VERTICAL CONTROL
 STREAM
 IDENTIFIED GAS WELL
 ALLEGED WELL
 EXPLORATION CORE HOLE
 SEAL
 MINE PERMIT BOUNDARY
 NO MINOR MINE WORKINGS UNDERLYING OR OVERLYING THE MINE PROPERTY
 MIN SURVEY ACCURACY: ±110.00 (CLOSED LOOP)

ALL BOREHOLES SEALED EXCEPT PRESSURE RELIEF/WATER MONITORING BOREHOLES (HALLAM POWER, JUSTAVA VENTILATION, WISH RINGLINE, LIVINGSTON CONCRETE, LONG SHAFT BOREHOLE, RICHMOND POWER, NEW POWER, & ZEDNER POWER)

