



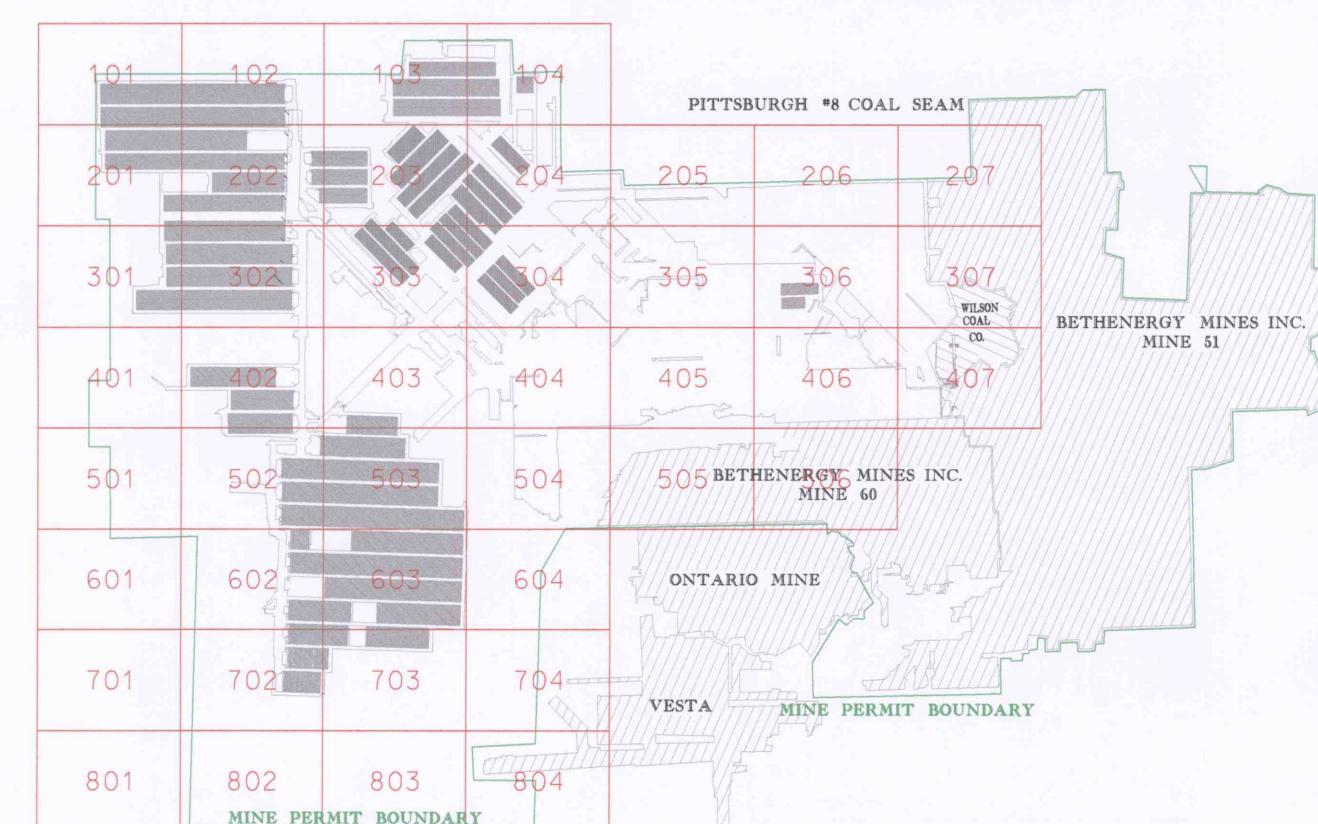

MATCH TO SHEET 702

MATCH TO SHEET 704

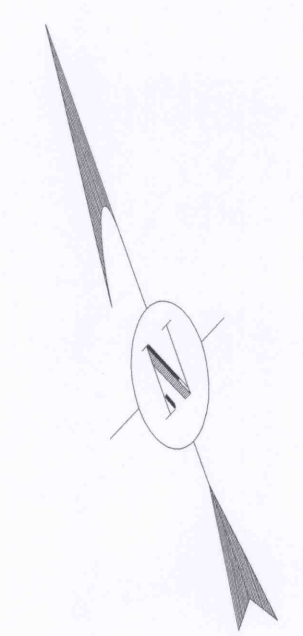

This map submitted in accordance with 30 CFR Sec. 75.1004 & PA Act 55 SB 949 Sec. 22B
 PERSONS PROVIDING INFORMATION ON MAP:
 MARK HULIKAY, MINE FOREMAN
 NATHAN WOODS, MINE ENGINEER TRANE

INFORMATION INCORPORATED IN THIS MINE MAP WAS PROVIDED BY THE OPERATOR AND PREVIOUS OPERATORS AND MAY NOT HAVE ALL BEEN VERIFIED OR EVALUATED BY THE UNDERSIGNED. THE MAP MAY ALSO INCORPORATE THE SURVEY RESULTS AND MAPPING PREPARED UNDER THE DIRECTION OF REGISTERED ENGINEERS OTHER THAN THE UNDERSIGNED. SUBJECT TO THE FOREMENTIONED QUALIFICATIONS, OTHER THAN THE UNDERSIGNED, I BELIEVE THIS DRAWING CONTAINS ACCURATE INFORMATION AND HAS BEEN COMPILED IN ACCORDANCE WITH GOOD ENGINEERING PRACTICES AS OF MARCH 19, 2005. MINE MAPS PREPARED BY: STANISLAW KUCHERA, P.E. (PA DEP REG NO. 983-3008-610 SEC 22-B PENNSYLVANIA STATE PLANE COORDINATE GRID (NAD83 DATUM))

CHAIN OF OWNERSHIP:
 OWNER/LESSOR: RESERVE COAL PROPERTIES CO. 11/16/2001 - PRESENT
 LUCERNE LAND CO. 12/30/1992 - 10/16/2001
 BETHLEHEM STEEL CORP. 12/24/1988 - 12/30/1992
 CONSOLIDATION COAL CO. 05/01/1958 - 12/24/1988
 PITTSBURGH CONSOLIDATION COAL CO. 11/23/1945 - 05/01/1958

LESSEE/OPERATOR:
 EIGHTY FOUR MINING CO. 12/30/1992 - PRESENT
 BETHLEHEM MINES, INC. 07/01/1987 - 12/30/1992

EIGHTY FOUR MINING COMPANY
 MINE #4
 P.O. BOX 1
 CLAYSVILLE, PA 15223

MSHA I.D. NO. 36-00958
 PA DEP CHAP. NO. 83B3302
 SCALE: 1" = 320'
 FINAL MINE MAP
 NOVEMBER 26, 2011

RELIEF/WATER MONITORING BOREHOLE
 HORIZONTAL & VERTICAL CONTROL
 STREAM
 IDENTIFIED GAS WELL
 ALLEGED WELL
 EXPLORATION CORE HOLE
 SEAL
 MINE PERMIT BOUNDARY
 NO MINE WORKINGS UNDERLYING OR OVERLYING THE MINE PROPERTY
 MIN SURVEY ACCURACY ±10,000 (CLOSED LOOP)

ALL BOREHOLES SEALED EXCEPT PRESSURE RELIEF/WATER MONITORING BOREHOLES
 (HALLAM POWER, HODAVA VENTILATION, KISHORINGLINE, LIVINGSTON CONCRETE, LONG SHFT BOREHOLE, RICHARDSON POWER, WEA POWER, & ZEDKER POWER)

