
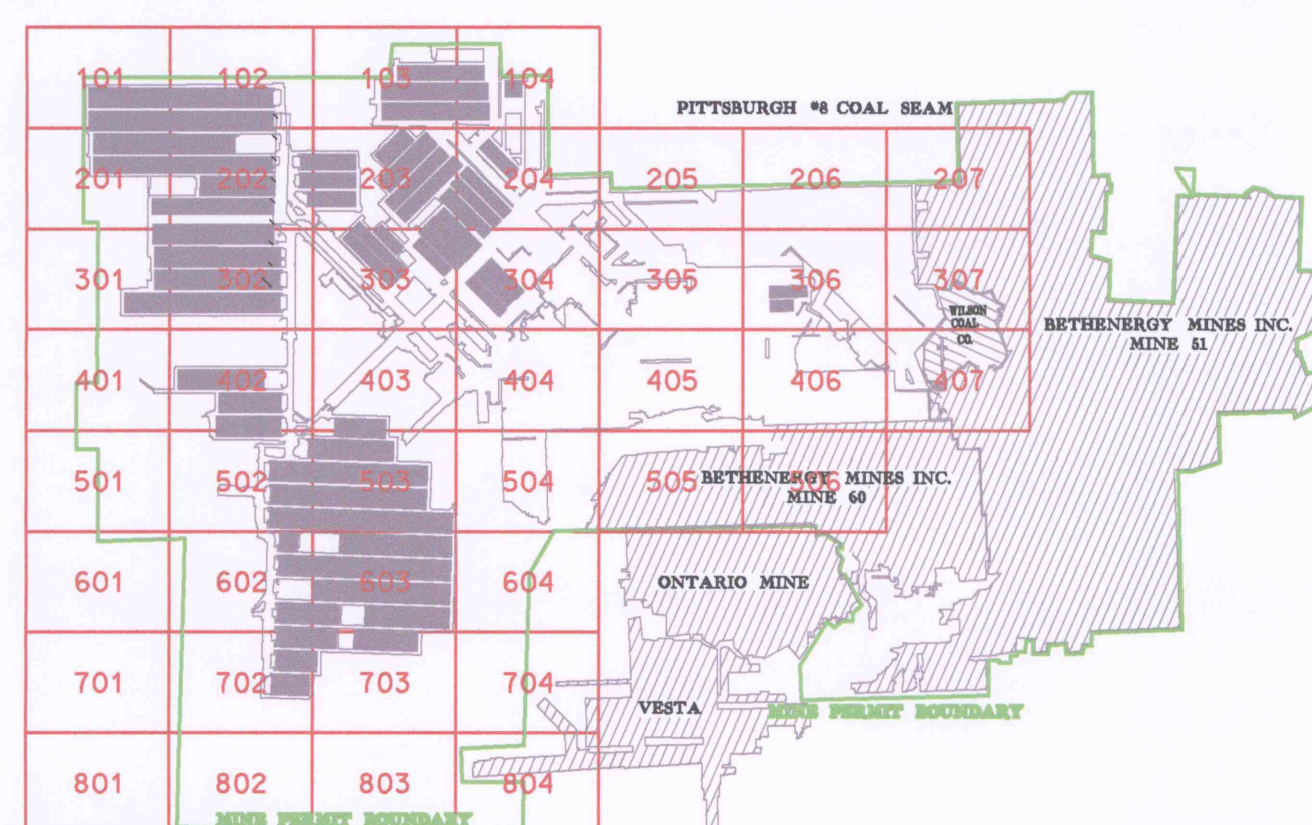


MATCH TO SHEET 302

MATCH TO SHEET 304

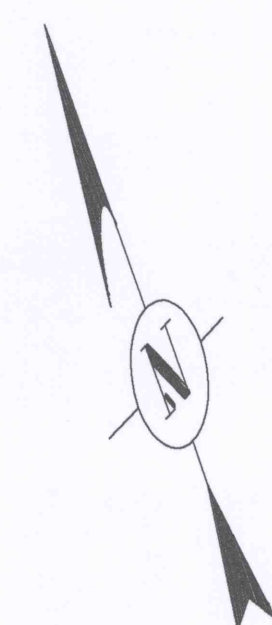

This map submitted in accordance with 30 CFR Sec. 75.1204 & PA Act 55 SB 949 Sec. 228
 PERSONS PROVIDING INFORMATION ON MAP:
 MARK HUBBARD, MINE FOREMAN
 NATHAN WOODS, MINE ENGINEER TRAINER

INFORMATION INCORPORATED IN THIS MINE MAP WAS PROVIDED BY THE OPERATOR AND PREVIOUS OPERATORS AND MAY NOT HAVE ALL BEEN VERIFIED OR EVALUATED BY THE UNDERSIGNED. THE MAP MAY ALSO INCORPORATE THE SURVEY RESULTS AND MAPPING PREPARED UNDER THE DIRECTION OF REGISTERED ENGINEERS OTHER THAN THE UNDERSIGNED, SUBJECT TO THE APPLICABLE QUALIFICATIONS TO THE BEST OF MY KNOWLEDGE AND BELIEF. THIS DRAWING CONTAINS ACCURATE INFORMATION AND HAS BEEN COMPILED IN ACCORDANCE WITH 2005 ENGINEERING PRACTICES, AS OF MARCH 19, 2005. MINE MAPS PREPARED BY STANDARDS ACCORDING TO PA DEP REG NO. 383-3000-010 SEC. 22.8 PENNSYLVANIA STATE PLANE COORDINATE GRID (NAD83 DATUM).

CHAIN OF OWNERSHIP:
 OWNER/LESSOR
 RESERVE COAL PROPERTIES CO. 11/6/2001 - PRESENT
 LUCERNE LAND CO. 12/30/1992 - 11/6/2001
 BETHLEHEM STEEL CORP. 12/24/1988 - 12/30/1992
 CONSOLIDATION COAL CO. 05/01/1958 - 12/24/1988
 PITTSBURGH CONSOLIDATION COAL CO. 11/23/1945 - 05/01/1958
 LESSEE/OPERATOR
 EIGHTY FOUR MINING CO. 12/30/1992 - PRESENT
 BETHENERSTY MINES, INC. 07/01/1987 - 12/30/1992

EIGHTY FOUR MINING COMPANY
 MINE #4
 P. O. BOX 4
 CLAYSVILLE, PA 15323

MINE ID. NO. 38-00058
 PA DEP. MAP NO. 83531302
 SCALE 1" = 200'
 FINAL MINE MAP
 NOVEMBER 28, 2011

- RELIEF/WATER MONITORING BOREHOLE
- HORIZONTAL & VERTICAL CONTROL
- STREAM
- IDENTIFIED GAS WELL
- ALLEGED WELL
- EXPLORATION CORE HOLE
- SEA
- MINE PERMIT BOUNDARY
- NO KNOWN MINE WORKINGS UNDERLYING OR OVERLYING THE MINE PROPERTY
- MINE SURVEY ACCURACY +110,000 (CLOSED LOOP)
- ALL BOREHOLES SEALED EXCEPT PRESSURE RELIEF/WATER MONITORING BOREHOLES
- HALLAM POWER, HUBBARD VENTILATION, KIRKBRINE, LIVINGSTON CONCRETE, LONG SHAFT BOREHOLE, RICHARDSON POWER, WEIR POWER, & ZEDKER POWER

