FIT TO - H

SHEET - J

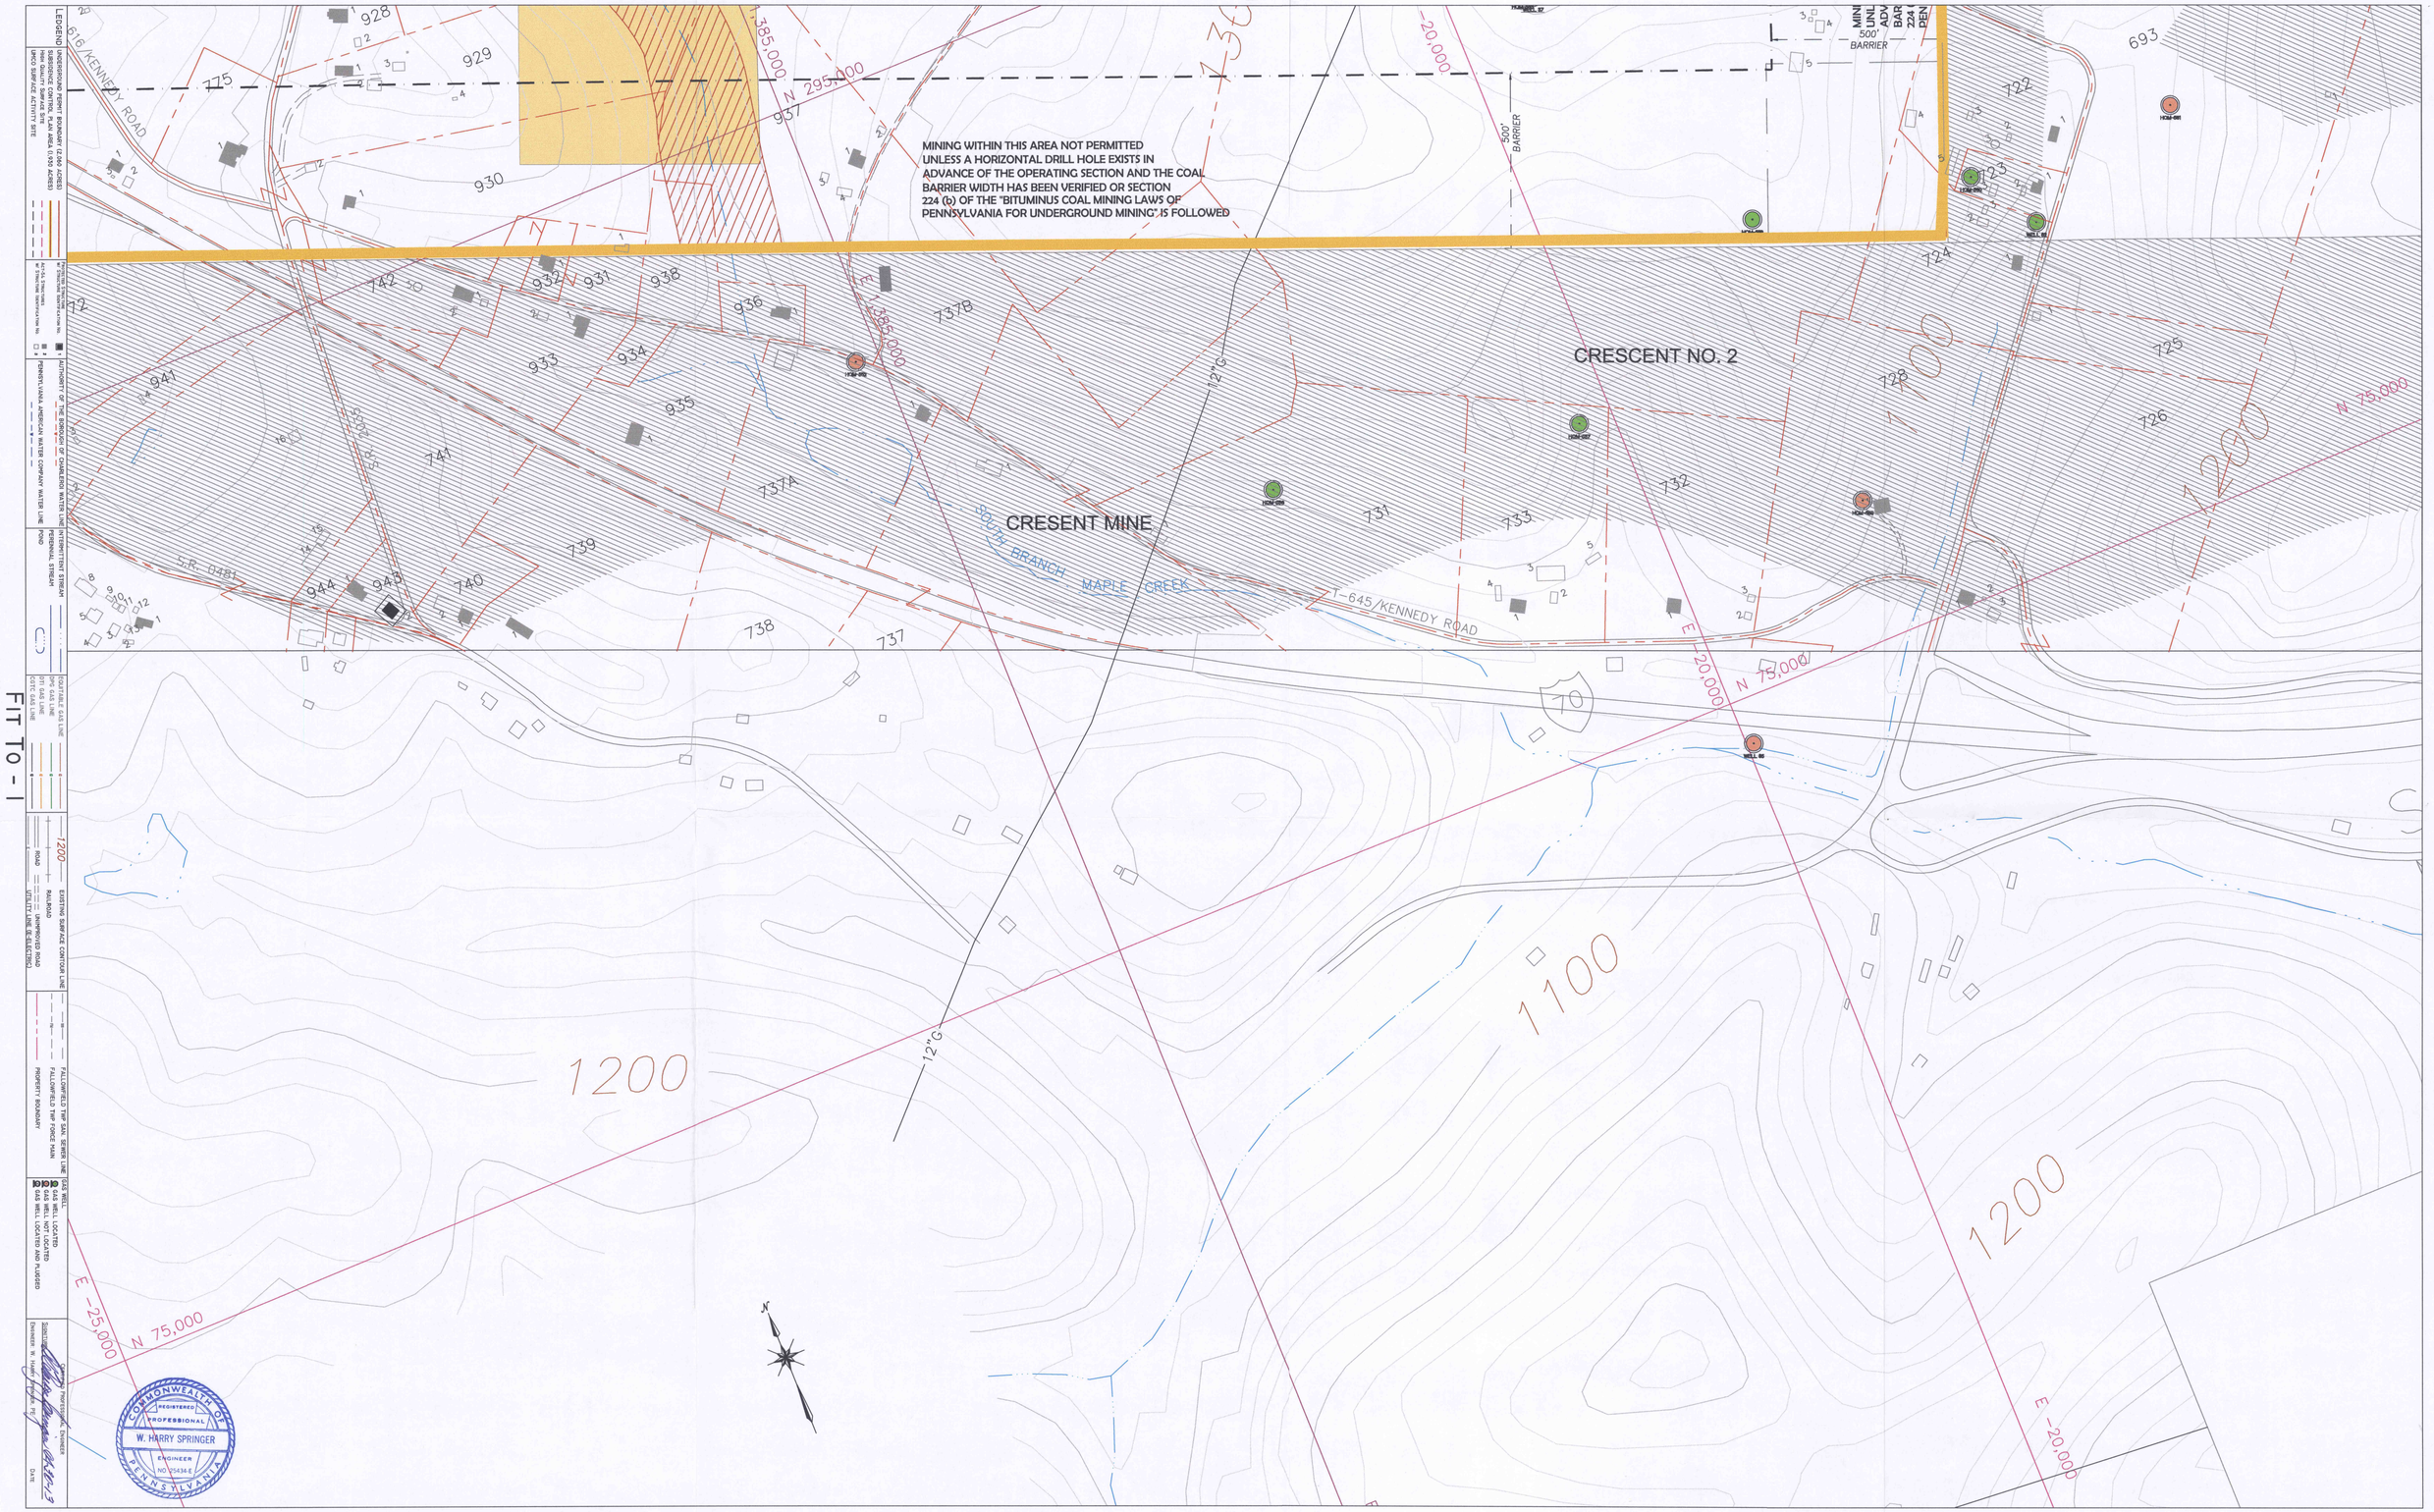

FIT TO - I

MAPLE CREEK MINING, INC. -- UMCO ENERGY, INC.
HIGH QUALITY MINE

FINAL MINE MAP