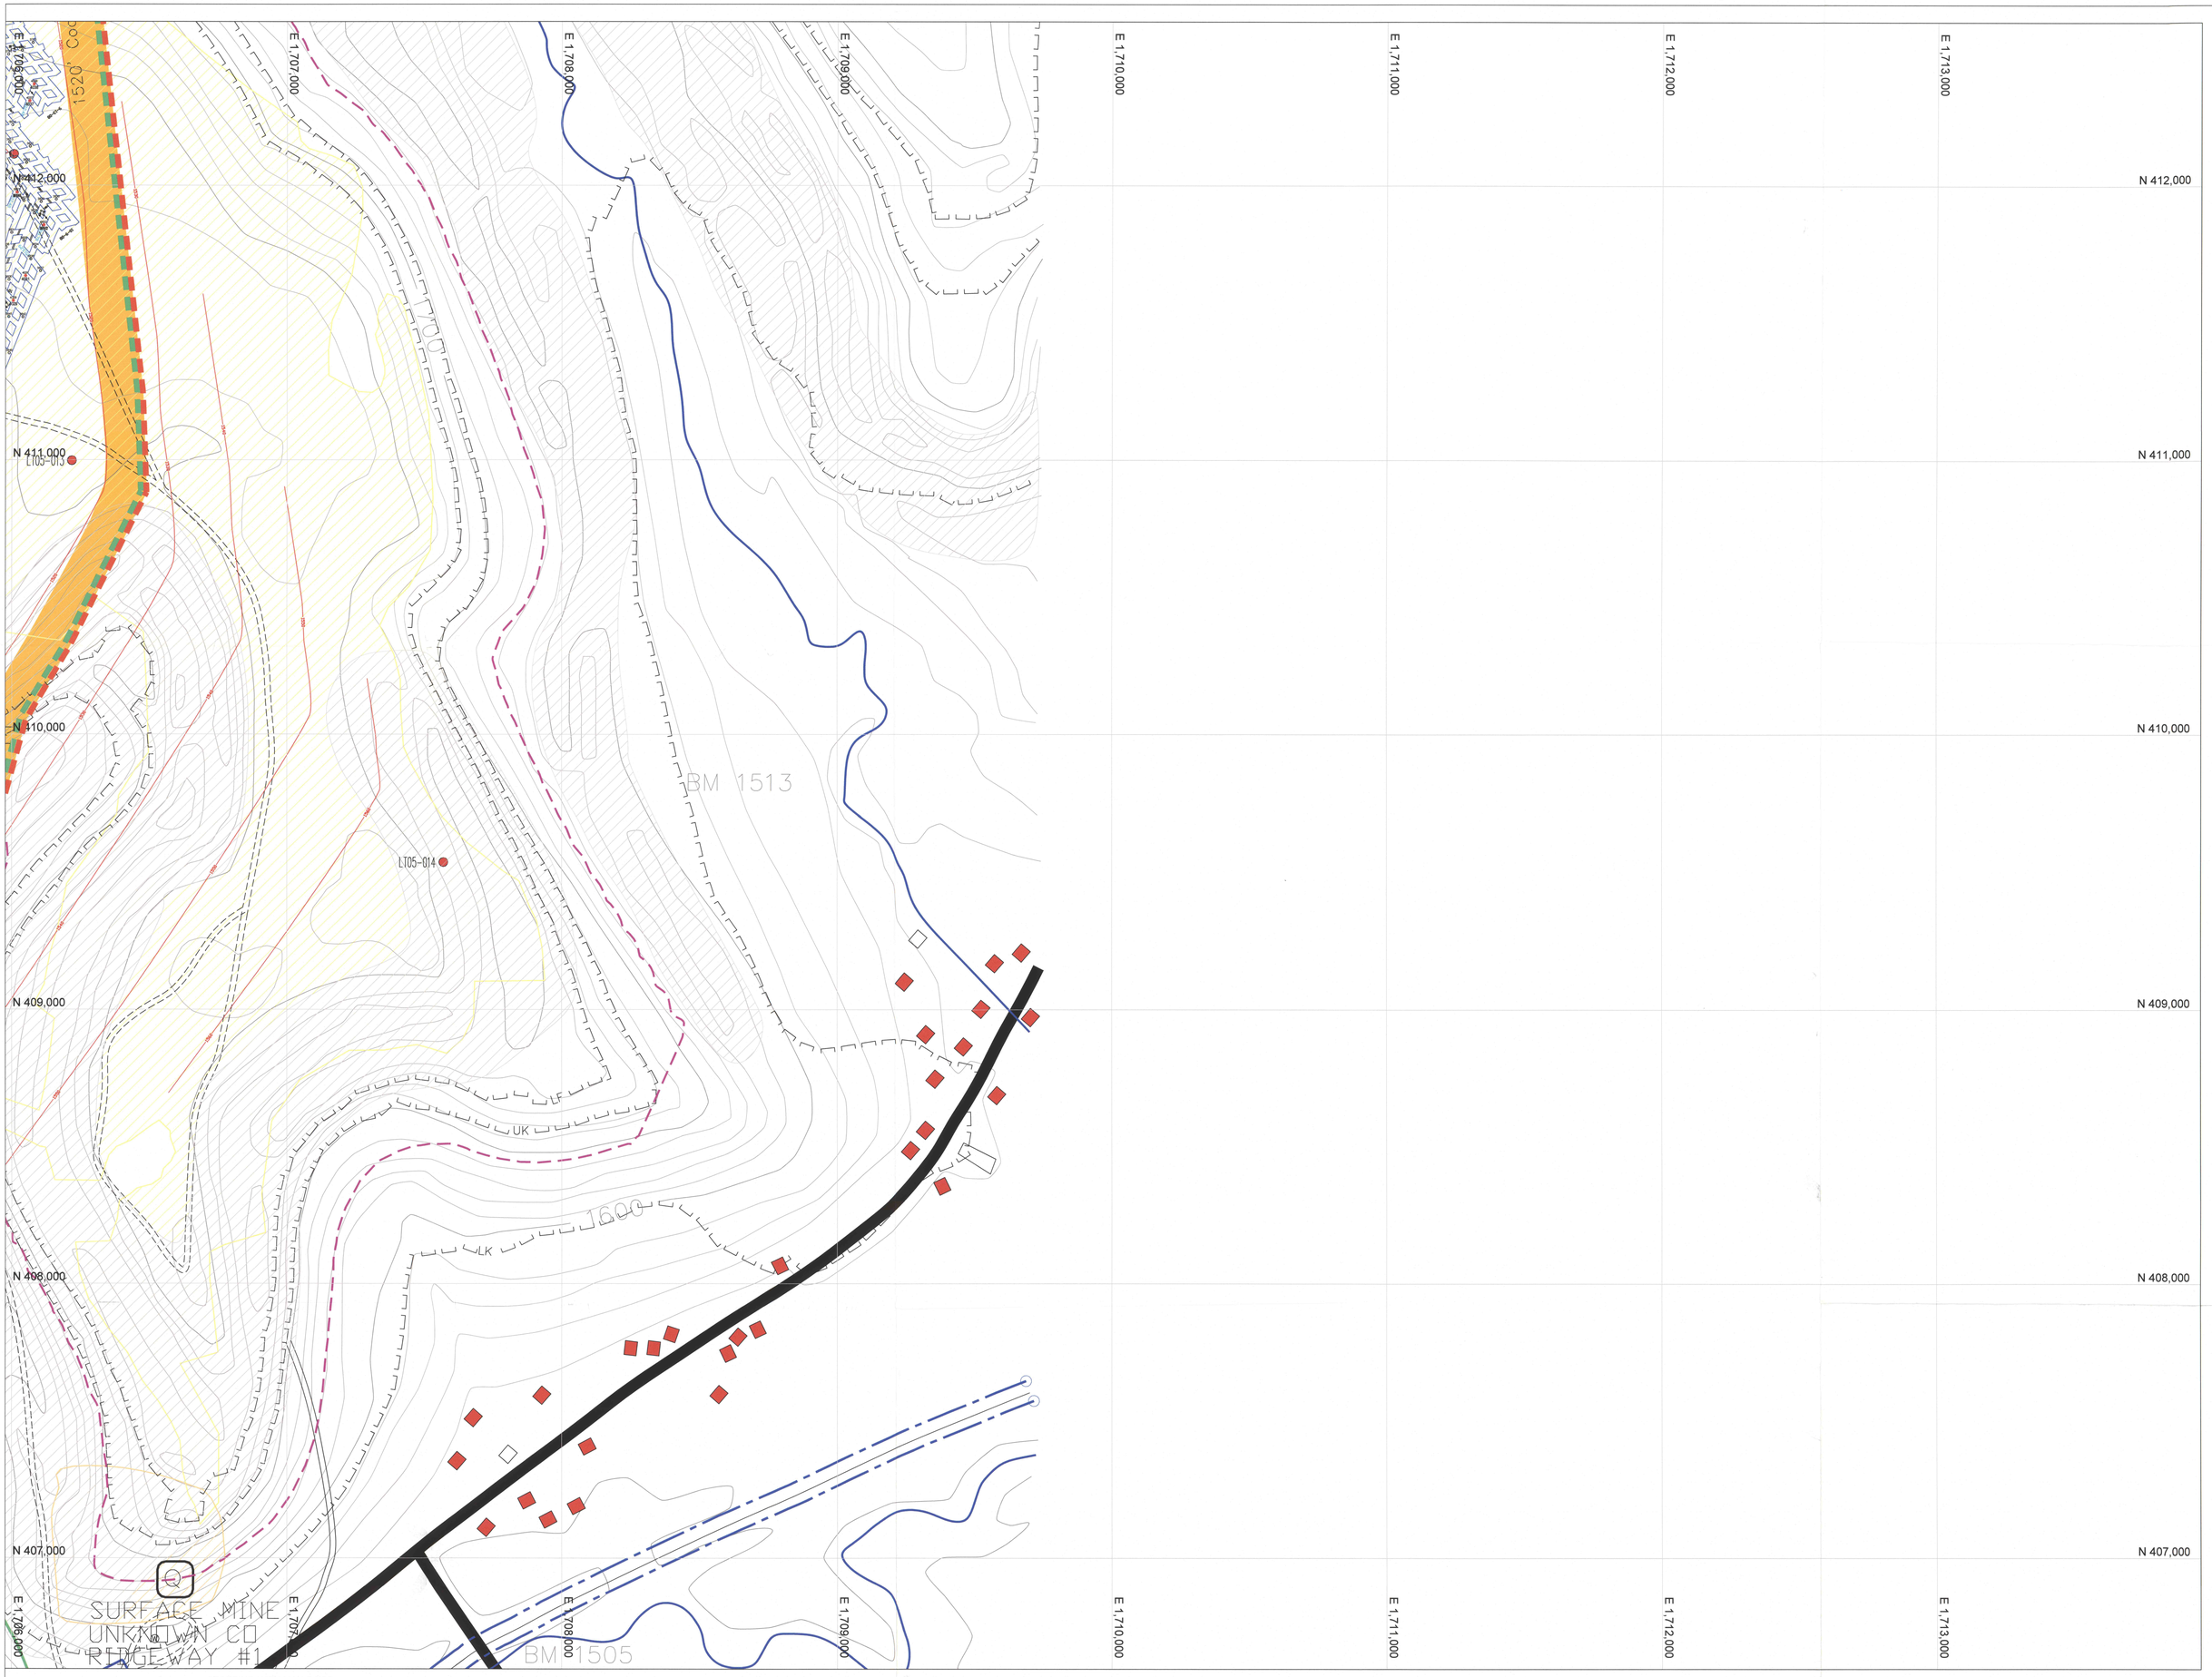

STOPPING WITH MAN DOOR
PERMANENT STOPPING
CHECK CURTAIN
EQUIPMENT DOOR
ROAD
DRILLHOLE
SURFACE CONTOUR
COAL CONTOUR
PROPERTY LINE
GAS WELL
SURVEY POINT

N

PERMIT BOUNDARY
SUBSIDENCE CONTROL PLAN BOUNDARY
100 FT. COVER LINE
UK DEEP MINE
LF DEEP MINE
BARRIER AREA

OCCUPIED STRUCTURE (PRIVATE WATER)
OCCUPIED STRUCTURE (PUBLIC WATER)
OCCUPIED STRUCTURE (COMMUNITY WATER)
UNOCCUPIED STRUCTURE

PERMIT LIMIT ENERGY RESOURCES INC.
PERMIT LIMIT ENERGY RESOURCES INC.

MINES IN THE SAME SEAM, OVERLYING SEAMS AND UNDERLYING SEAMS WHICH ARE WITHIN 1000 FT. OF EXISTING AND PROJECTED MINING ARE SHOWN ON THIS MAP.

INTERVAL BETWEEN UF & LK SEAMS APPROX 210'

Datum: PA State Plane Coordinate System, North Zone, NAD 83
NAVD88

I certify that to the best of my knowledge that this final map of the Little Toby Mine is an accurate representation of the limits and workings of the Little Toby Mine and is indeed the true "FINAL MAP".

COMMONWEALTH OF PENNSYLVANIA
REGISTERED PROFESSIONAL
THEODORE J. BEARER, JR.
LAND SURVEYOR
No. 048306

12/7/12
Theodore J. Bearer, Jr., PLS — Date

I certify that to the best of my knowledge that this final map of the Little Toby Mine is an accurate representation of the limits and workings of the Little Toby Mine and is indeed the true "FINAL MAP".

COMMONWEALTH OF PENNSYLVANIA
REGISTERED PROFESSIONAL
DENNIS E. GRELLE
ENGINEER
NO. 27319-E

12/7/12
Dennis E. Grelle, PE Manager of Engineering — Date

SHEET INDEX

C D B E A

Rosebud Mining Company

LITTLE TOBY MINE

Final Mine Map

Sheet E

Lower Kittanning Coal Seam

Horton Township,Elk County, PA

ID No. 36 08847 CMAP No. 24991301

Scale: 1 in. = 200 ft.