


- |  |                        |  |                                   |  |                                      |
|--|------------------------|--|-----------------------------------|--|--------------------------------------|
|  | STOPPING WITH MAN DOOR |  | PERMIT BOUNDARY                   |  | PERMIT LIMIT ENERGY RESOURCES INC.   |
|  | PERMANENT STOPPING     |  | SUBSIDENCE CONTROL PLAN BOUNDARY  |  | 100 FT. COVER LINE                   |
|  | CHECK CURTAIN          |  | UK DEEP MINE                      |  | LF DEEP MINE                         |
|  | EQUIPMENT DOOR         |  | BARRIER AREA                      |  | OCCUPIED STRUCTURE (PRIVATE WATER)   |
|  | ROAD                   |  | OCCUPIED STRUCTURE (PUBLIC WATER) |  | OCCUPIED STRUCTURE (COMMUNITY WATER) |
|  | DRILLHOLE              |  | UNOCCUPIED STRUCTURE              |  |                                      |
|  | SURFACE CONTOUR        |  |                                   |  |                                      |
|  | COAL CONTOUR           |  |                                   |  |                                      |
|  | PROPERTY LINE          |  |                                   |  |                                      |
|  | GAS WELL               |  |                                   |  |                                      |
|  | SURVEY POINT           |  |                                   |  |                                      |

MINES IN THE SAME SEAM, OVERLYING SEAMS AND UNDERLYING SEAMS WHICH ARE WITHIN 1000 FT. OF EXISTING AND PROJECTED MINING ARE SHOWN ON THIS MAP.  
INTERVAL BETWEEN UF & LK SEAMS APPROX 210'


Datum: PA State Plane Coordinate System, North Zone, NAD 83  
NAVD88

I certify that to the best of my knowledge that this final map of the Little Toby Mine is an accurate representation of the limits and workings of the Little Toby Mine and is indeed the true "FINAL MAP".

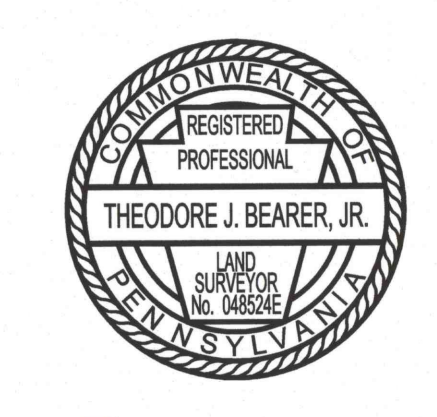


*Theodore J. Bearer, Jr.*  
Theodore J. Bearer, Jr., PLS Date 12/7/12

I certify that to the best of my knowledge that this final map of the Little Toby Mine is an accurate representation of the limits and workings of the Little Toby Mine and is indeed the true "FINAL MAP".

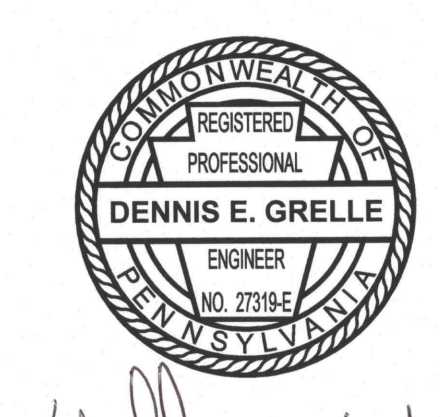

*Dennis E. Grelle*  
Dennis E. Grelle, PE Manager of Engineering Date 12/7/12

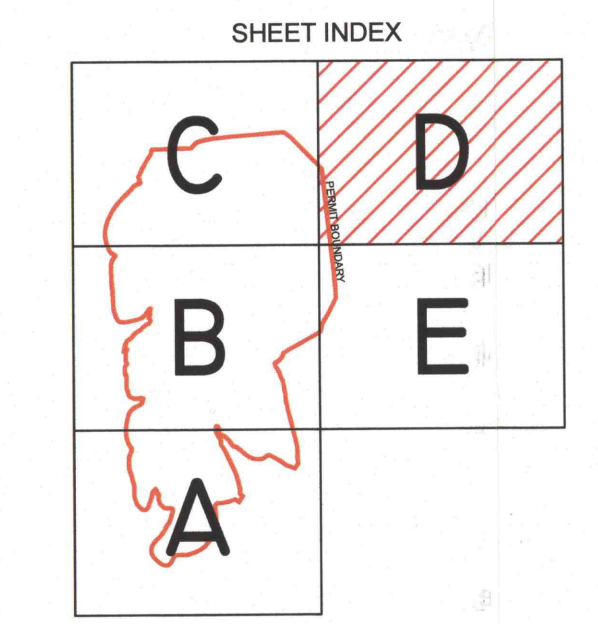

**Rosebud Mining Company**  
**LITTLE TOBY MINE**  
Final Mine Map  
Sheet D  
Lower Kittanning Coal Seam  
Horton Township, Elk County, PA  
ID No. 36 08847 CMAP No. 24991301  
Scale: 1 in. = 200 ft.