


- | | | |
|---|--|---|
| <ul style="list-style-type: none"> STOPPING WITH MAN DOOR PERMANENT STOPPING CHECK CURTAIN EQUIPMENT DOOR ROAD DRILLHOLE SURFACE CONTOUR COAL CONTOUR PROPERTY LINE GAS WELL SURVEY POINT | <ul style="list-style-type: none"> PERMIT BOUNDARY SUBSIDENCE CONTROL PLAN BOUNDARY 100 FT. COVER LINE UK DEEP MINE LF DEEP MINE BARRIER AREA OCCUPIED STRUCTURE (PRIVATE WATER) OCCUPIED STRUCTURE (PUBLIC WATER) OCCUPIED STRUCTURE (COMMUNITY WATER) UNOCCUPIED STRUCTURE | <ul style="list-style-type: none"> PERMIT LIMIT ENERGY RESOURCES INC. PERMIT LIMIT ENERGY RESOURCES INC. <p>MINES IN THE SAME SEAM, OVERLYING SEAMS AND UNDERLYING SEAMS WHICH ARE WITHIN 1000 FT. OF EXISTING AND PROJECTED MINING ARE SHOWN ON THIS MAP.
INTERVAL BETWEEN UF & LK SEAMS APPROX 210'</p> <p>Datum: PA State Plane Coordinate System, North Zone, NAD 83
NAVD88</p> |
|---|--|---|

I certify that to the best of my knowledge that this final map of the Little Toby Mine is an accurate representation of the limits and workings of the Little Toby Mine and is indeed the true "FINAL MAP".

THEODORE J. BEARER, JR.
PROFESSIONAL ENGINEER
12/7/12
Theodore J. Bearer, Jr., PLS Date

I certify that to the best of my knowledge that this final map of the Little Toby Mine is an accurate representation of the limits and workings of the Little Toby Mine and is indeed the true "FINAL MAP".

DENNIS E. GRELLE
PROFESSIONAL ENGINEER
12/7/12
Dennis E. Grele, PE Manager of Engineering Date

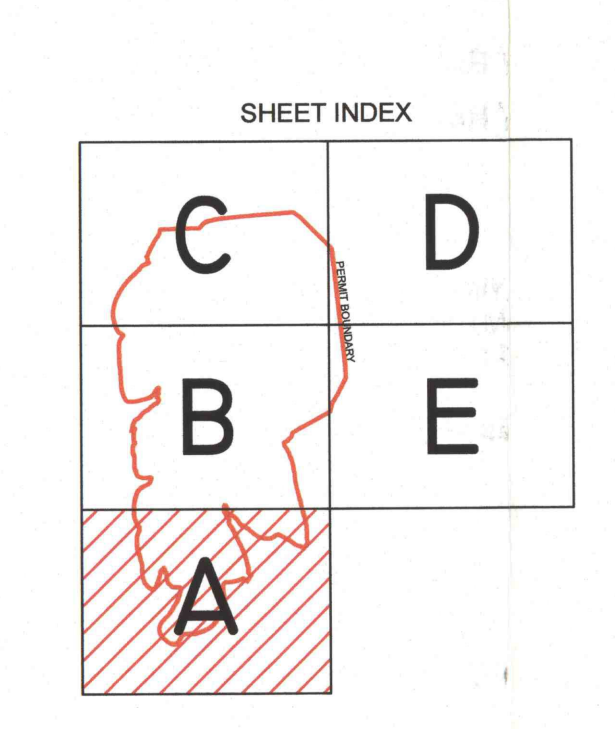

Rosebud Mining Company
LITTLE TOBY MINE
 Final Mine Map
 Sheet A
 Lower Kittanning Coal Seam
 Horton Township, Elk County, PA
 ID No. 36 08847 CMAP No. 24991301
 Scale: 1 in. = 200 ft.