

JAMES E. BURGE  
AREA 363 ACS.

HIRAM HATFIELD  
AREA 217.151 ACS.

AVADA RICE  
AREA 228.785 ACS.


LILLIE M. HOWARD  
AREA 7.773 A.

HENRY M. FORDYCE  
AREA 150.543 ACS.

ANDREW LANTZ  
AREA 968.921 ACS.


SAMUEL LEMLEY  
AREA 211.651 ACS.

Robena No. 3

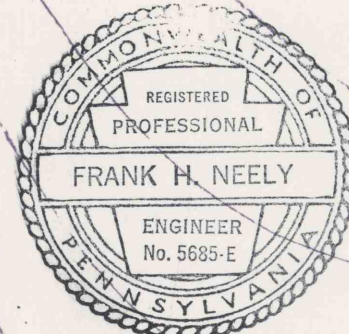

Frank H. Neely  
12-18-79

W.J. Vannelli 2-7-86

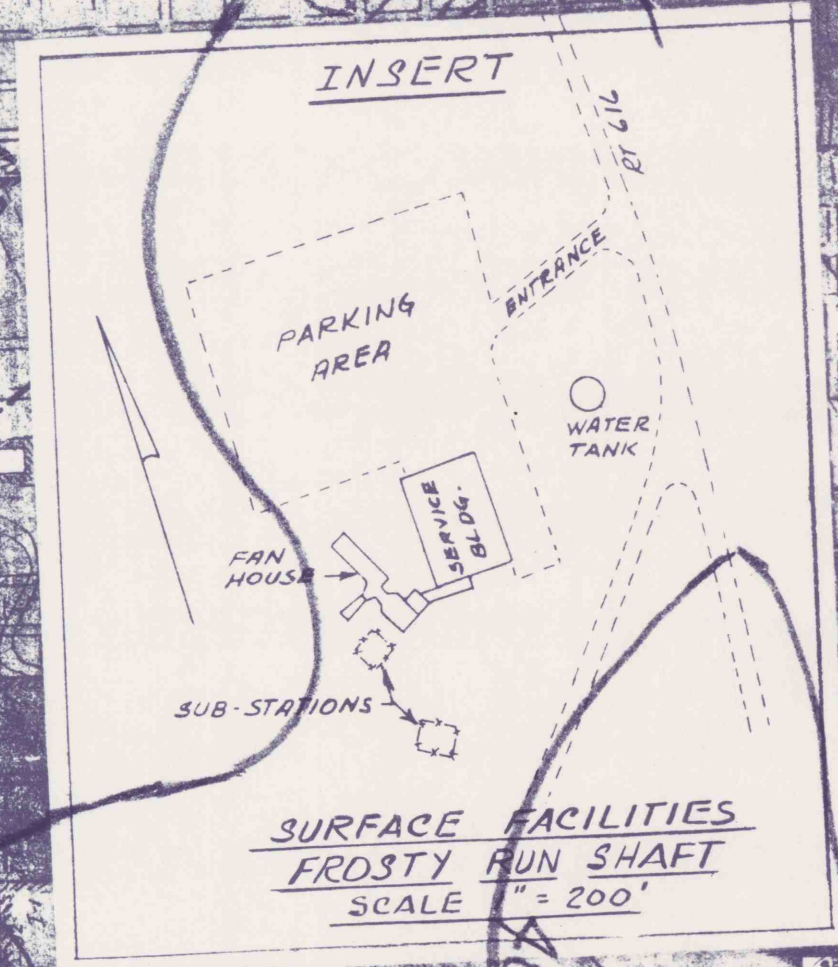

PHASE I  
LEGEND

- INTAKE AIR
- RETURN AIR

FROSTY RUN SHAFT FAN  
Joy H-96 Axialflow - 8 Foot Fan in 22°/22° Blade Position  
Direct Drive with 500 H.P., 2300 V., AC Motors  
Operating @ 87 Amps. and Nominal 900 R.P.M.  
Exhausting - 67,200 C.F.M. @ 5.1" W.G.  
Intake - 22,400 C.F.M.  
Top Coping Elevation - 988.50'  
Bottom Coal Elevation - 486.00'  
Depth - 502.50'  
Entry Height - 7.0' Avg.  
Entry Width - 16.0' Avg.

SAMUEL W. G...  
AREA 19.003 A

INITIAL POINTS  
DUMP Nos 1-11

E. Collins, Mine Inspector  
4/9/79

Old Hight, Director 12-31-79