


BETHENERGY MINES INC.  
BETHLEHEM MINE NO. 58

MON VALLEY STEEL COMPANY, INC.  
supercedes BCNR Mining Corp.,  
Republic Steel Corp., and  
other related owners referred to  
in these maps and documents.

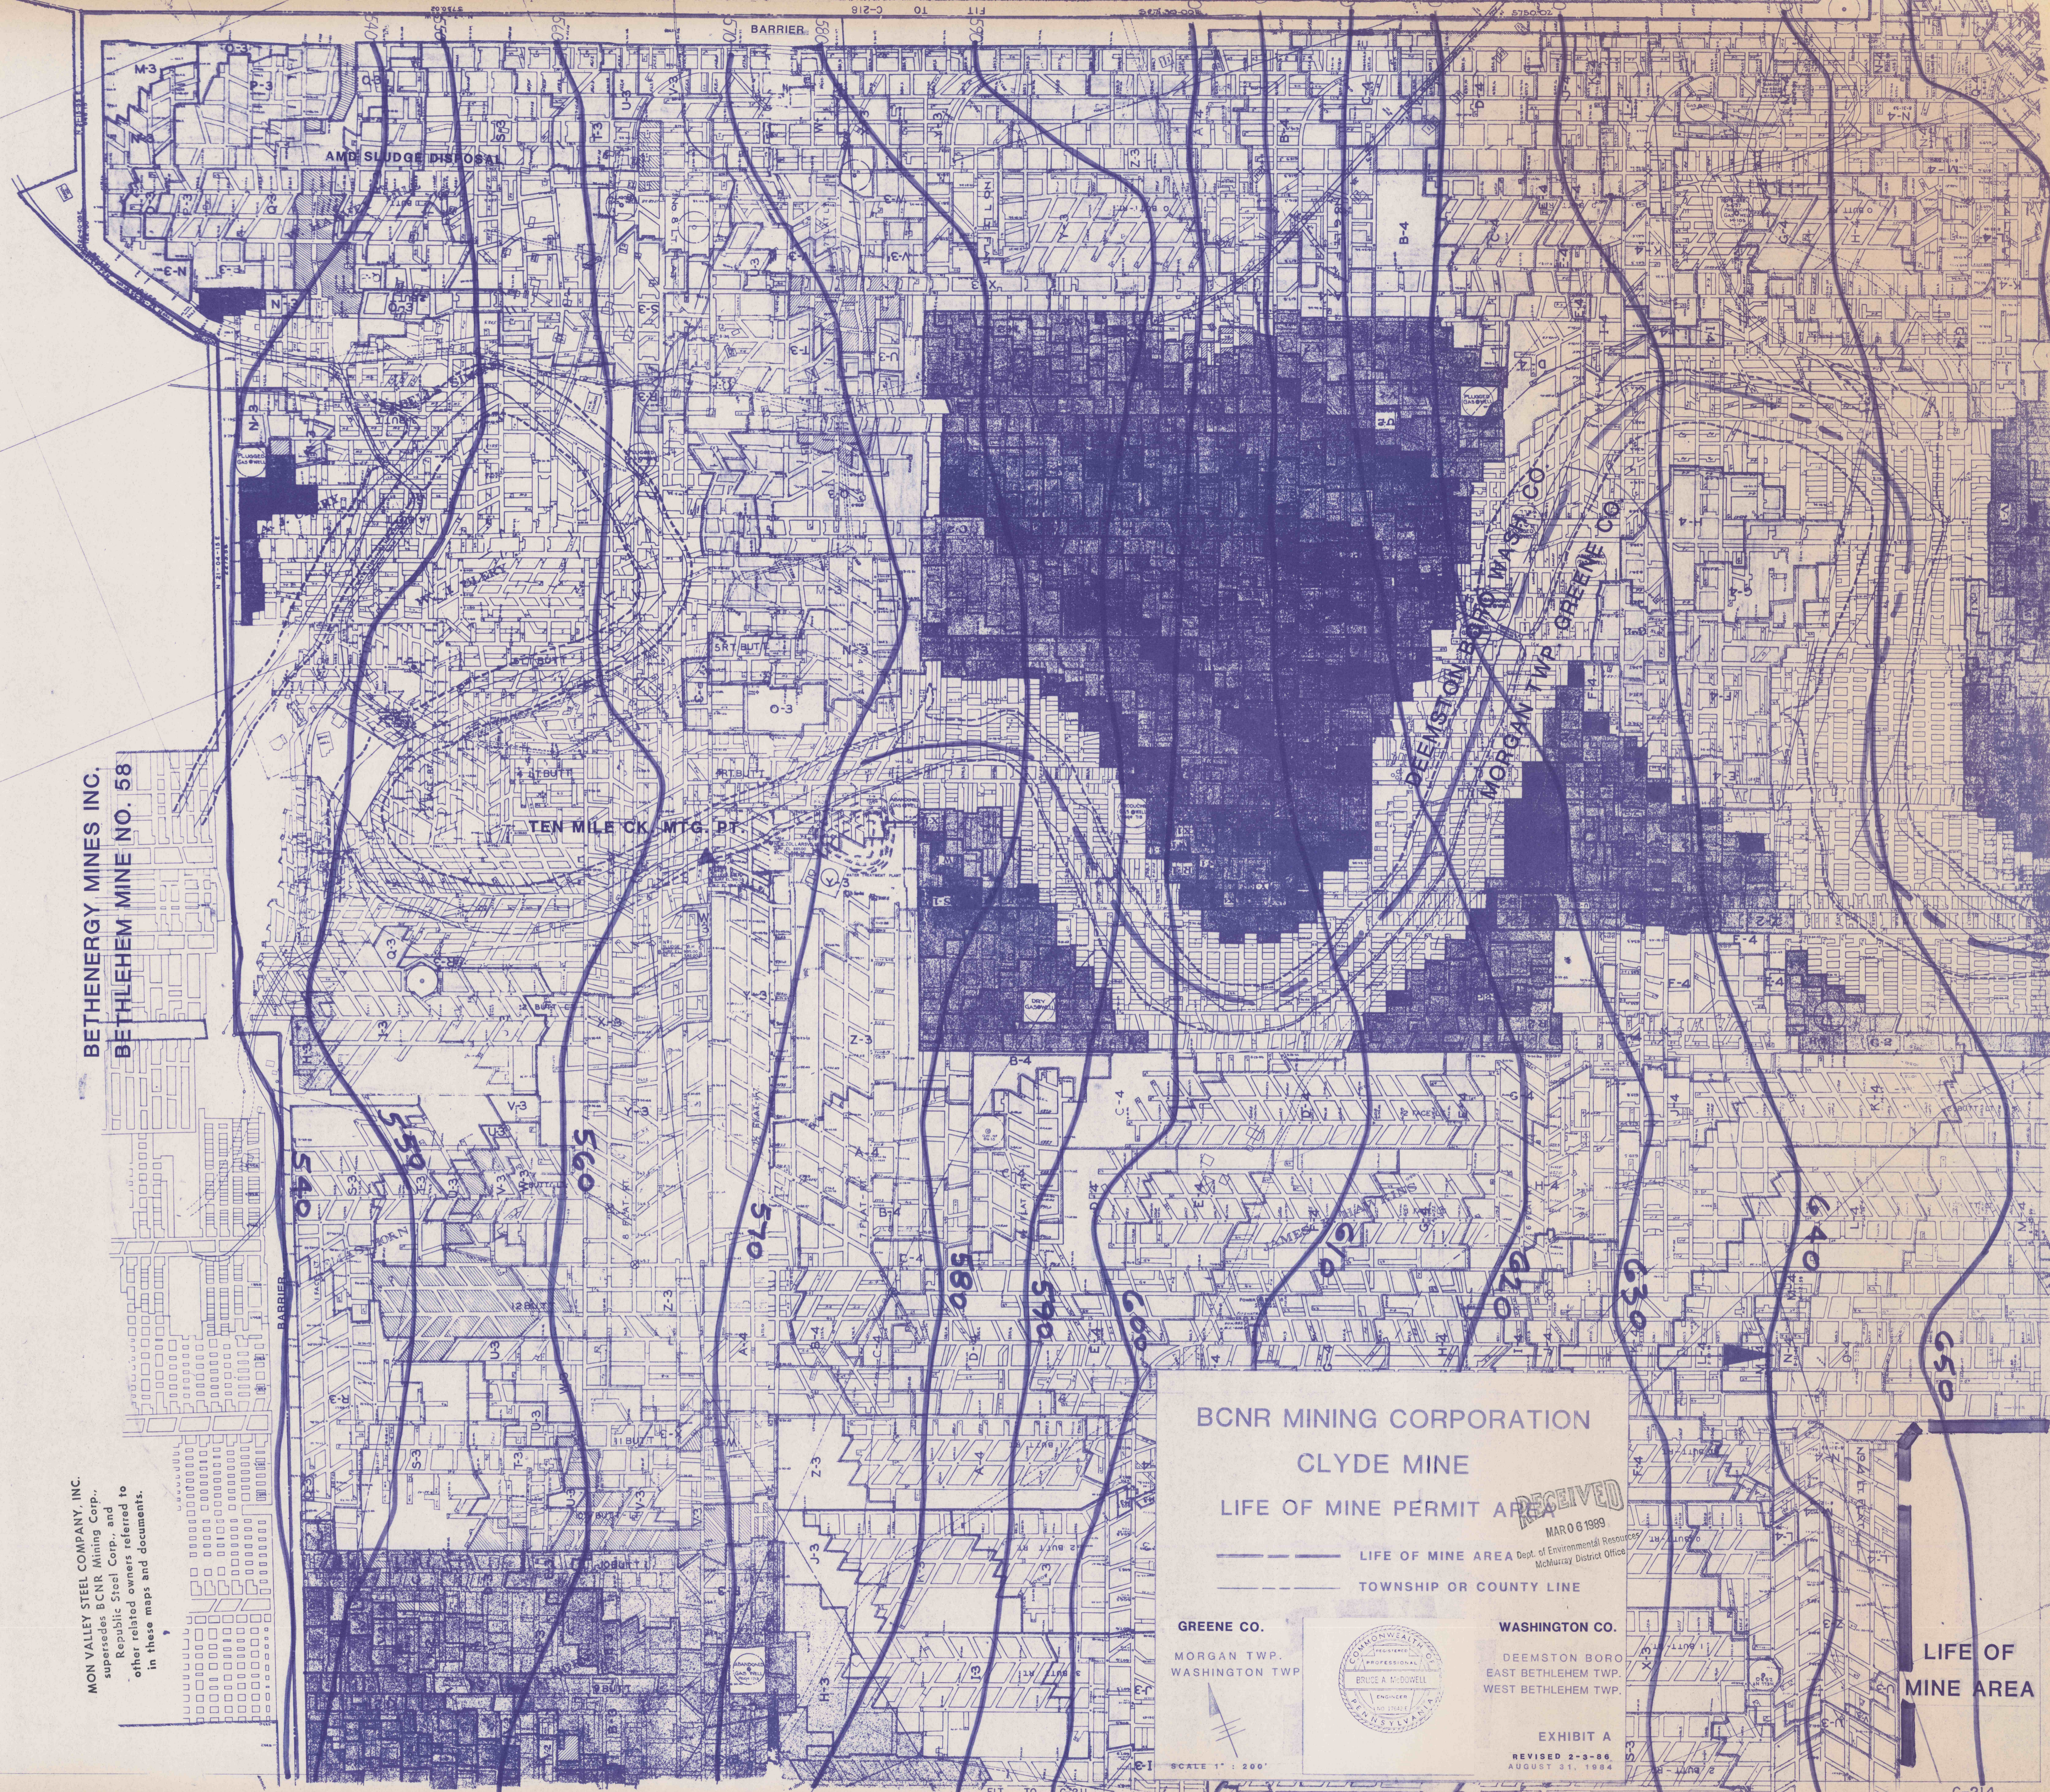

BCNR MINING CORPORATION  
CLYDE MINE  
LIFE OF MINE PERMIT AREA

RECEIVED  
MAR 06 1989  
Dept. of Environmental Resources  
McKurray District Office

--- LIFE OF MINE AREA  
--- TOWNSHIP OR COUNTY LINE

GREENE CO.  
MORGAN TWP.  
WASHINGTON TWP



WASHINGTON CO.  
DEEMSTON BORO  
EAST BETHLEHEM TWP.  
WEST BETHLEHEM TWP.

EXHIBIT A  
REVISED 2-3-86  
AUGUST 31, 1984

SCALE 1" = 200'

LIFE OF MINE AREA