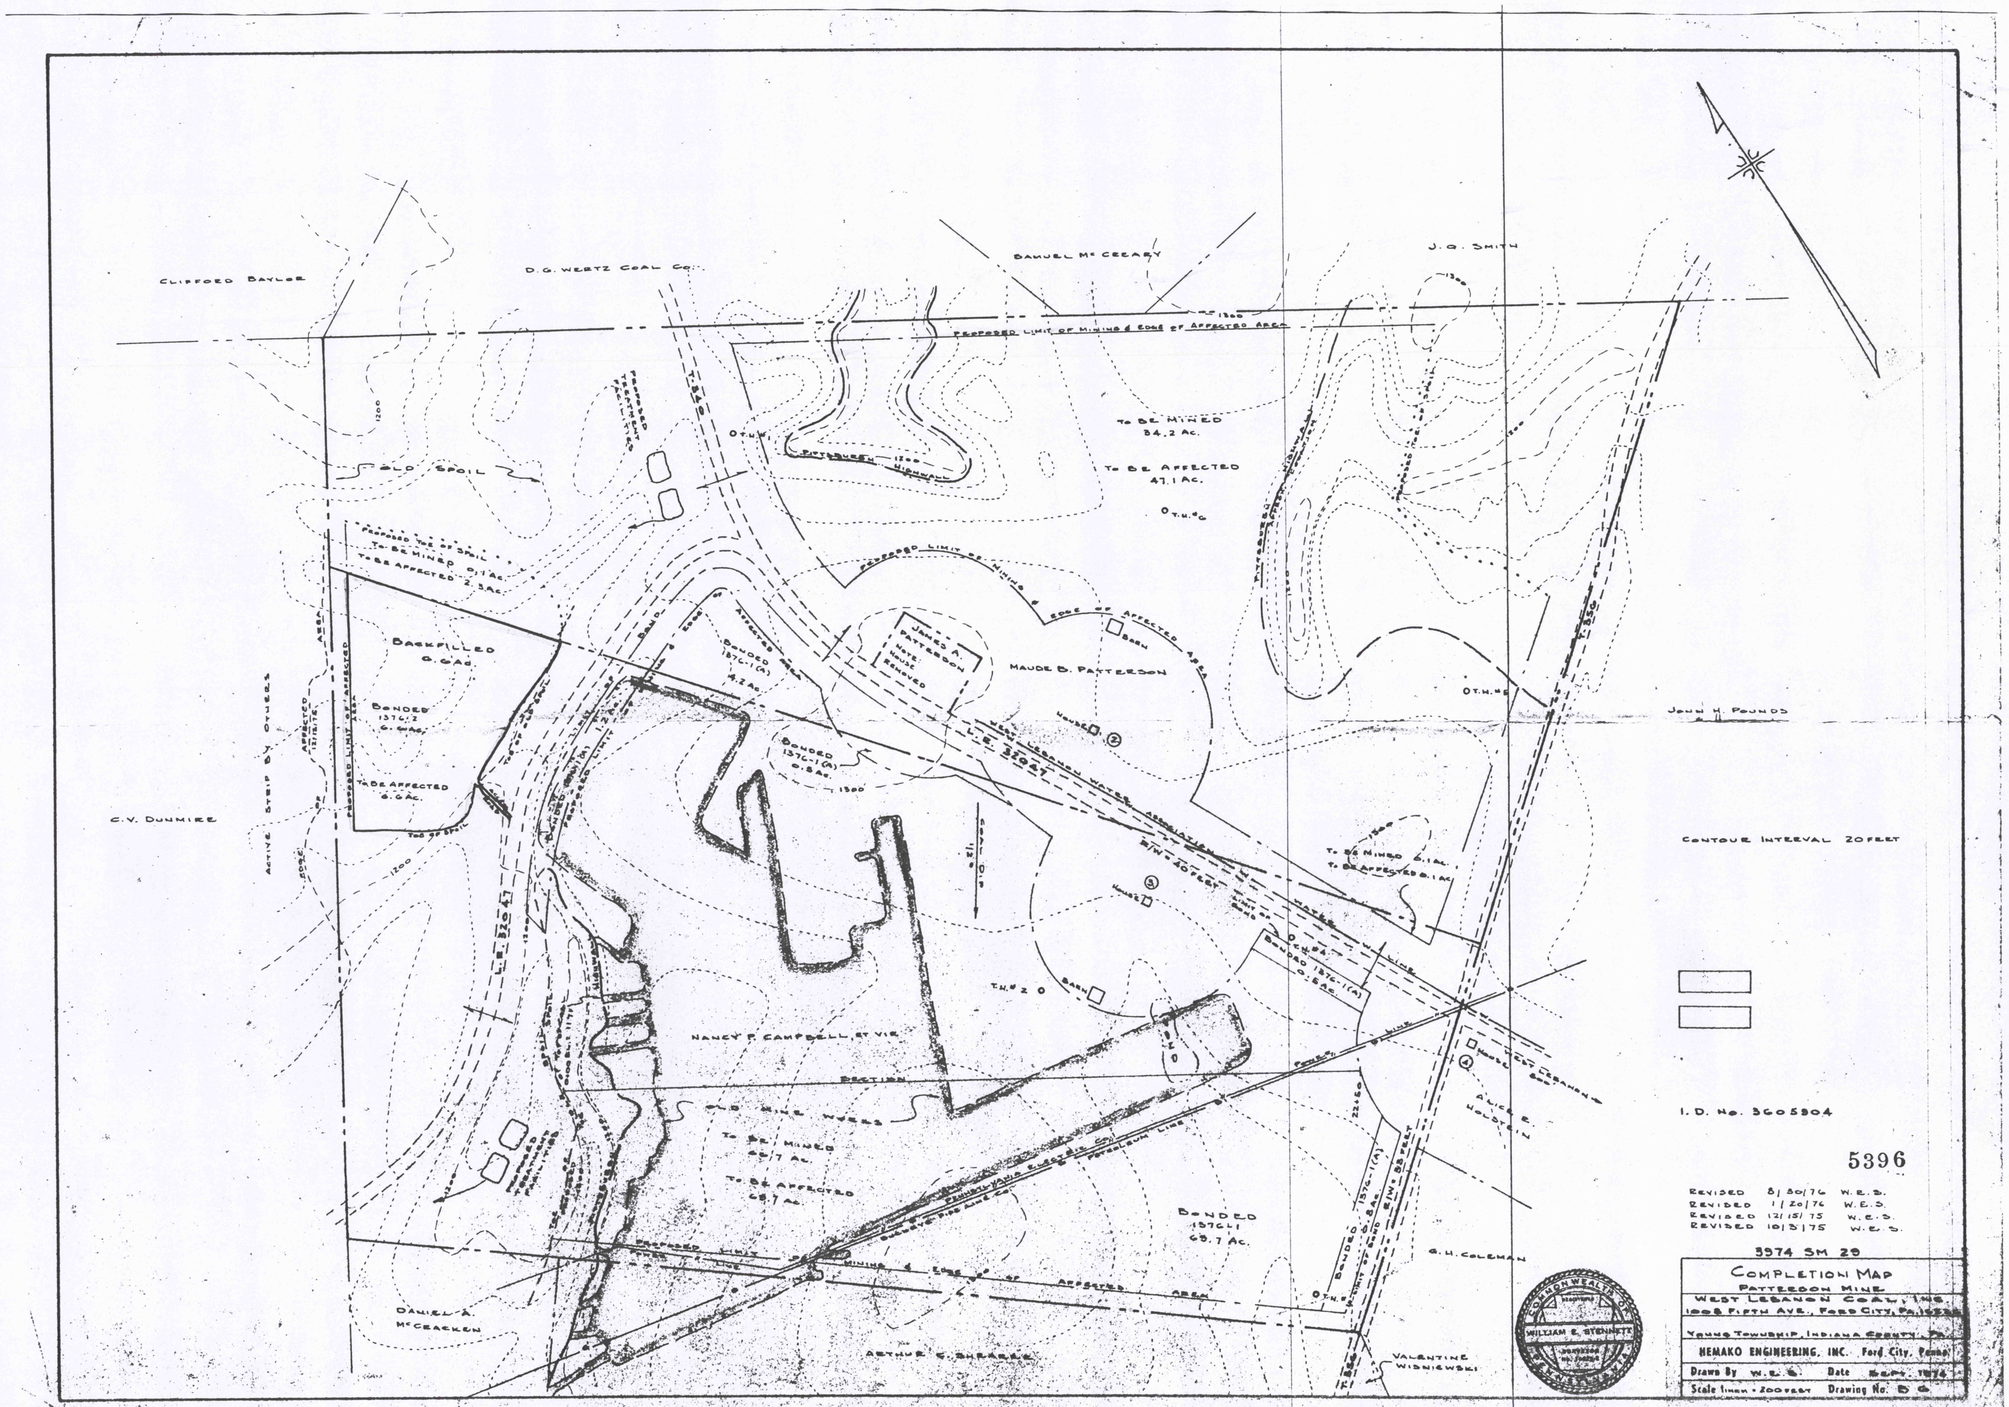
CLIFFORD BAYLOR
D.G. WESTZ COAL Co.
SAMUEL Mc CREARY
J.O. SMITH
PROPOSED LIMIT OF MINING & EDGE OF AFFECTED AREA
OLD SPOIL
PROPOSED TOE OF SPOIL To Be MINED 0.1 Ac. To Be AFFECTED 2.5 Ac.
To Be MINED 84.2 Ac.
To Be AFFECTED 47.1 Ac.
BACKFILLED O.C.Ac.
BONDED 1376-2 O.C.Ac.
TO BE AFFECTED O.C.Ac.
BONDED 1376-1(A) 4.2 Ac.
BONDED 1376-1(A) 0.5 Ac.
JAMES A. PATTERSON
MAUDE D. PATTERSON
BONDED 1376-1 68.7 Ac.
BONDED 1376-1(A) 0.5 Ac.
NANCY P. CAMPBELL, ET VIR
DANIEL A. McCRACKEN
ARTHUR E. SHRADER
G.H. COLEMAN
VALENTINE WIDNIEWSKI
ALICE E. HALDEMAN
JOHN H. POUNDS
C.V. DUNMIRE
ACTIVE STRIP BY OTHERS
PROPOSED TOE OF SPOIL
PROPOSED LIMIT OF AFFECTED AREA
PROPOSED LIMIT OF MINING & EDGE OF AFFECTED AREA
PROPOSED TREATMENT FACILITIES
WEST LEBANON WATER AUTHORITY
EASEMENT
PETROLEUM LINE
O.T.H. #1
