RECEIVED
AUG 2 8 2008
Bureau of Mine Safety
Uniontown

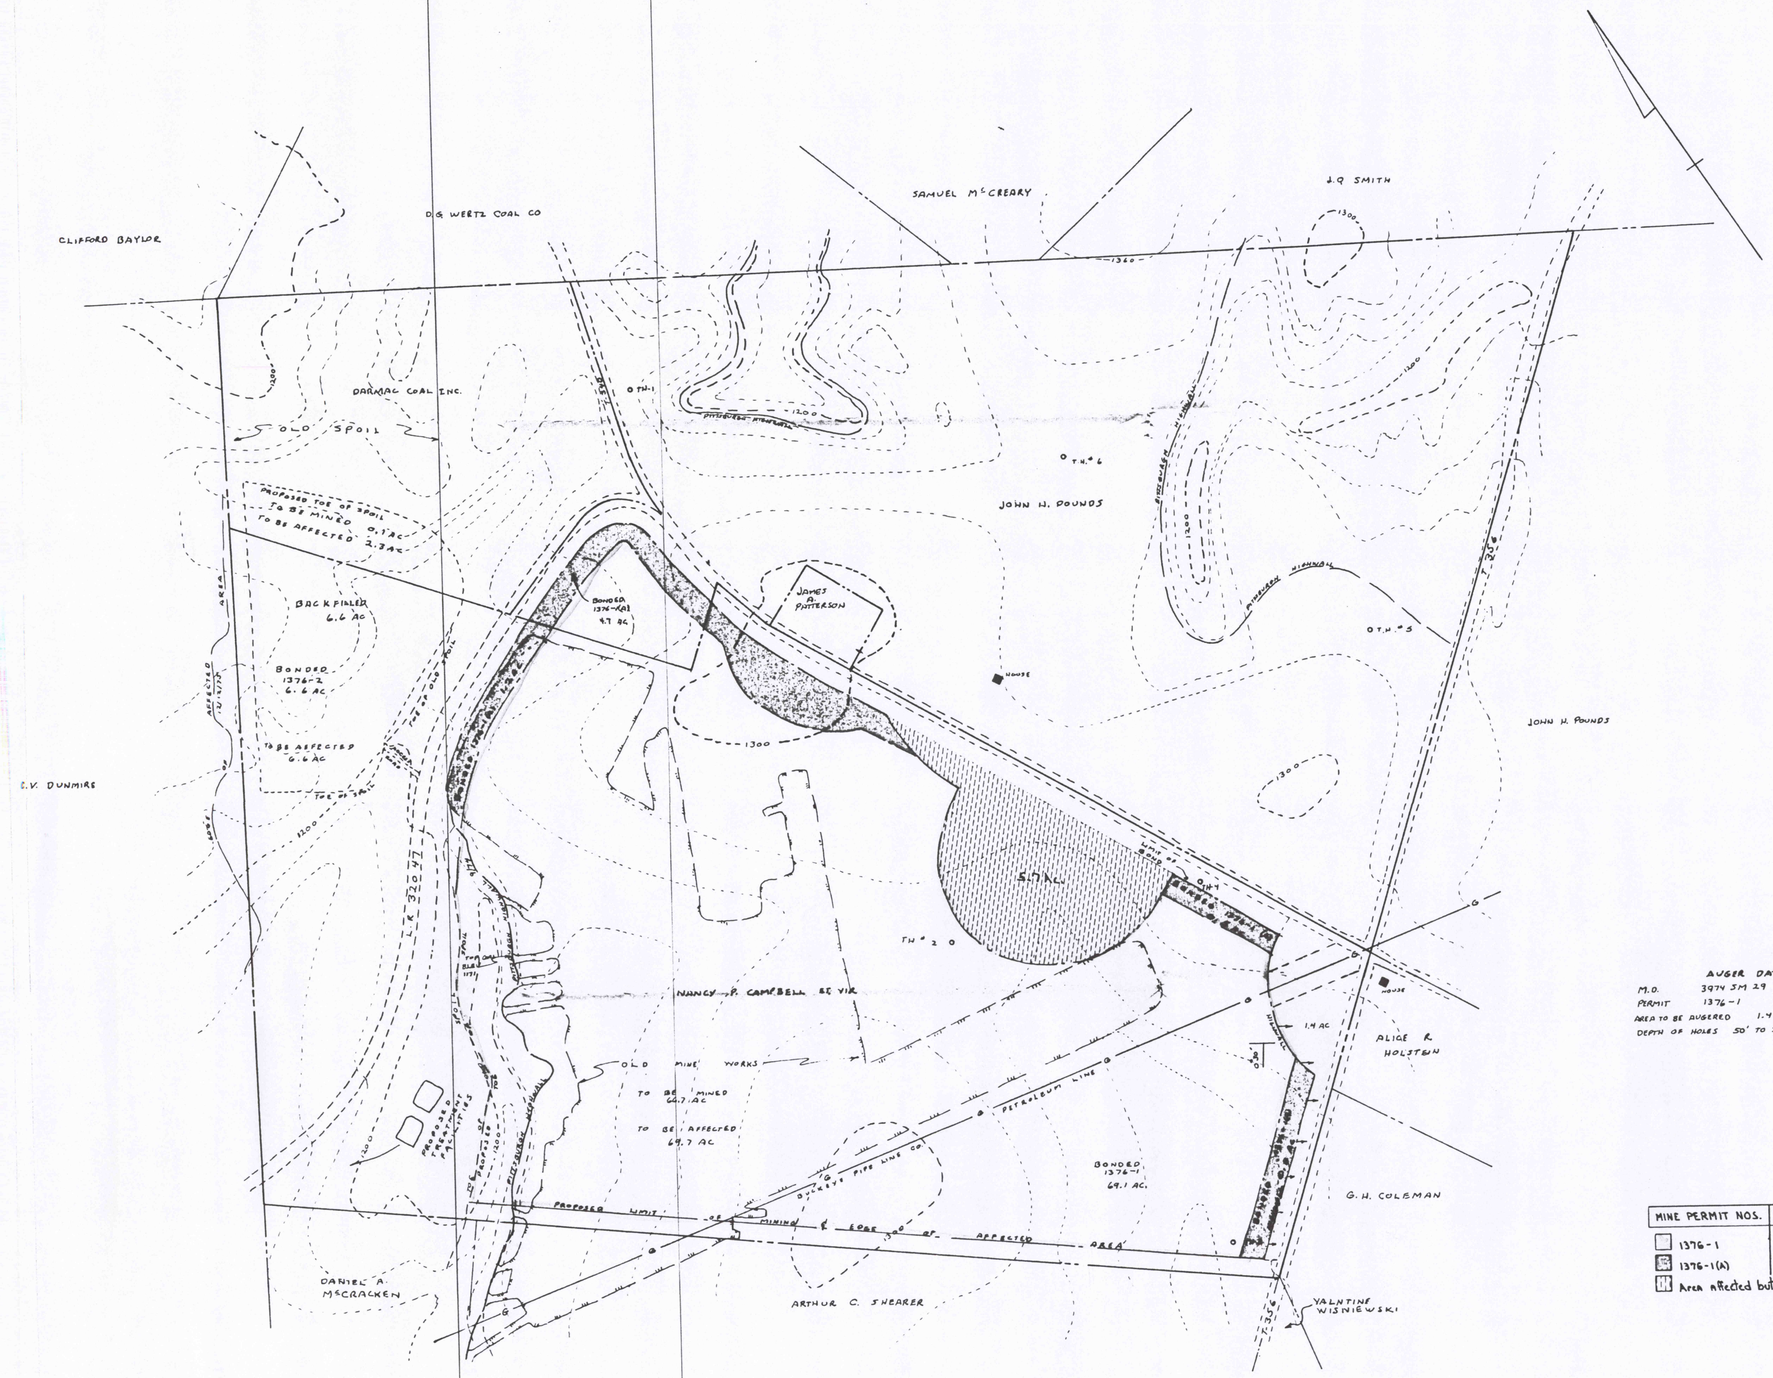

AUGER DATA

M.O. 3974 SM 29
PERMIT 1376-1
AREA TO BE AUGERED 1.4 ACRES
DEPTH OF HOLES 50' TO 250'

AREA checks with M.P. maps for permits 1 and 1A for a total of 76.9 ac.
T.S.C. 3/1/85

MINE PERMIT NOS.	ACRES BONDED	BOND RATE
1376-1	69.7	$1,1500/ac.
1376-1(A)	7.2	$ 500/ac.
Area affected but not bonded		

385024

DER-EP
1985 FEB 22 AM 10:19
SOUTHWESTERN REGION

COMPLETION MAP (STAGE I)

COMMONWEALTH OF PENNSYLVANIA
REGISTERED
WILLIAM D. MOHNEY
SURVEYOR
16237-E

PROJECT	PATTERSON STRIP MINE
FOR	WEST LEBANON COAL, INC.
LOCATION	YOUNG TWP INDIANA CO. PA.
	W.D. MOHNEY R.S. KITTANNING, PA
DRAWN BY WDM	DATE JULY 18, 1984
SCALE 1" = 200'	DRAWING NO. ——