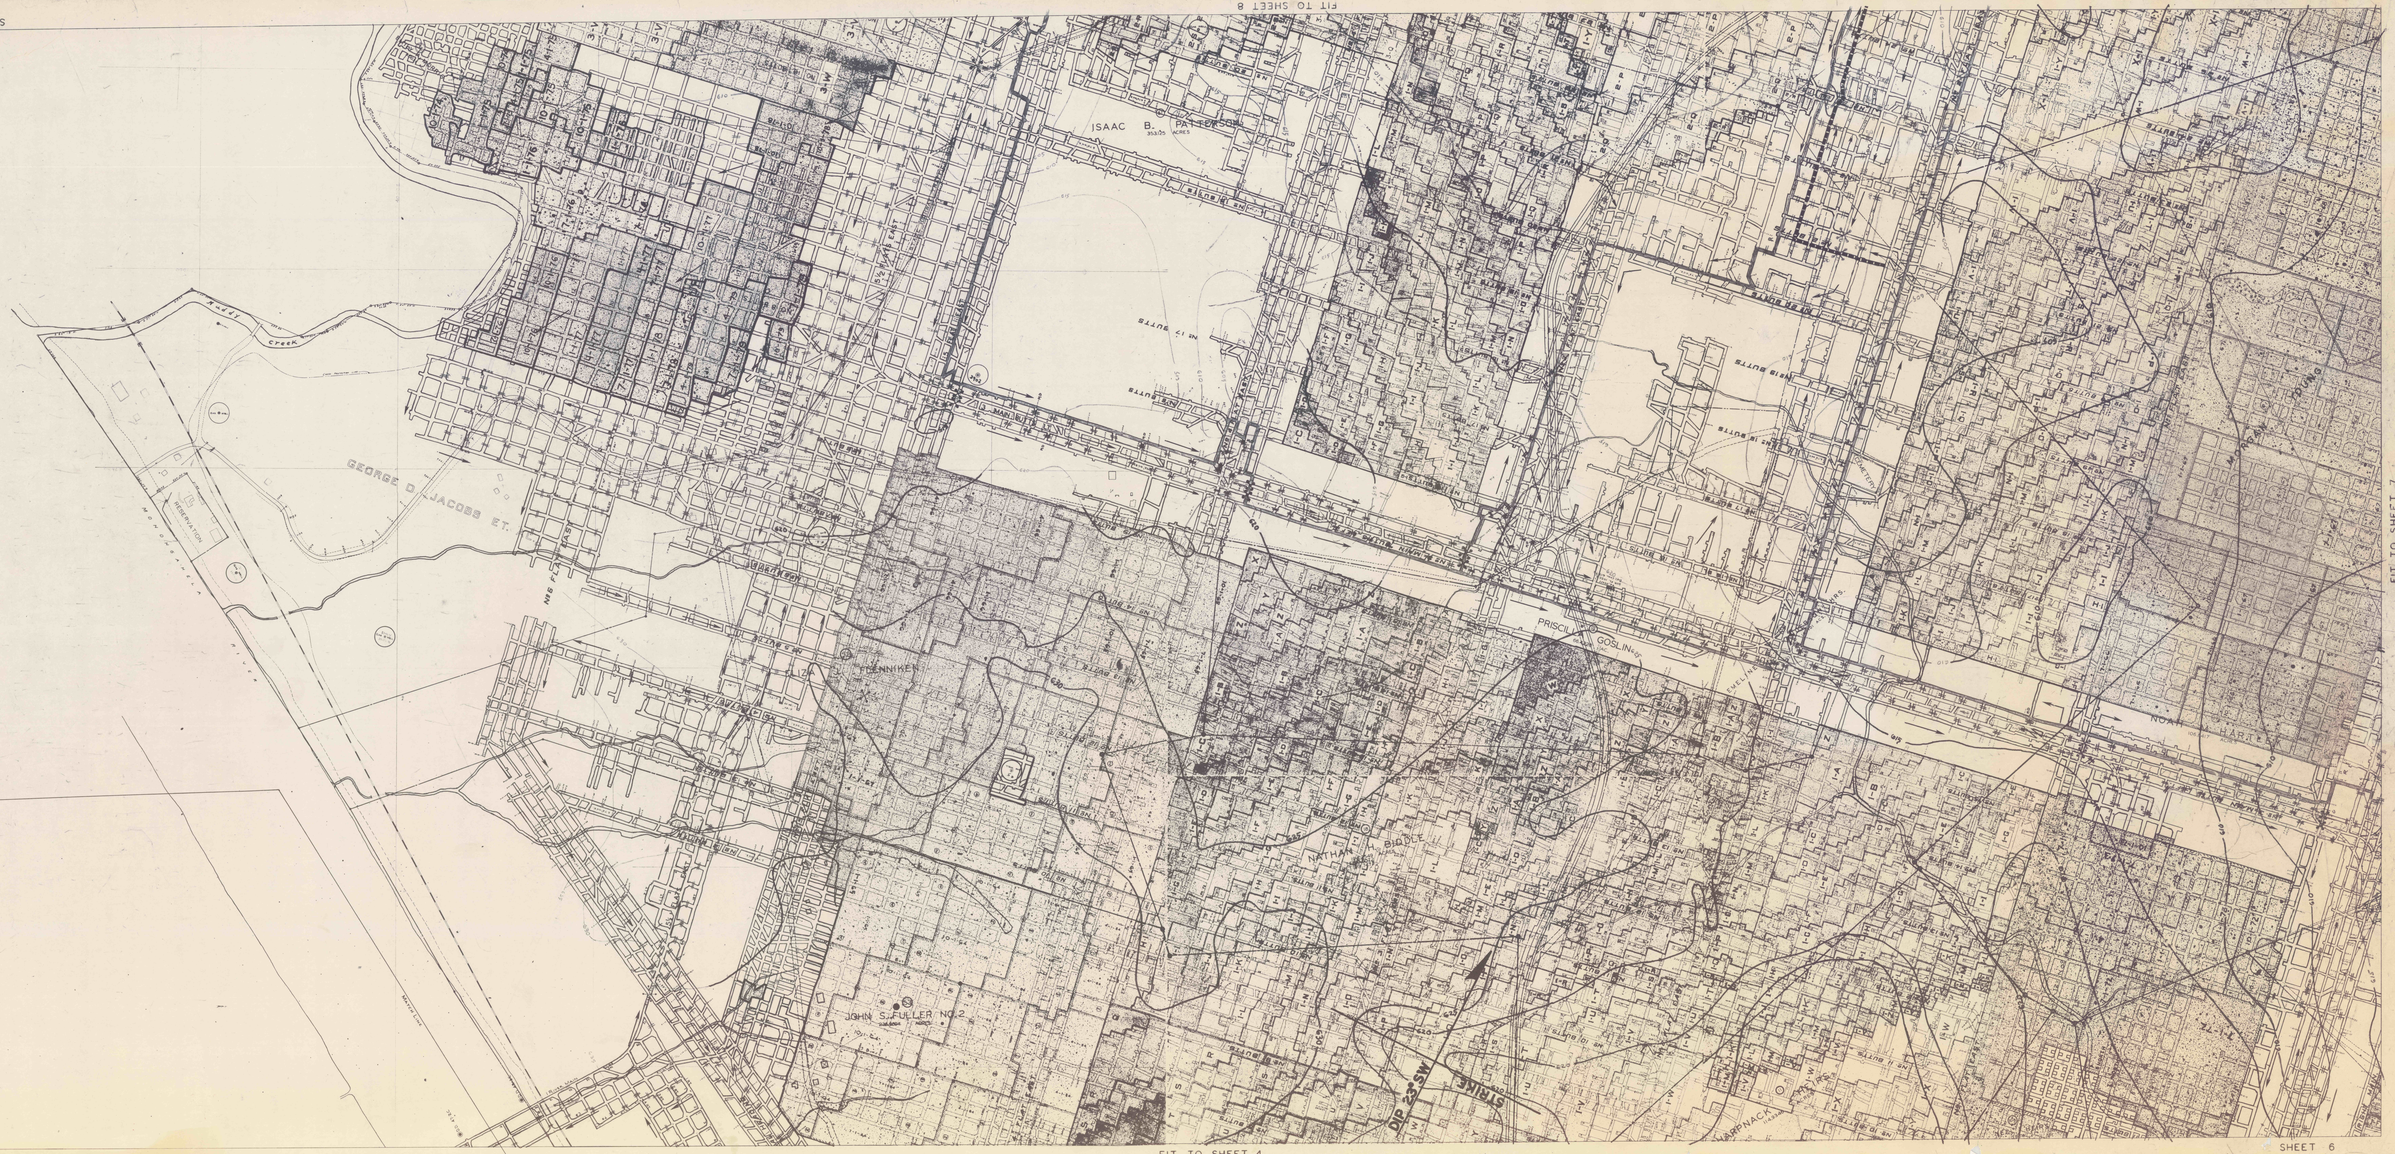
FIT TO SHEET 8
SHEET 6
ISAAC B. PATTERSON
GEORGE D. JACOBS ET.
RESERVATION
PENNIKEN
JOHN S. FULLER NO. 2
PRISCILLA GOSLIN
NOAH HARTSHORNE
NATHAN BIDDLE
STRIKE
DIP 23° SW
MATCH LINE
FIT TO SHEET 4
SHEET 6
FIT TO SHEET 7