


# BUFFALO MINE

**MON VIEW MINING COMPANY**  

CLOSED LOOP SURVEY ACCURACY: 1 IN 10,000

- STOPPING - II
- OVERCAST - X
- MANDOOR - +
- REGULATOR - IR
- SEAL - III
- RETURN AIR -
- INTAKE AIR -
- MINING COMPLETED AREA -
- COAL REMAINING IN PLACE -
- BLEEDER EVALUATION POINT - (B)
- AIR SAMPLING STATION - (AS)
- TRACK HAULAGE -
- TROLLEY HAULAGE VARIANCE AREA (450 fpm max) -
- BELT HAULAGE -
- PRIMARY ESCAPEWAY -
- ALTERNATE ESCAPEWAY (TRACK) -
- AMISCO SENSOR - (AS)
- BILT AIR MEASUREMENT - (AM)
- AIR MEASUREMENT STATION - (AMS)
- PROPOSED SEAL - III

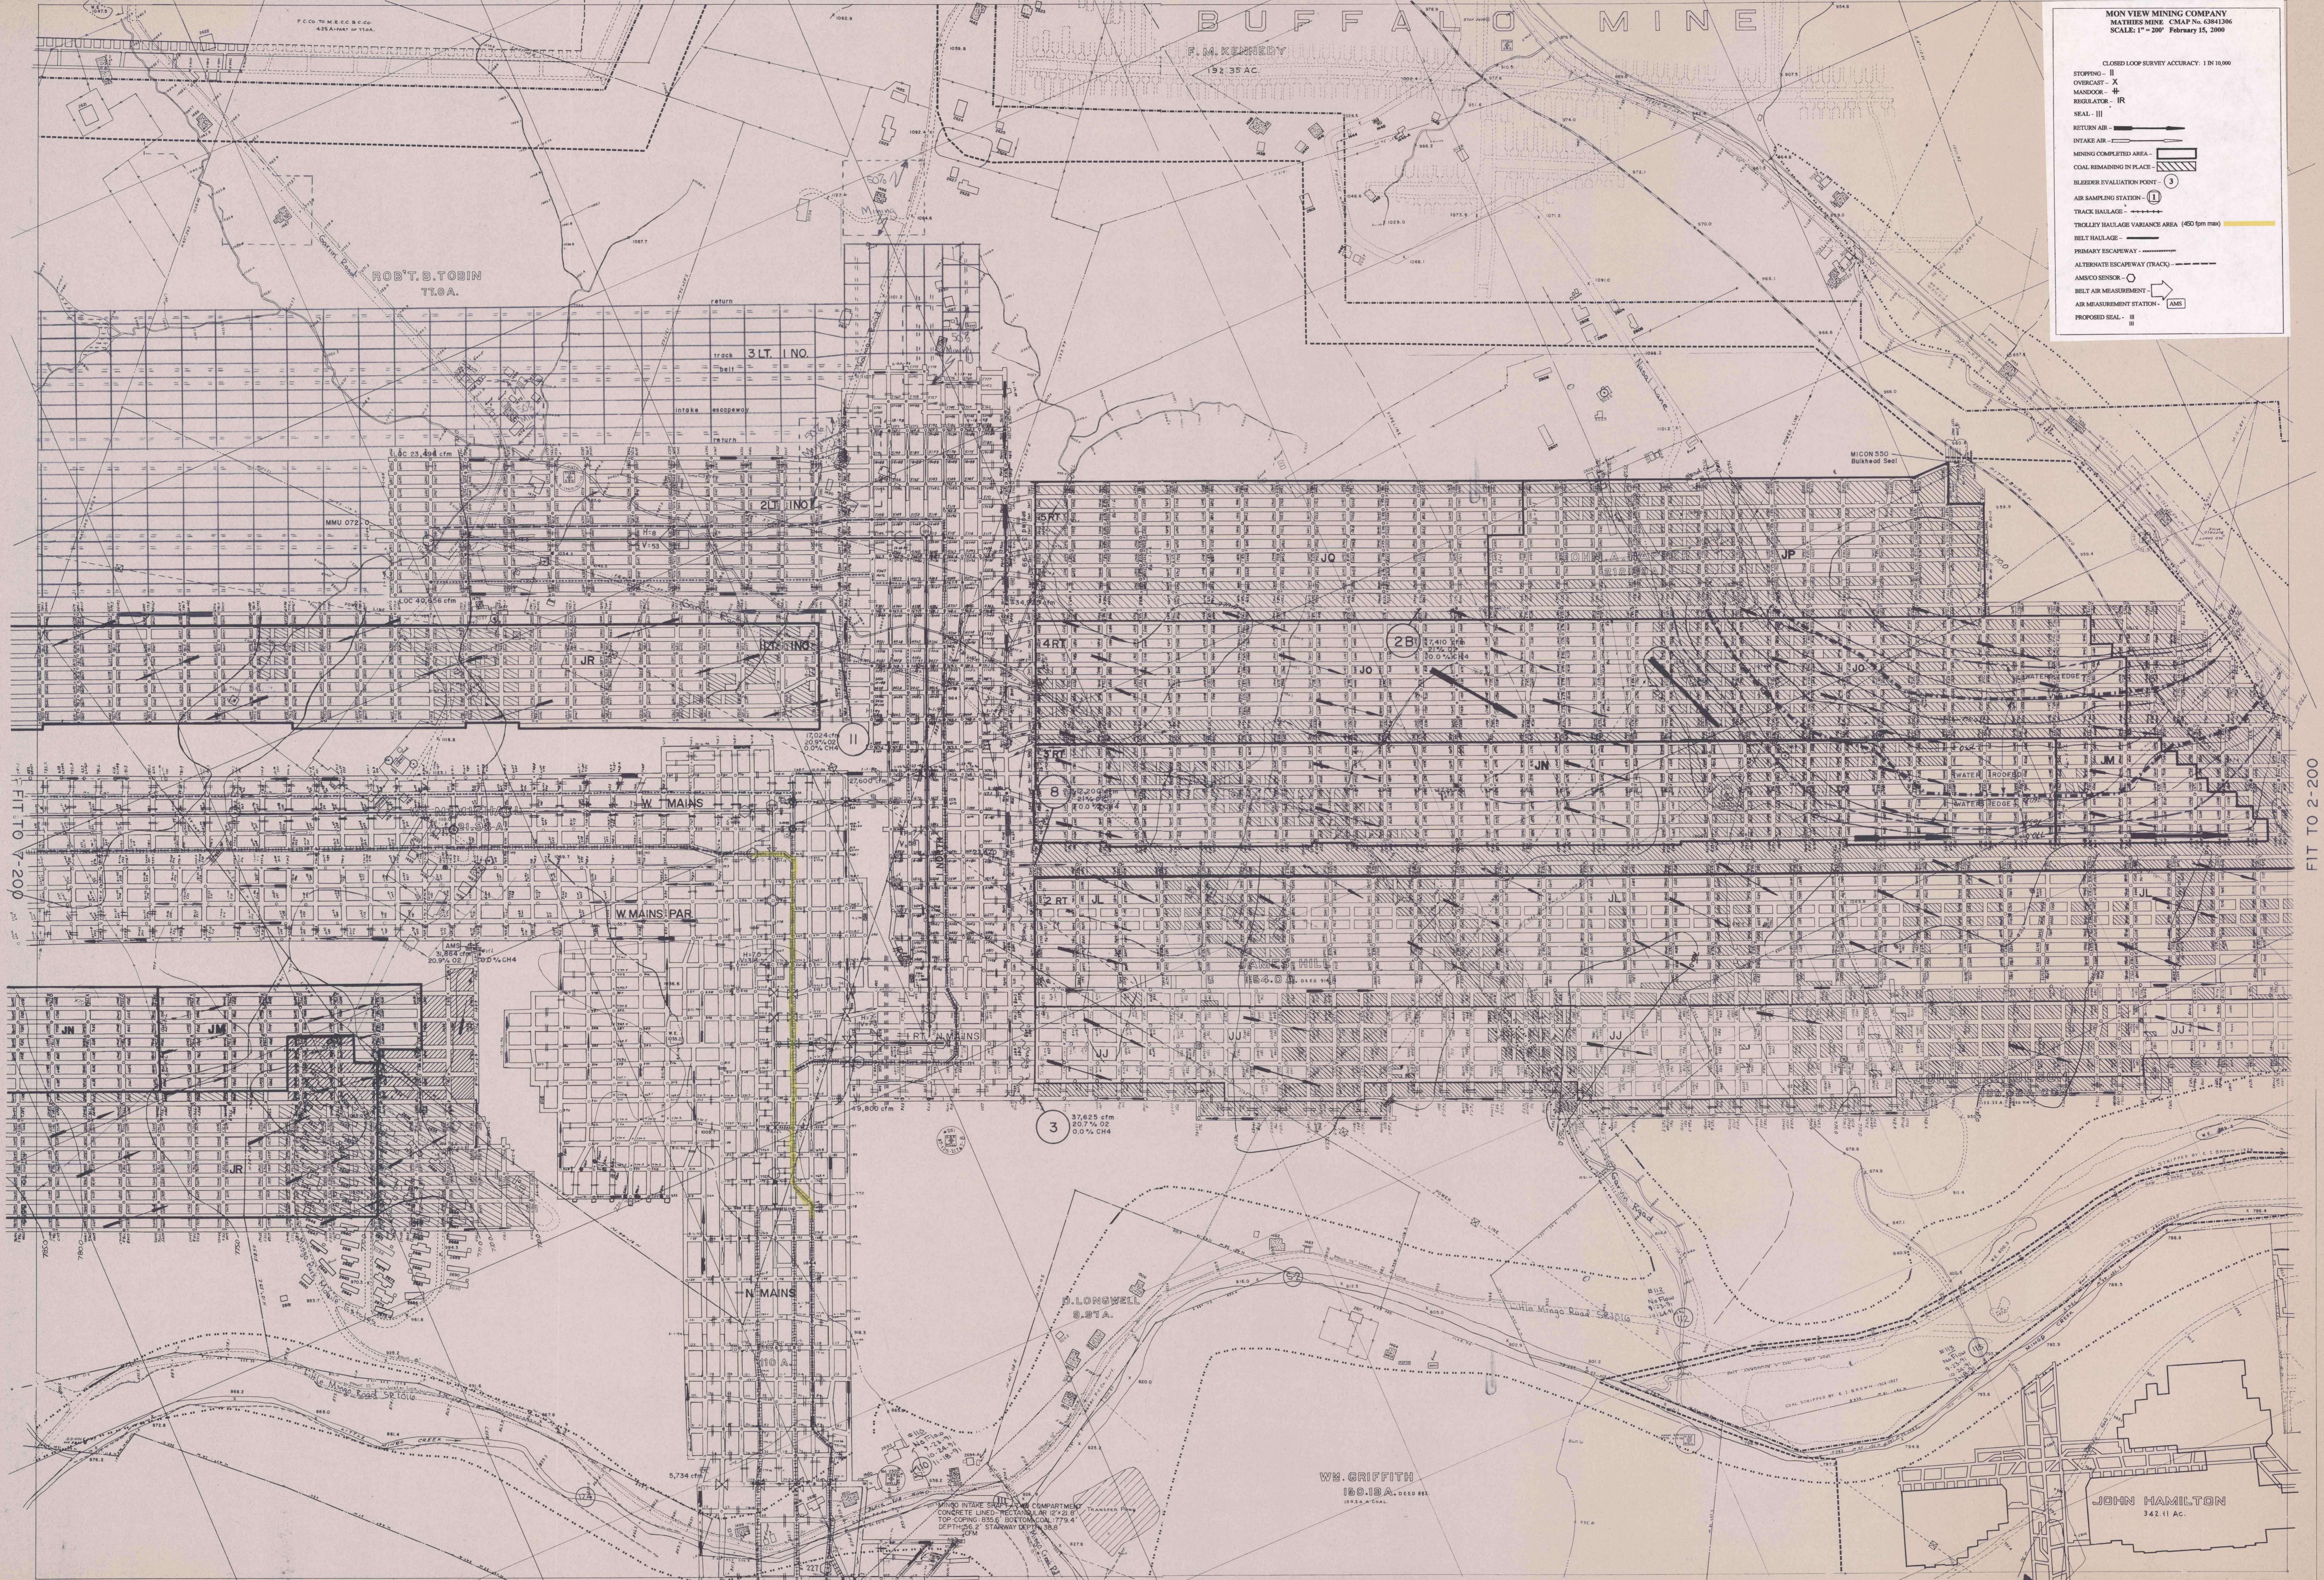

F.C.O. T.M.E.C.C.B.C.G.  
425 AIRWAY ST. 110A.

ROB'T. B. TORIN  
71.0 A.

F.M. KENNEDY  
192.35 AC.

MIGON 550  
Bulkhead Seal

W.G. GRIFFITH  
160.18 A. DEED 881  
100.16 AC.

JOHN HAMILTON  
342.11 AC.

MINGO INTAKE SHAFT COMPARTMENT  
CONCRETE LINED RECTANGULAR 12' x 22' 6"  
