


M A T H I E S C O A L C O M P A N Y

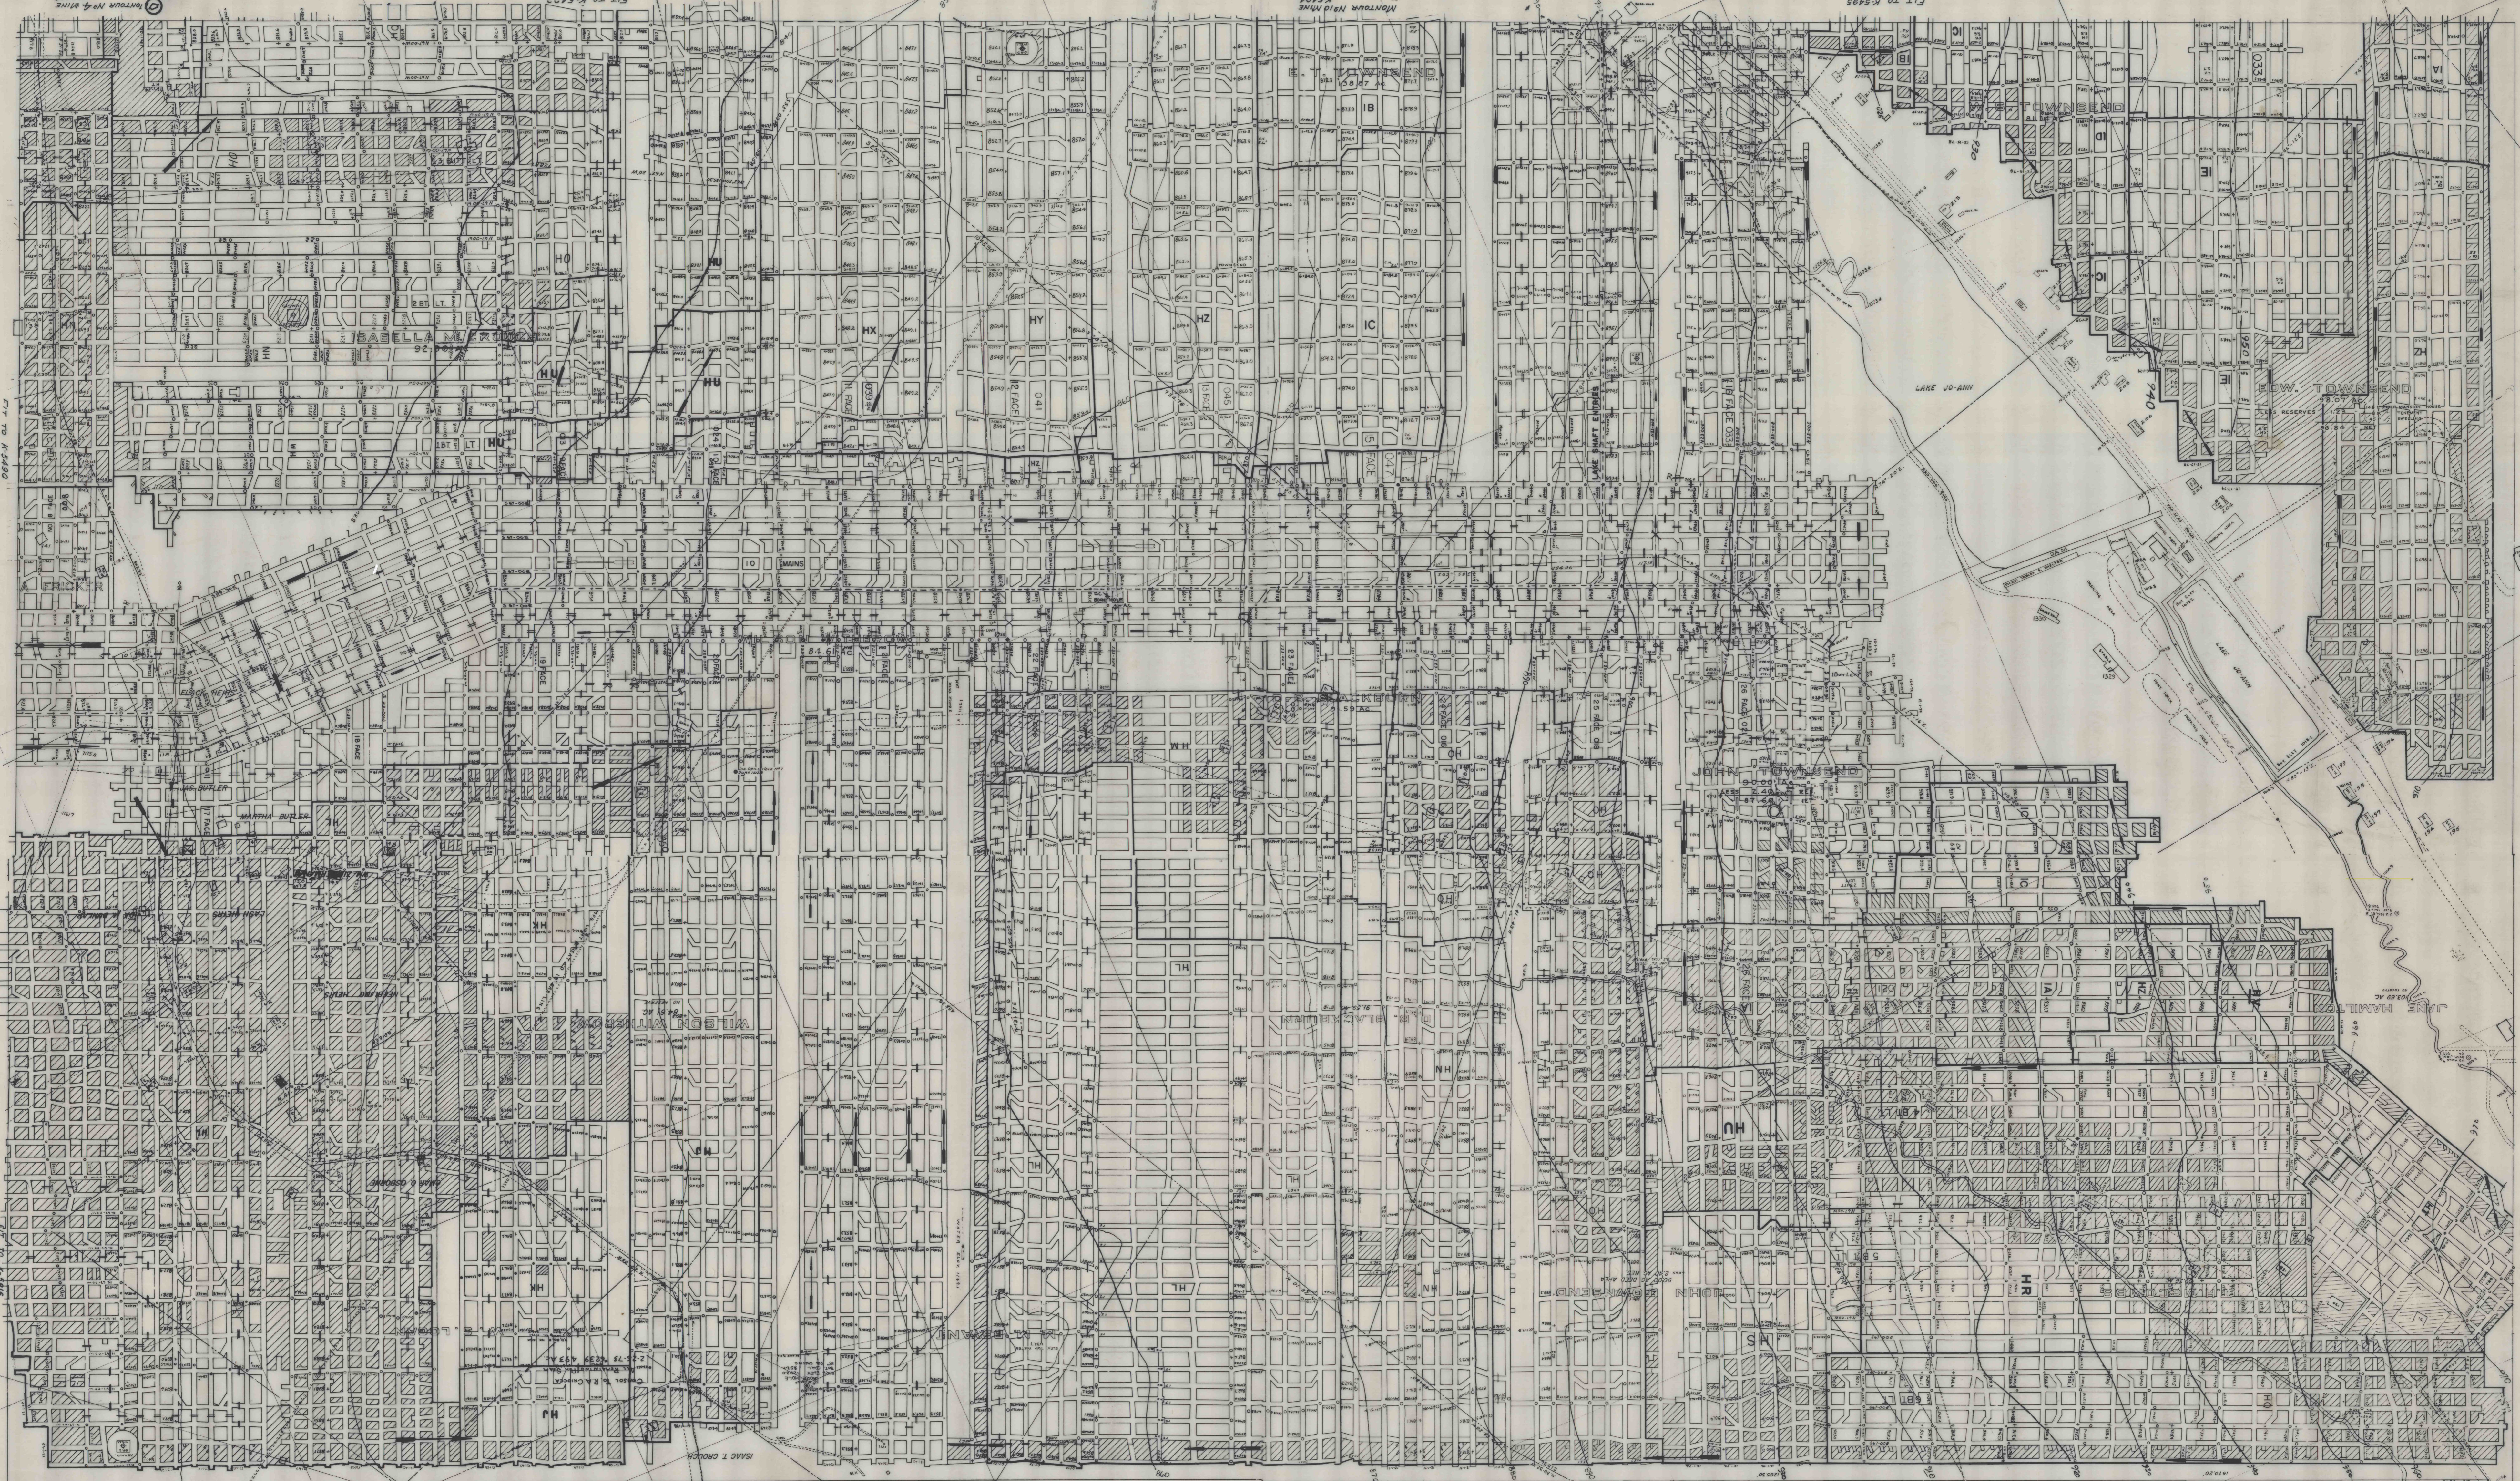

FIT TO 9

FIT TO 4

FIT TO K-561

FIT TO K-561

10

10