


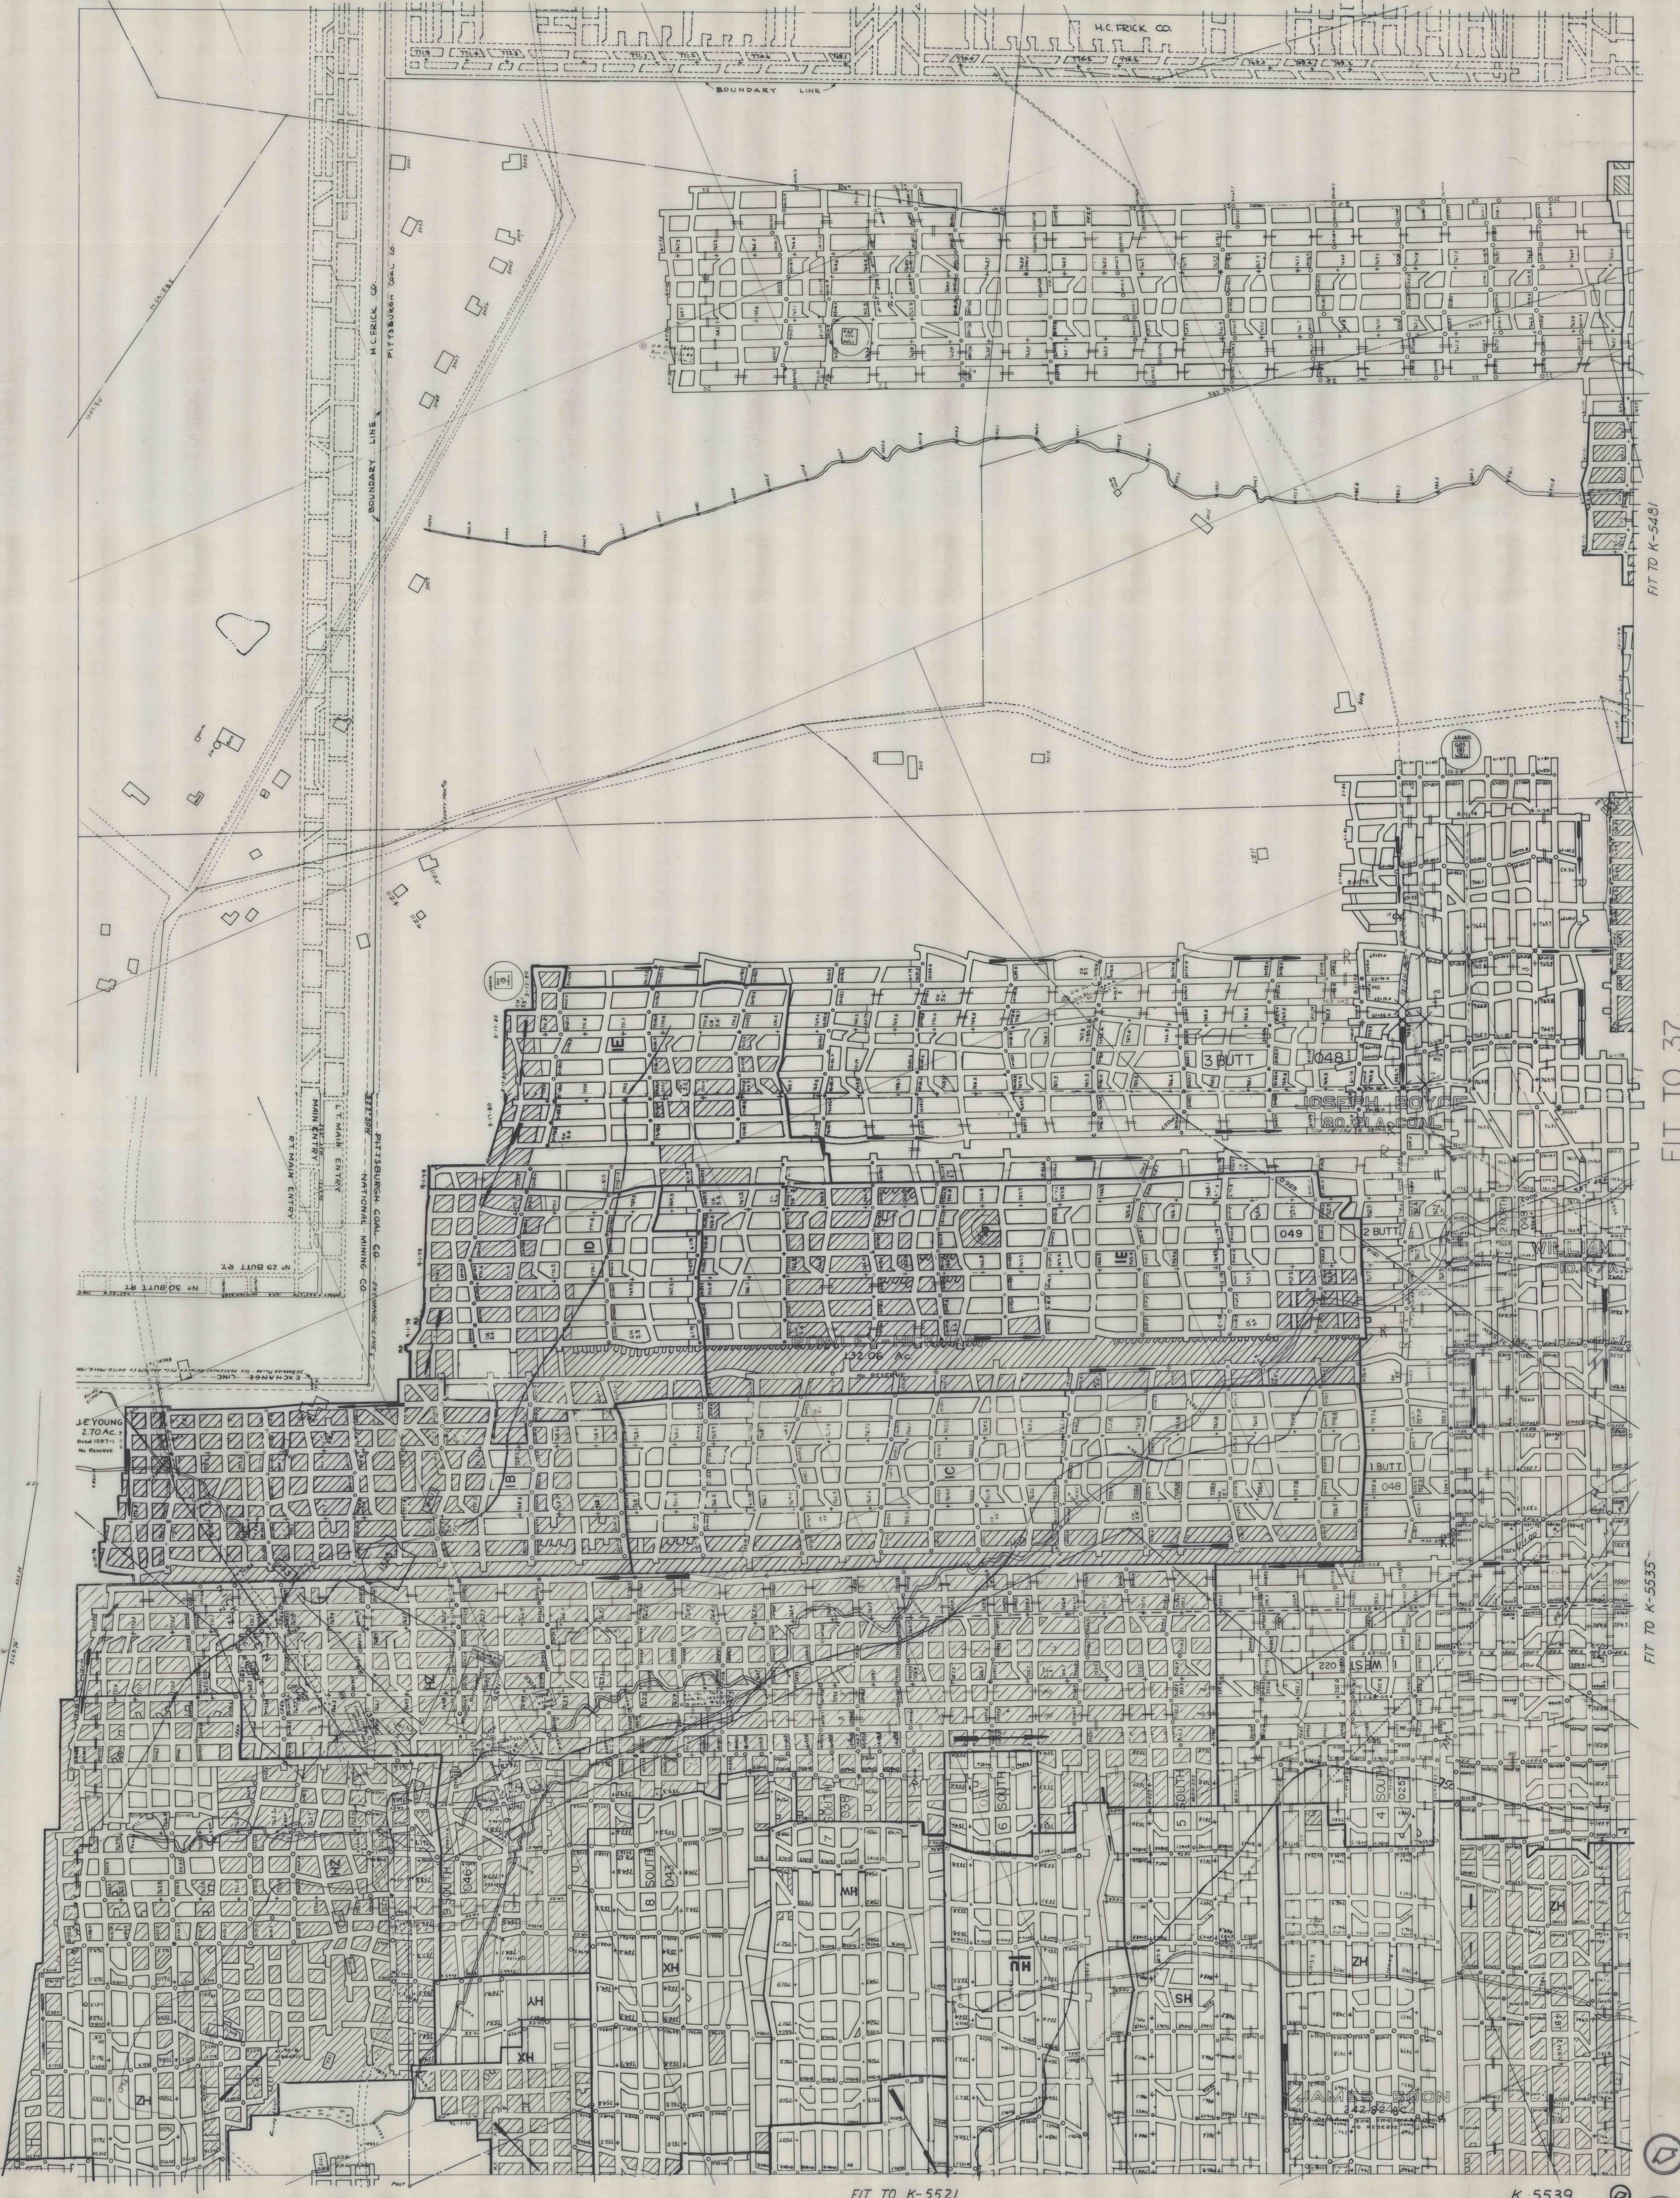

K-5536



Monour's Mine K 5189

Fit to K-5188

FIT TO 42

FIT TO K-5521

K 5539
OLD

FIT TO K-5481

FIT TO 37

FIT TO K-5535

