


Oct 11 1935 R.M.C.

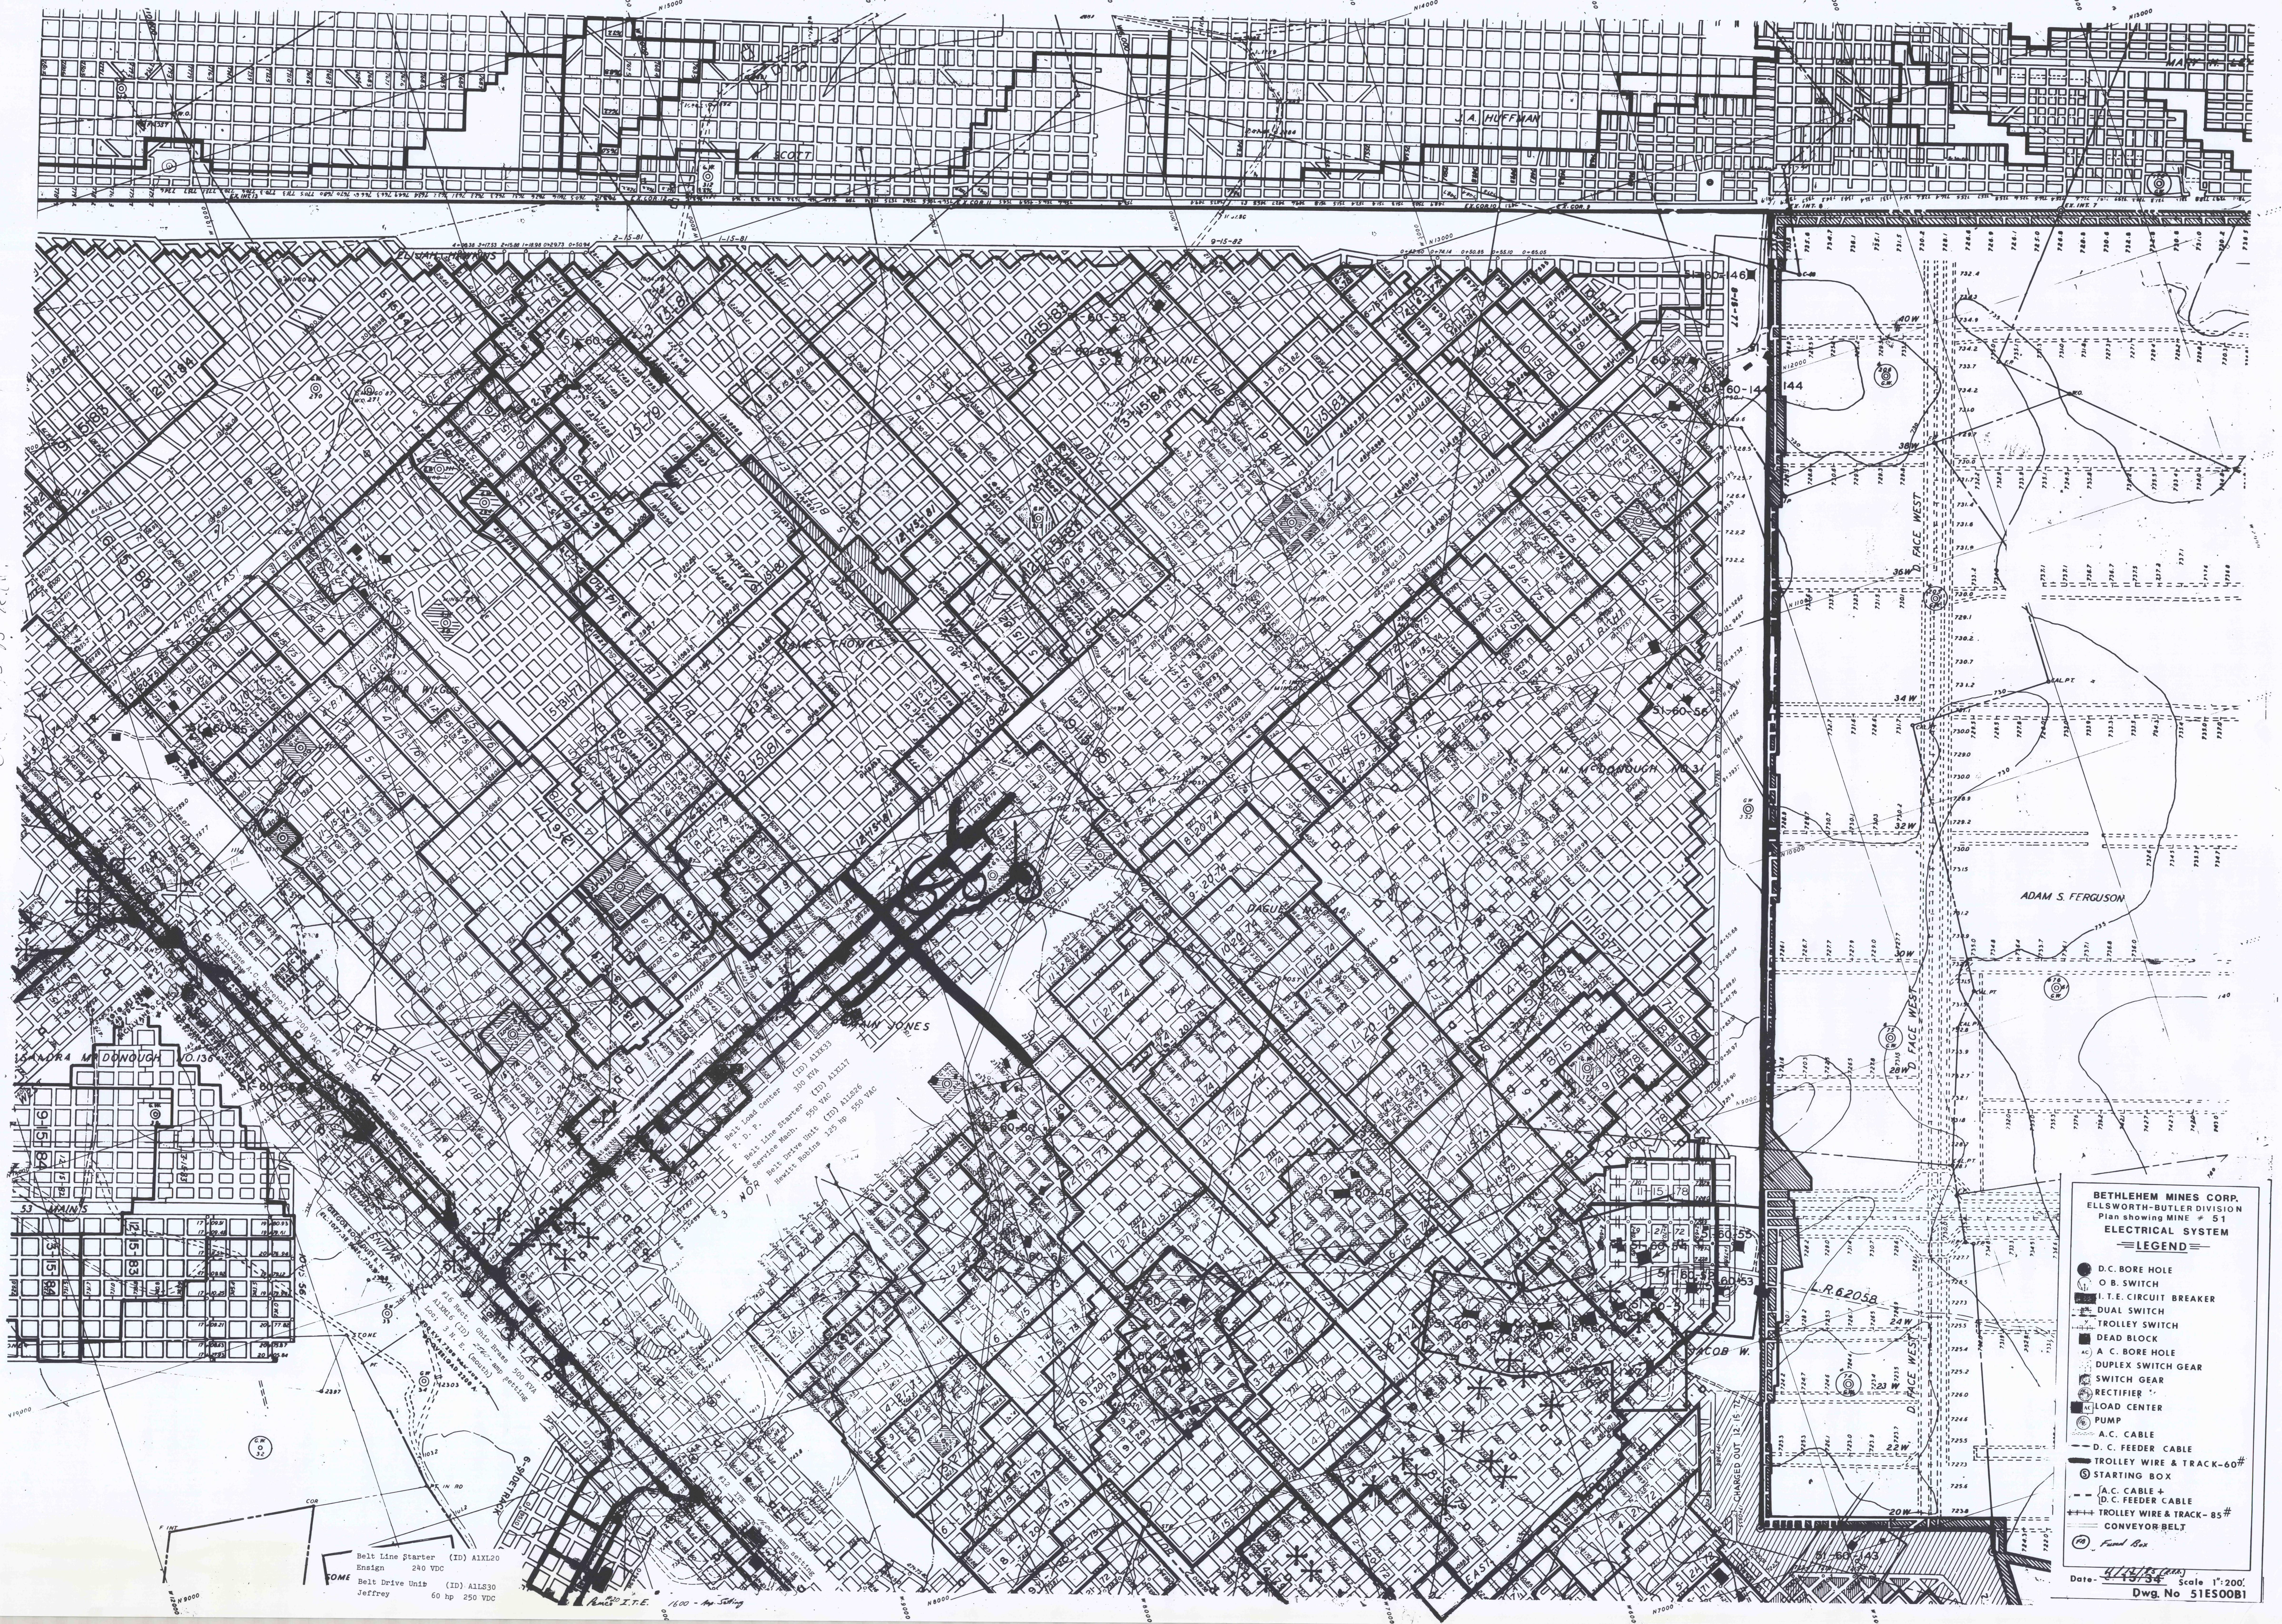

Belt Line Starter (ID) A1XL20  
 Ensign 240 VDC  
 Belt Drive Unit (ID) A1LS30  
 Jeffrey 60 hp 250 VDC

**BETHLEHEM MINES CORP.**  
**ELLSWORTH-BUTLER DIVISION**  
 Plan showing MINE # 51  
**ELECTRICAL SYSTEM**

**LEGEND**

- D.C. BORE HOLE
- B. SWITCH
- ⊖ I.T.E. CIRCUIT BREAKER
- ⊕ DUAL SWITCH
- ⊖ TROLLEY SWITCH
- ⊖ DEAD BLOCK
- A.C. BORE HOLE
- ⊖ DUPLEX SWITCH GEAR
- ⊖ SWITCH GEAR
- ⊖ RECTIFIER
- ⊖ LOAD CENTER
- ⊖ PUMP
- A.C. CABLE
- D.C. FEEDER CABLE
- TROLLEY WIRE & TRACK-60#
- ⊖ STARTING BOX
- A.C. CABLE + D.C. FEEDER CABLE
- TROLLEY WIRE & TRACK-85#
- CONVEYOR BELT
- ⊖ Fund Box

Date: 10-3-35 Scale 1"=200'  
 Dwg. No 51ES0081