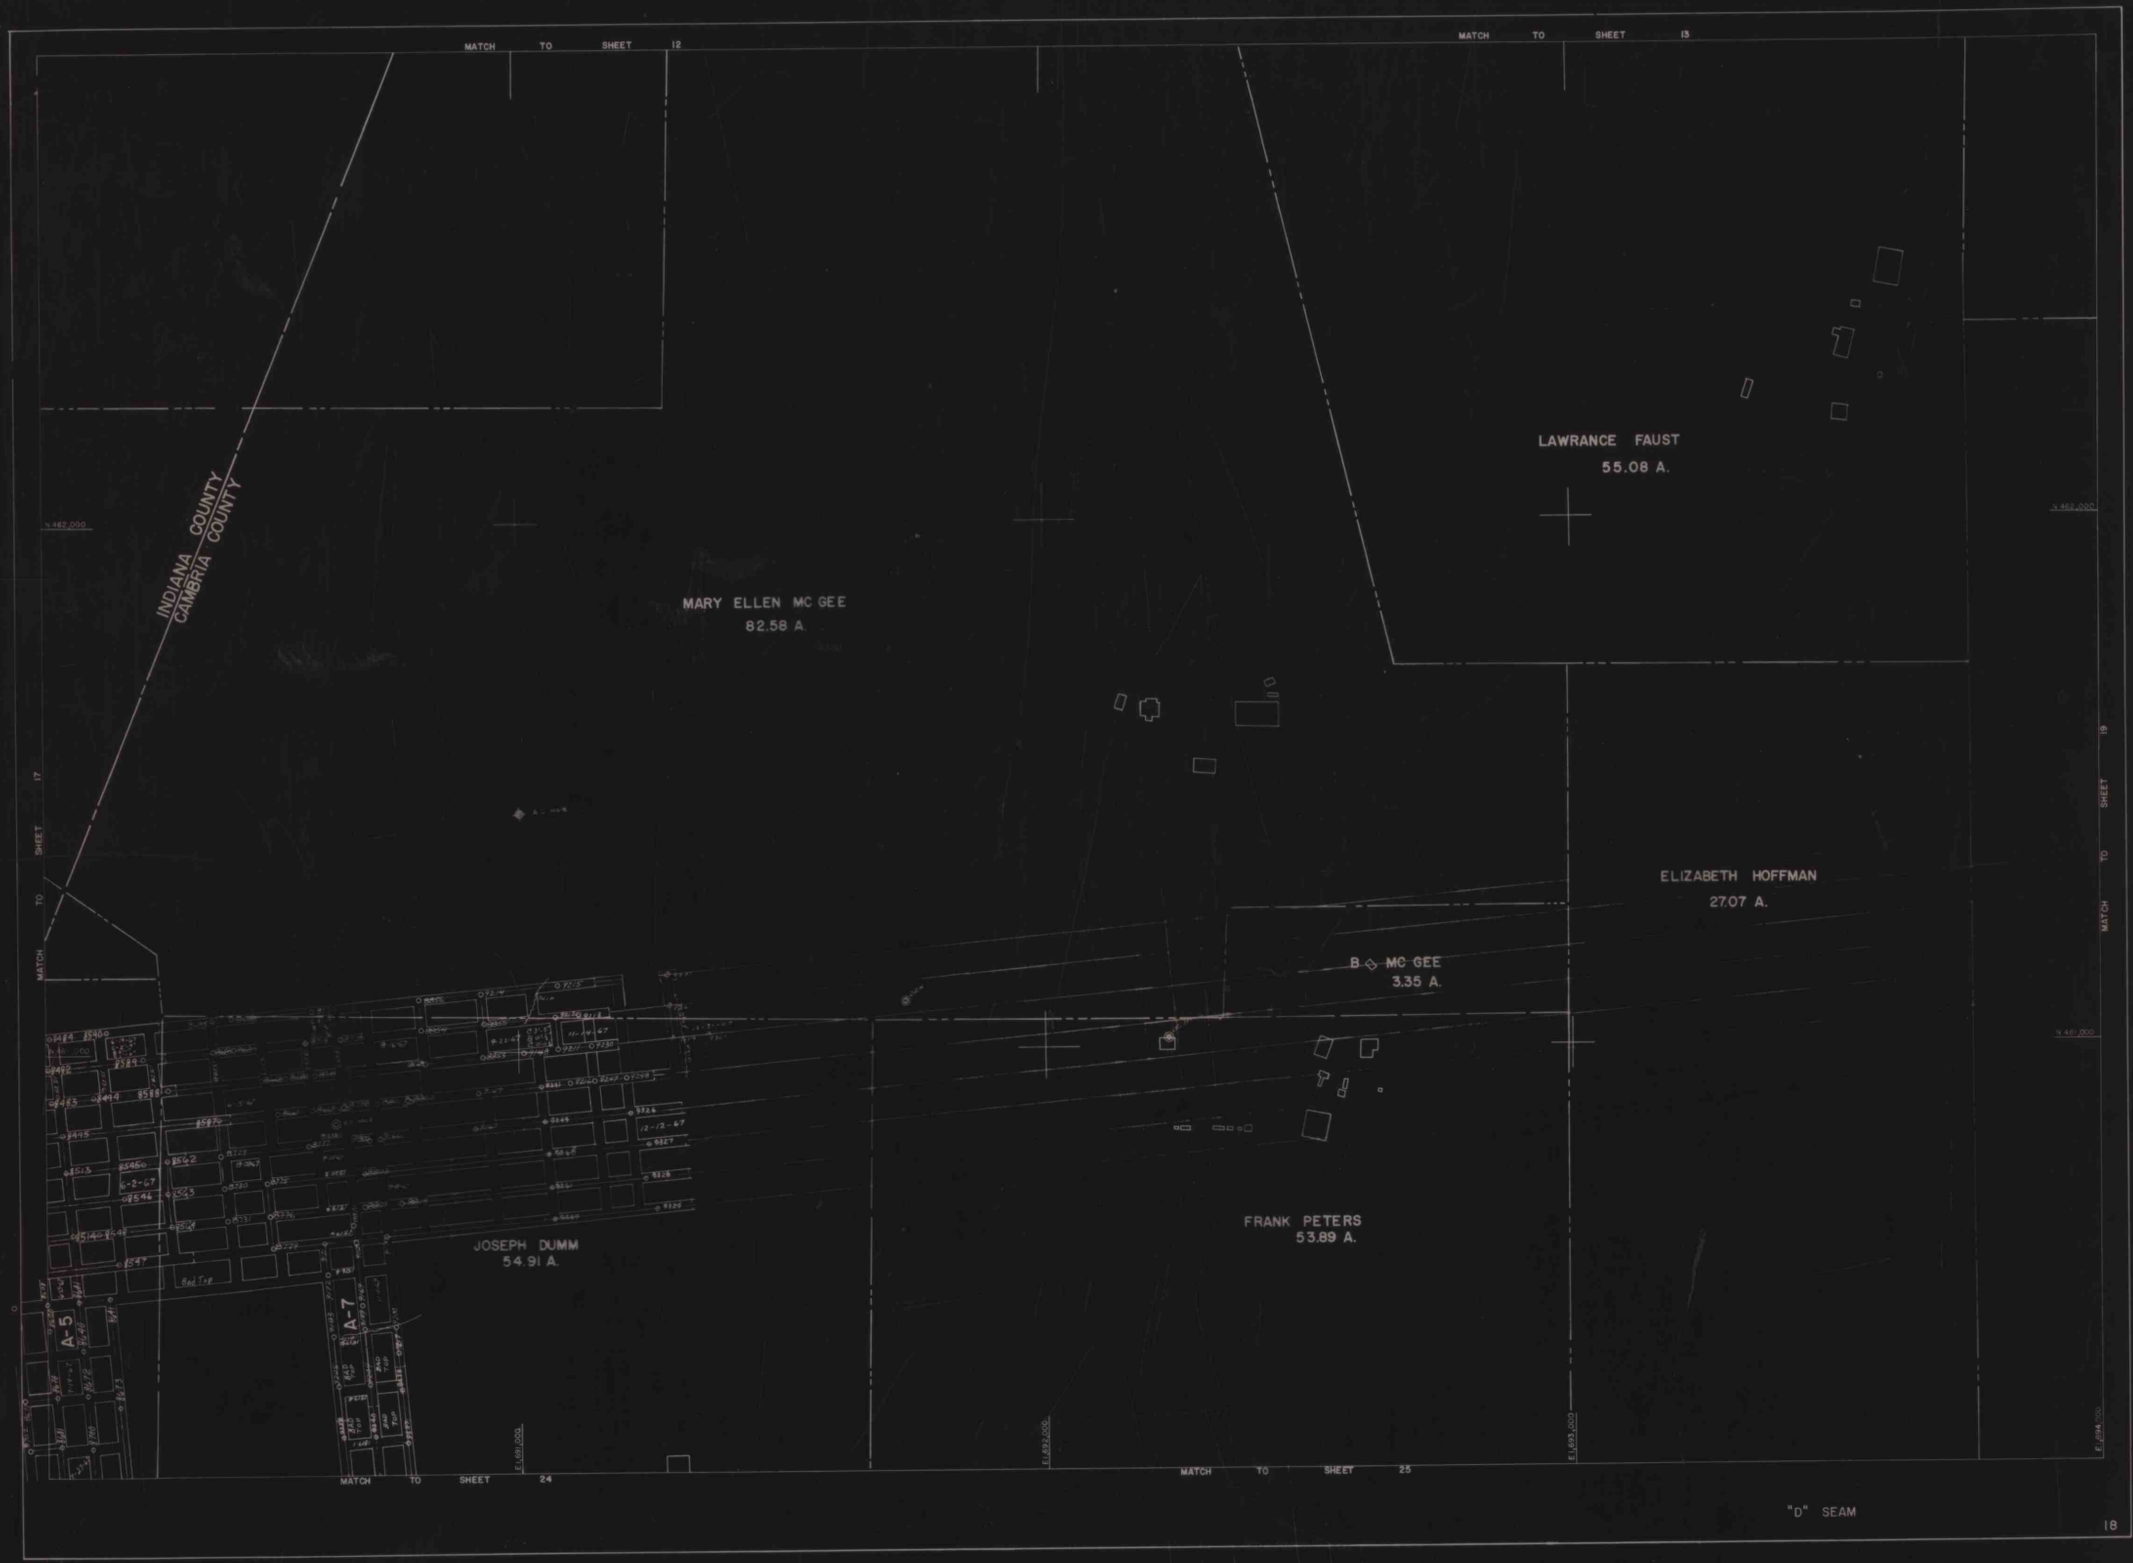
MATCH TO SHEET 12
MATCH TO SHEET 13
INDIANA COUNTY
CAMBRIA COUNTY
MARY ELLEN MC GEE
82.58 A.
LAWRANCE FAUST
55.08 A.
ELIZABETH HOFFMAN
27.07 A.
B ◇ MC GEE
3.35 A.
JOSEPH DUMM
54.91 A.
FRANK PETERS
53.89 A.
A-5
A-7
MATCH TO SHEET 17
MATCH TO SHEET 19
MATCH TO SHEET 24
MATCH TO SHEET 25
N 462,000
N 461,000
E 1,691,000
E 1,692,000
E 1,693,000
"D" SEAM
18