


MATCH TO 12

MATCH TO 13

N462,000

N461,000

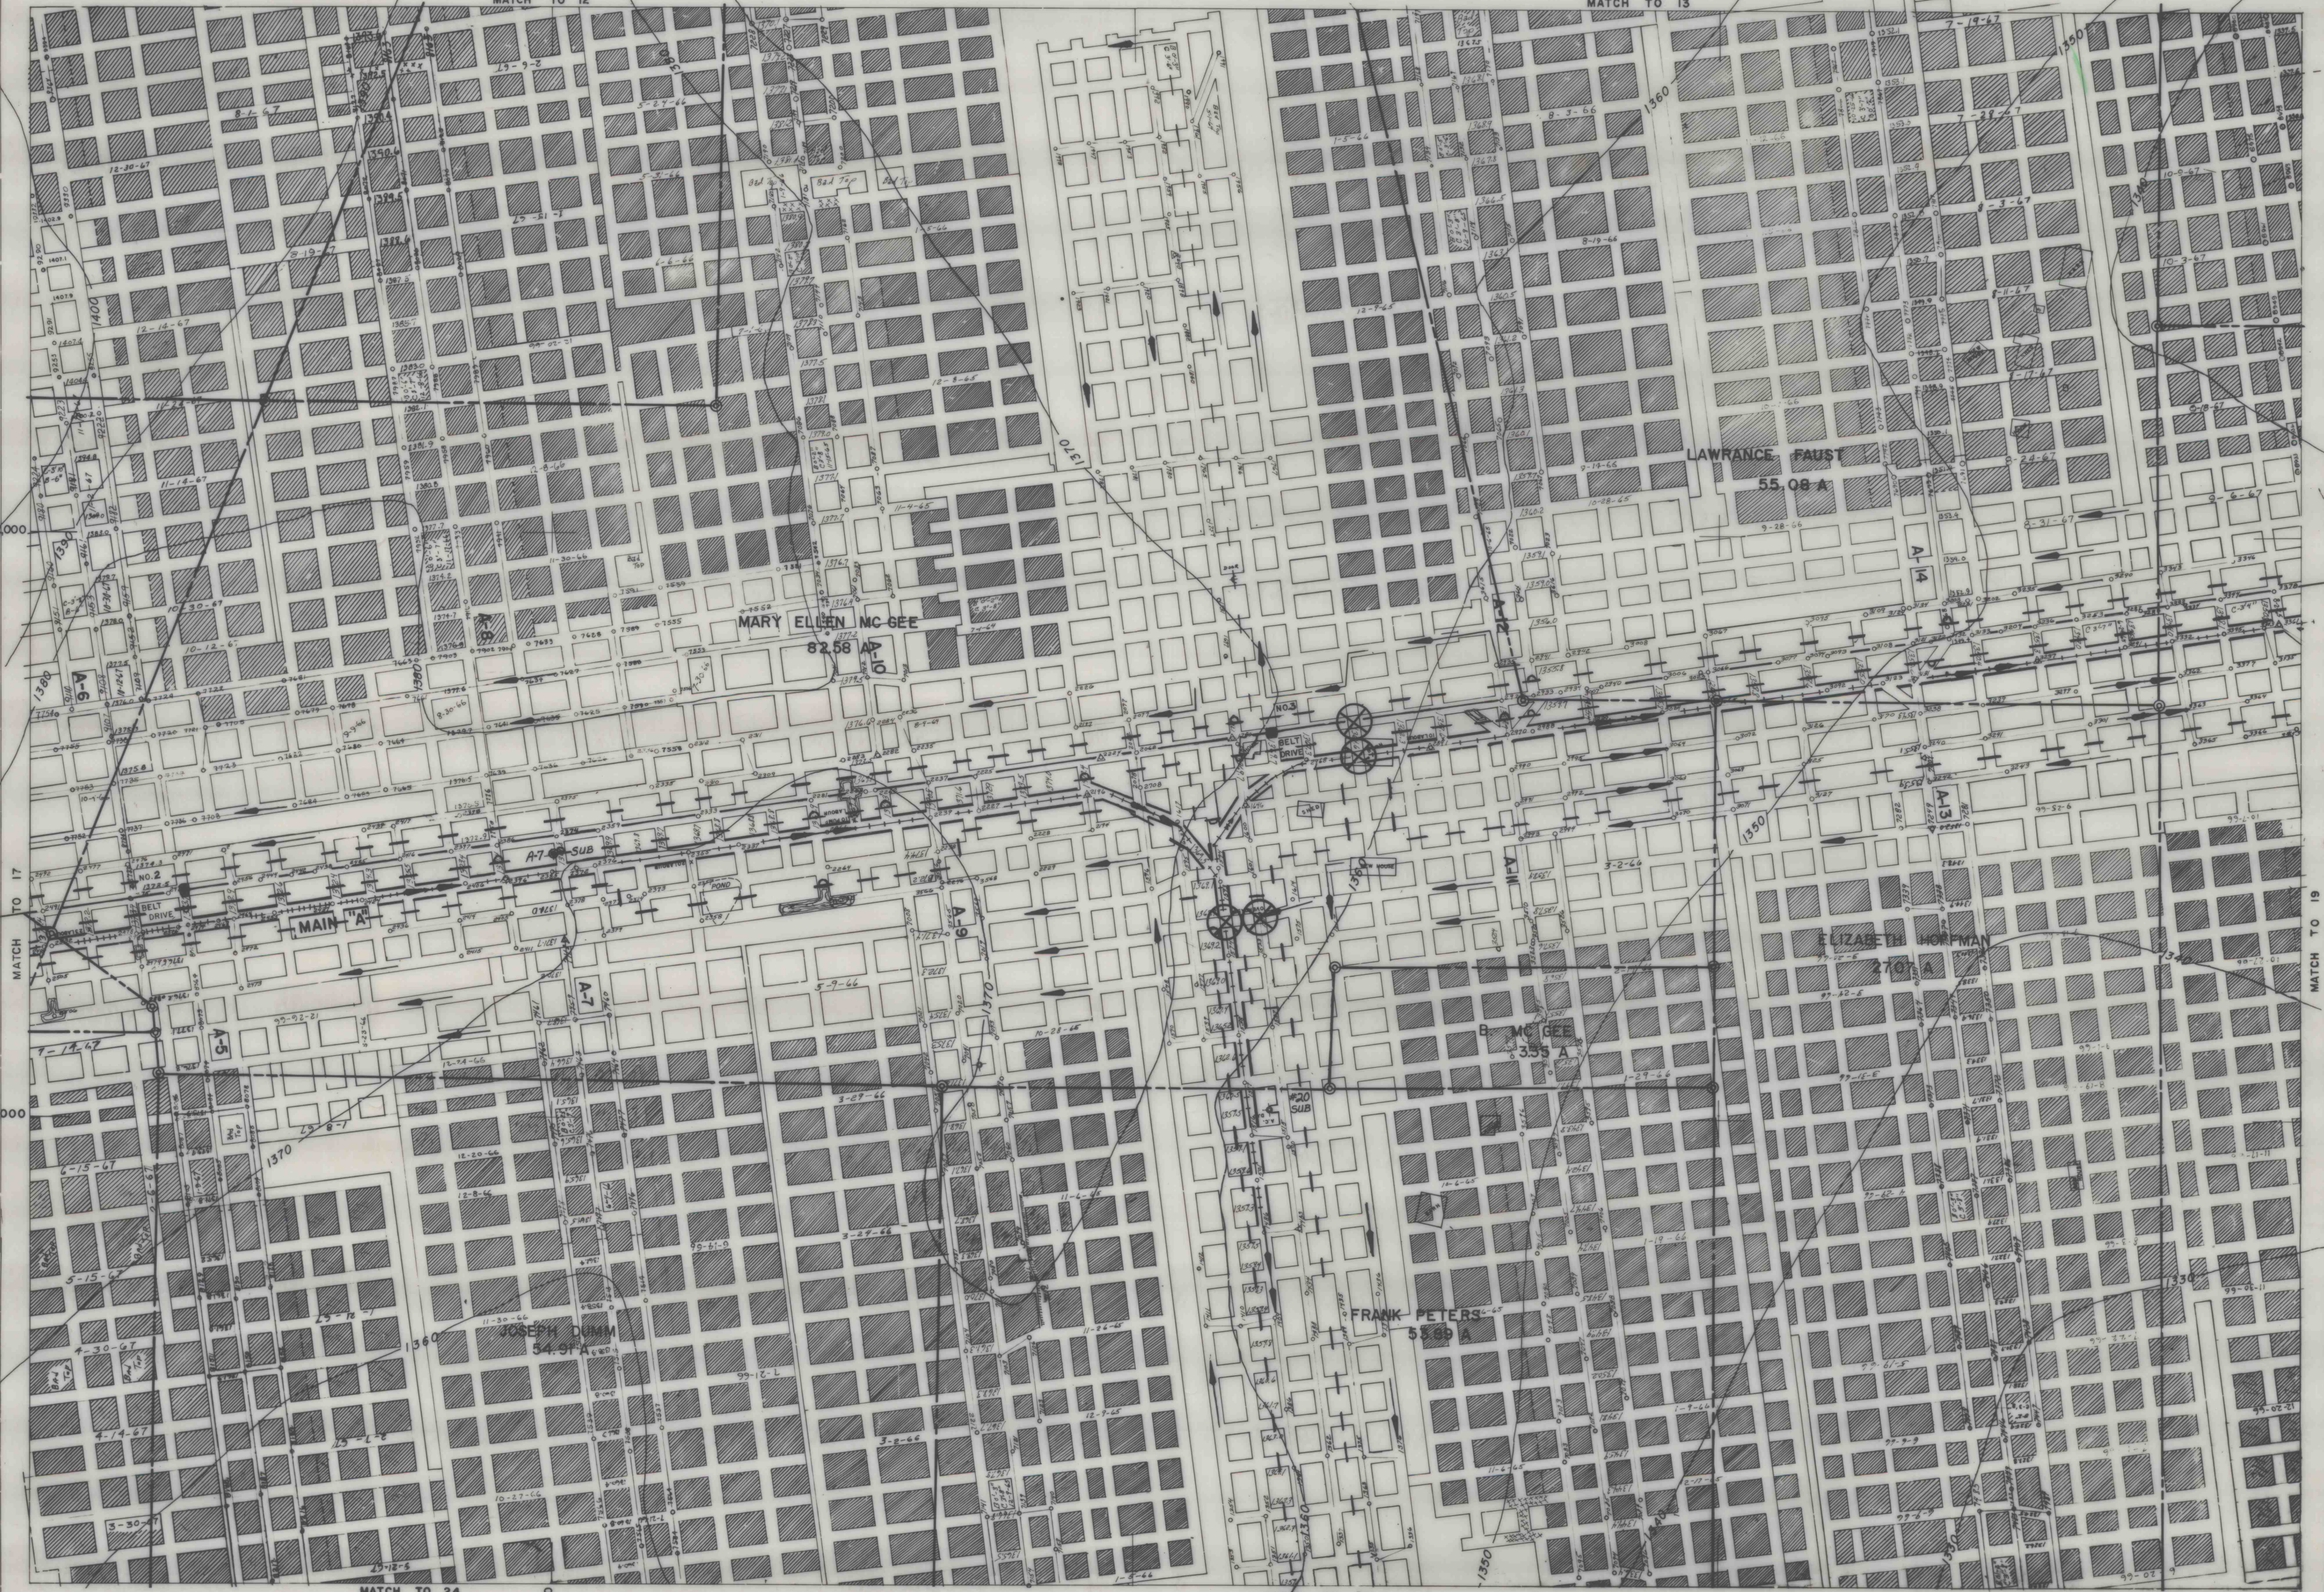

MARY ELLEN MC GEE
82.58 A

LAWRANCE FAUST
55.08 A

ELIZABETH HOFFMAN
270 A

FRANK PETERS
55.69 A

JOSEPH DUMM
54.94 A

MATCH TO 24

MATCH TO 25

E1691,000

NO. 24 8" SEAM