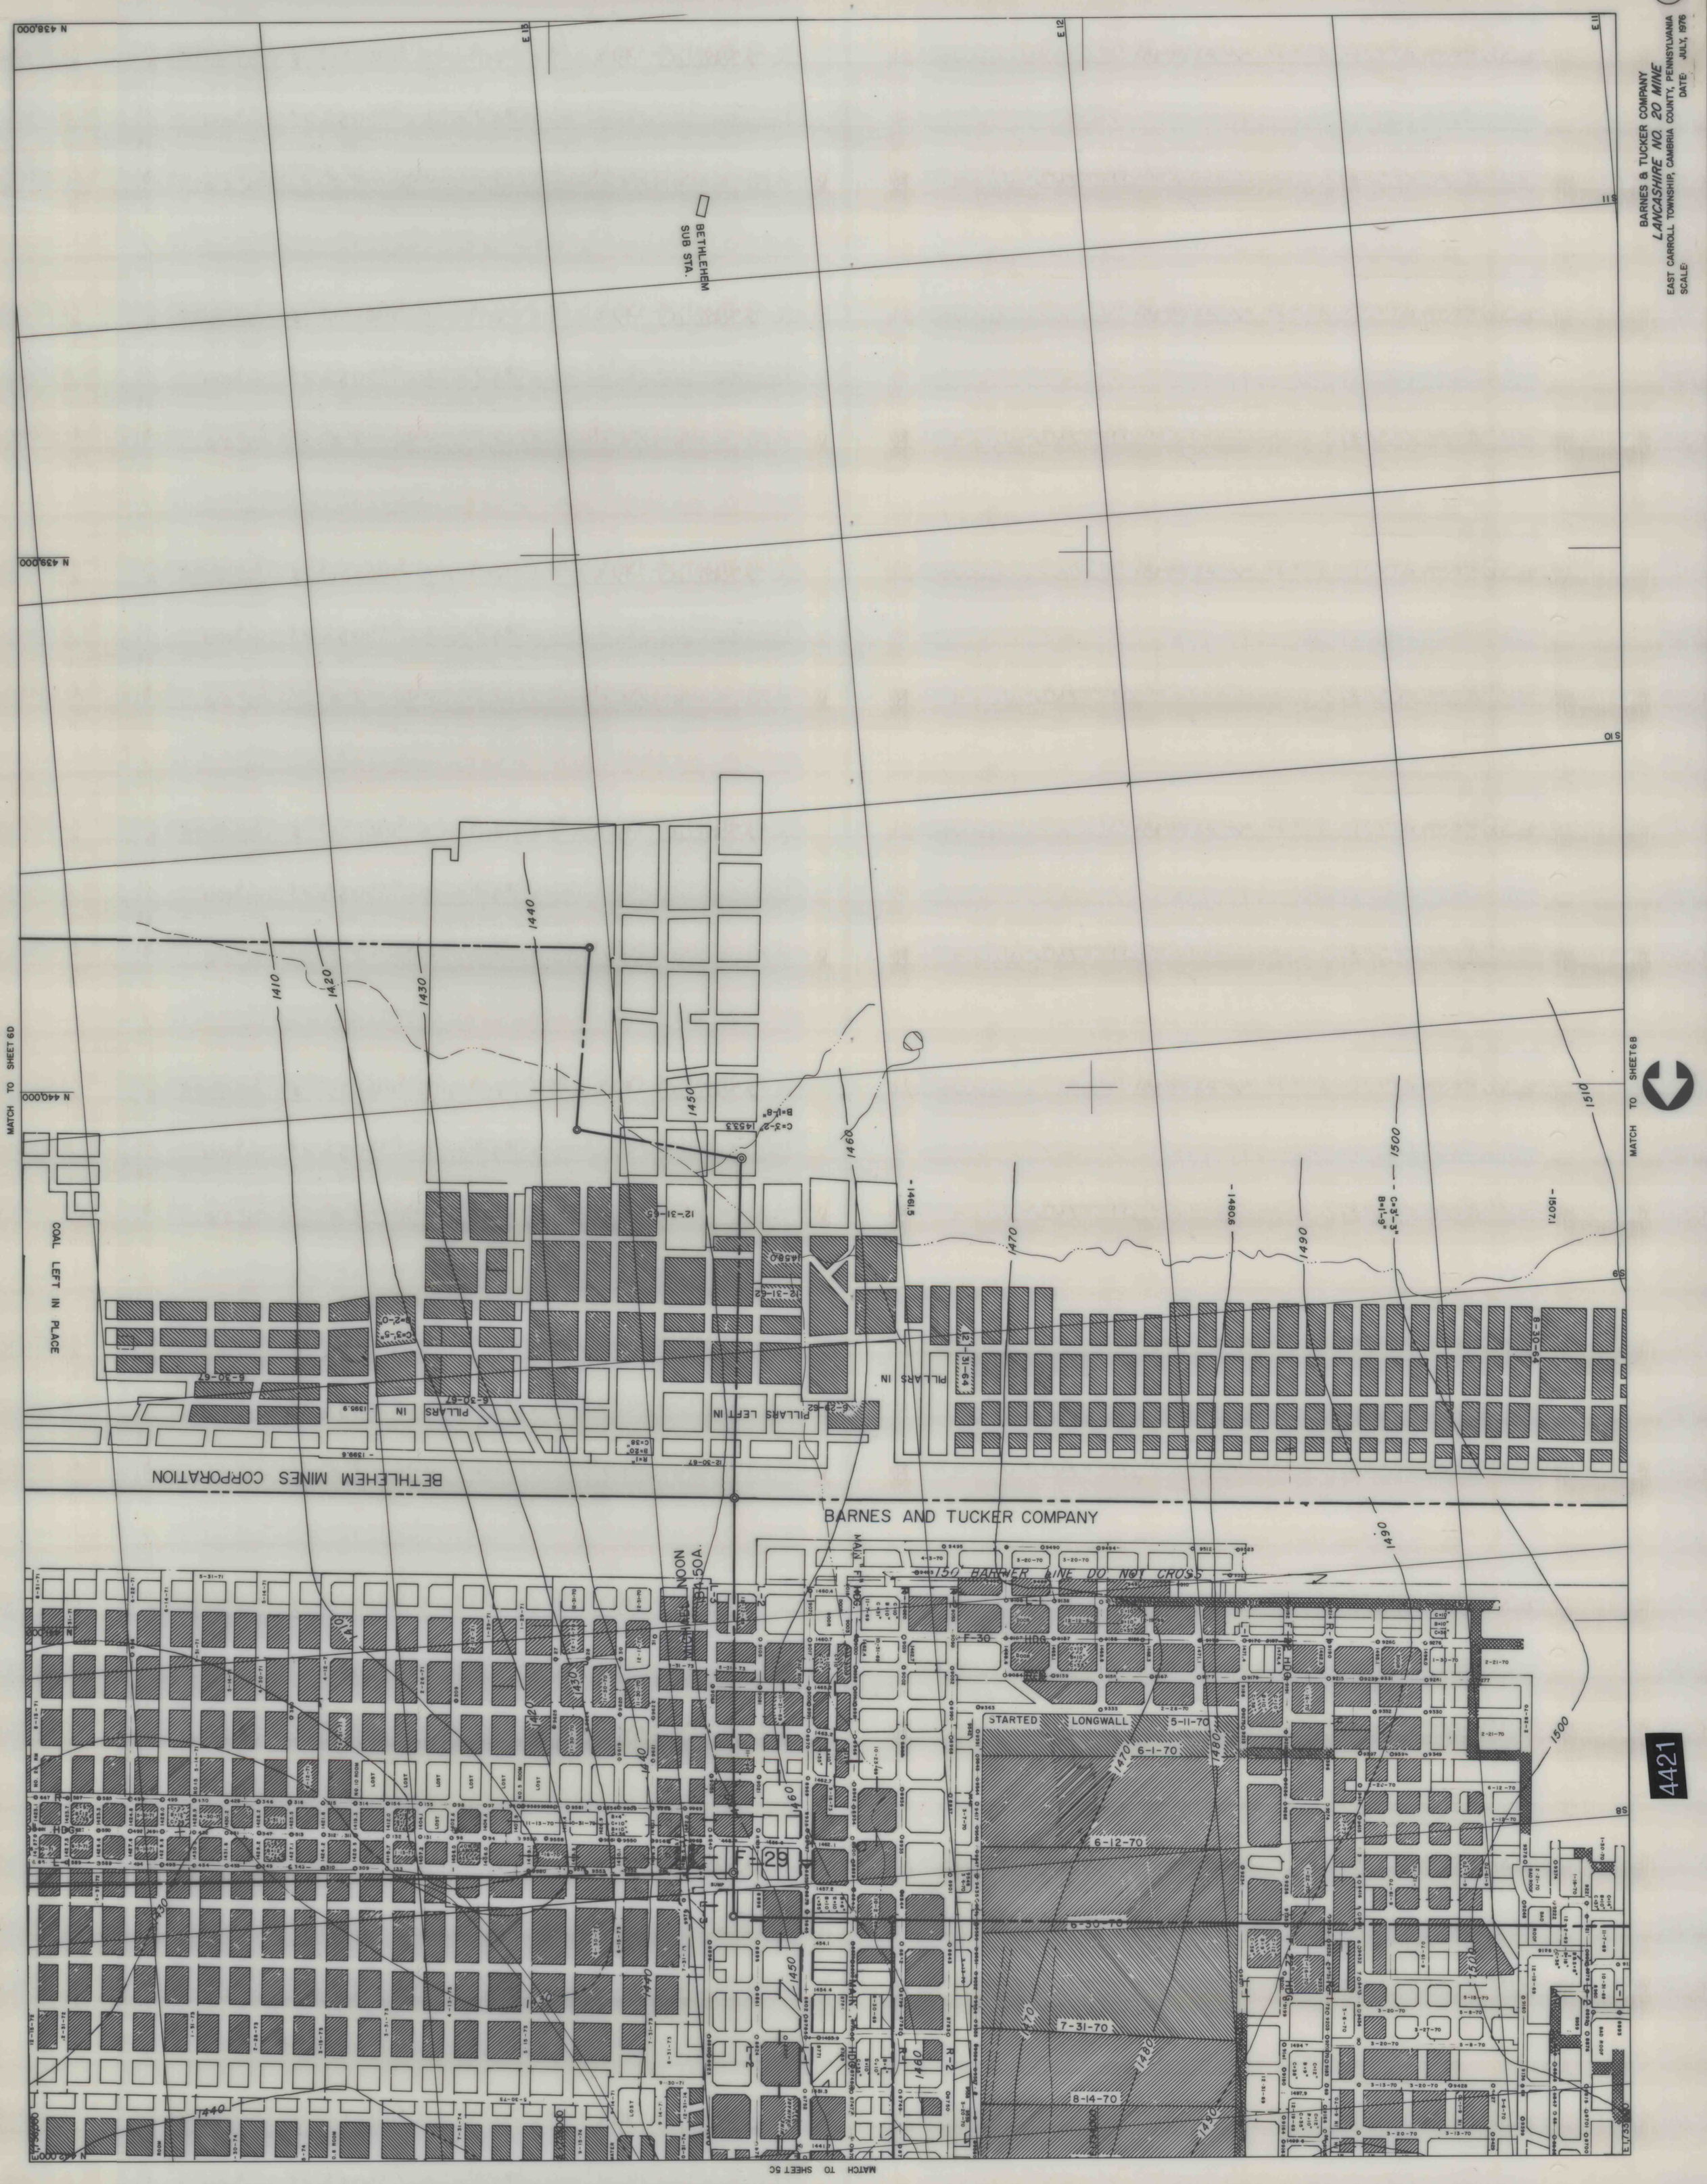

BARNES & TUCKER COMPANY
LANCASHIRE NO. 20 MINE
EAST CARROLL TOWNSHIP, CAMBRIA COUNTY, PENNSYLVANIA
SCALE:
DATE: JULY, 1976
6C
BETHLEHEM SUB STA.
BETHLEHEM MINES CORPORATION
BARNES AND TUCKER COMPANY
COAL LEFT IN PLACE
PILLARS IN
PILLARS LEFT IN
150' BARRIER LINE DO NOT CROSS
STARTED LONGWALL
5-11-70
6-1-70
6-12-70
6-30-70
7-31-70
8-14-70
F-29
MATCH TO SHEET 6D
MATCH TO SHEET 6B
MATCH TO SHEET 5C
4421