

N 462,000
E 1735,000

E 1732,000

E 1731,000

E 1730,000

N 461,000


N 460,000

N 459,000

N 458,000

4421

Strip Area

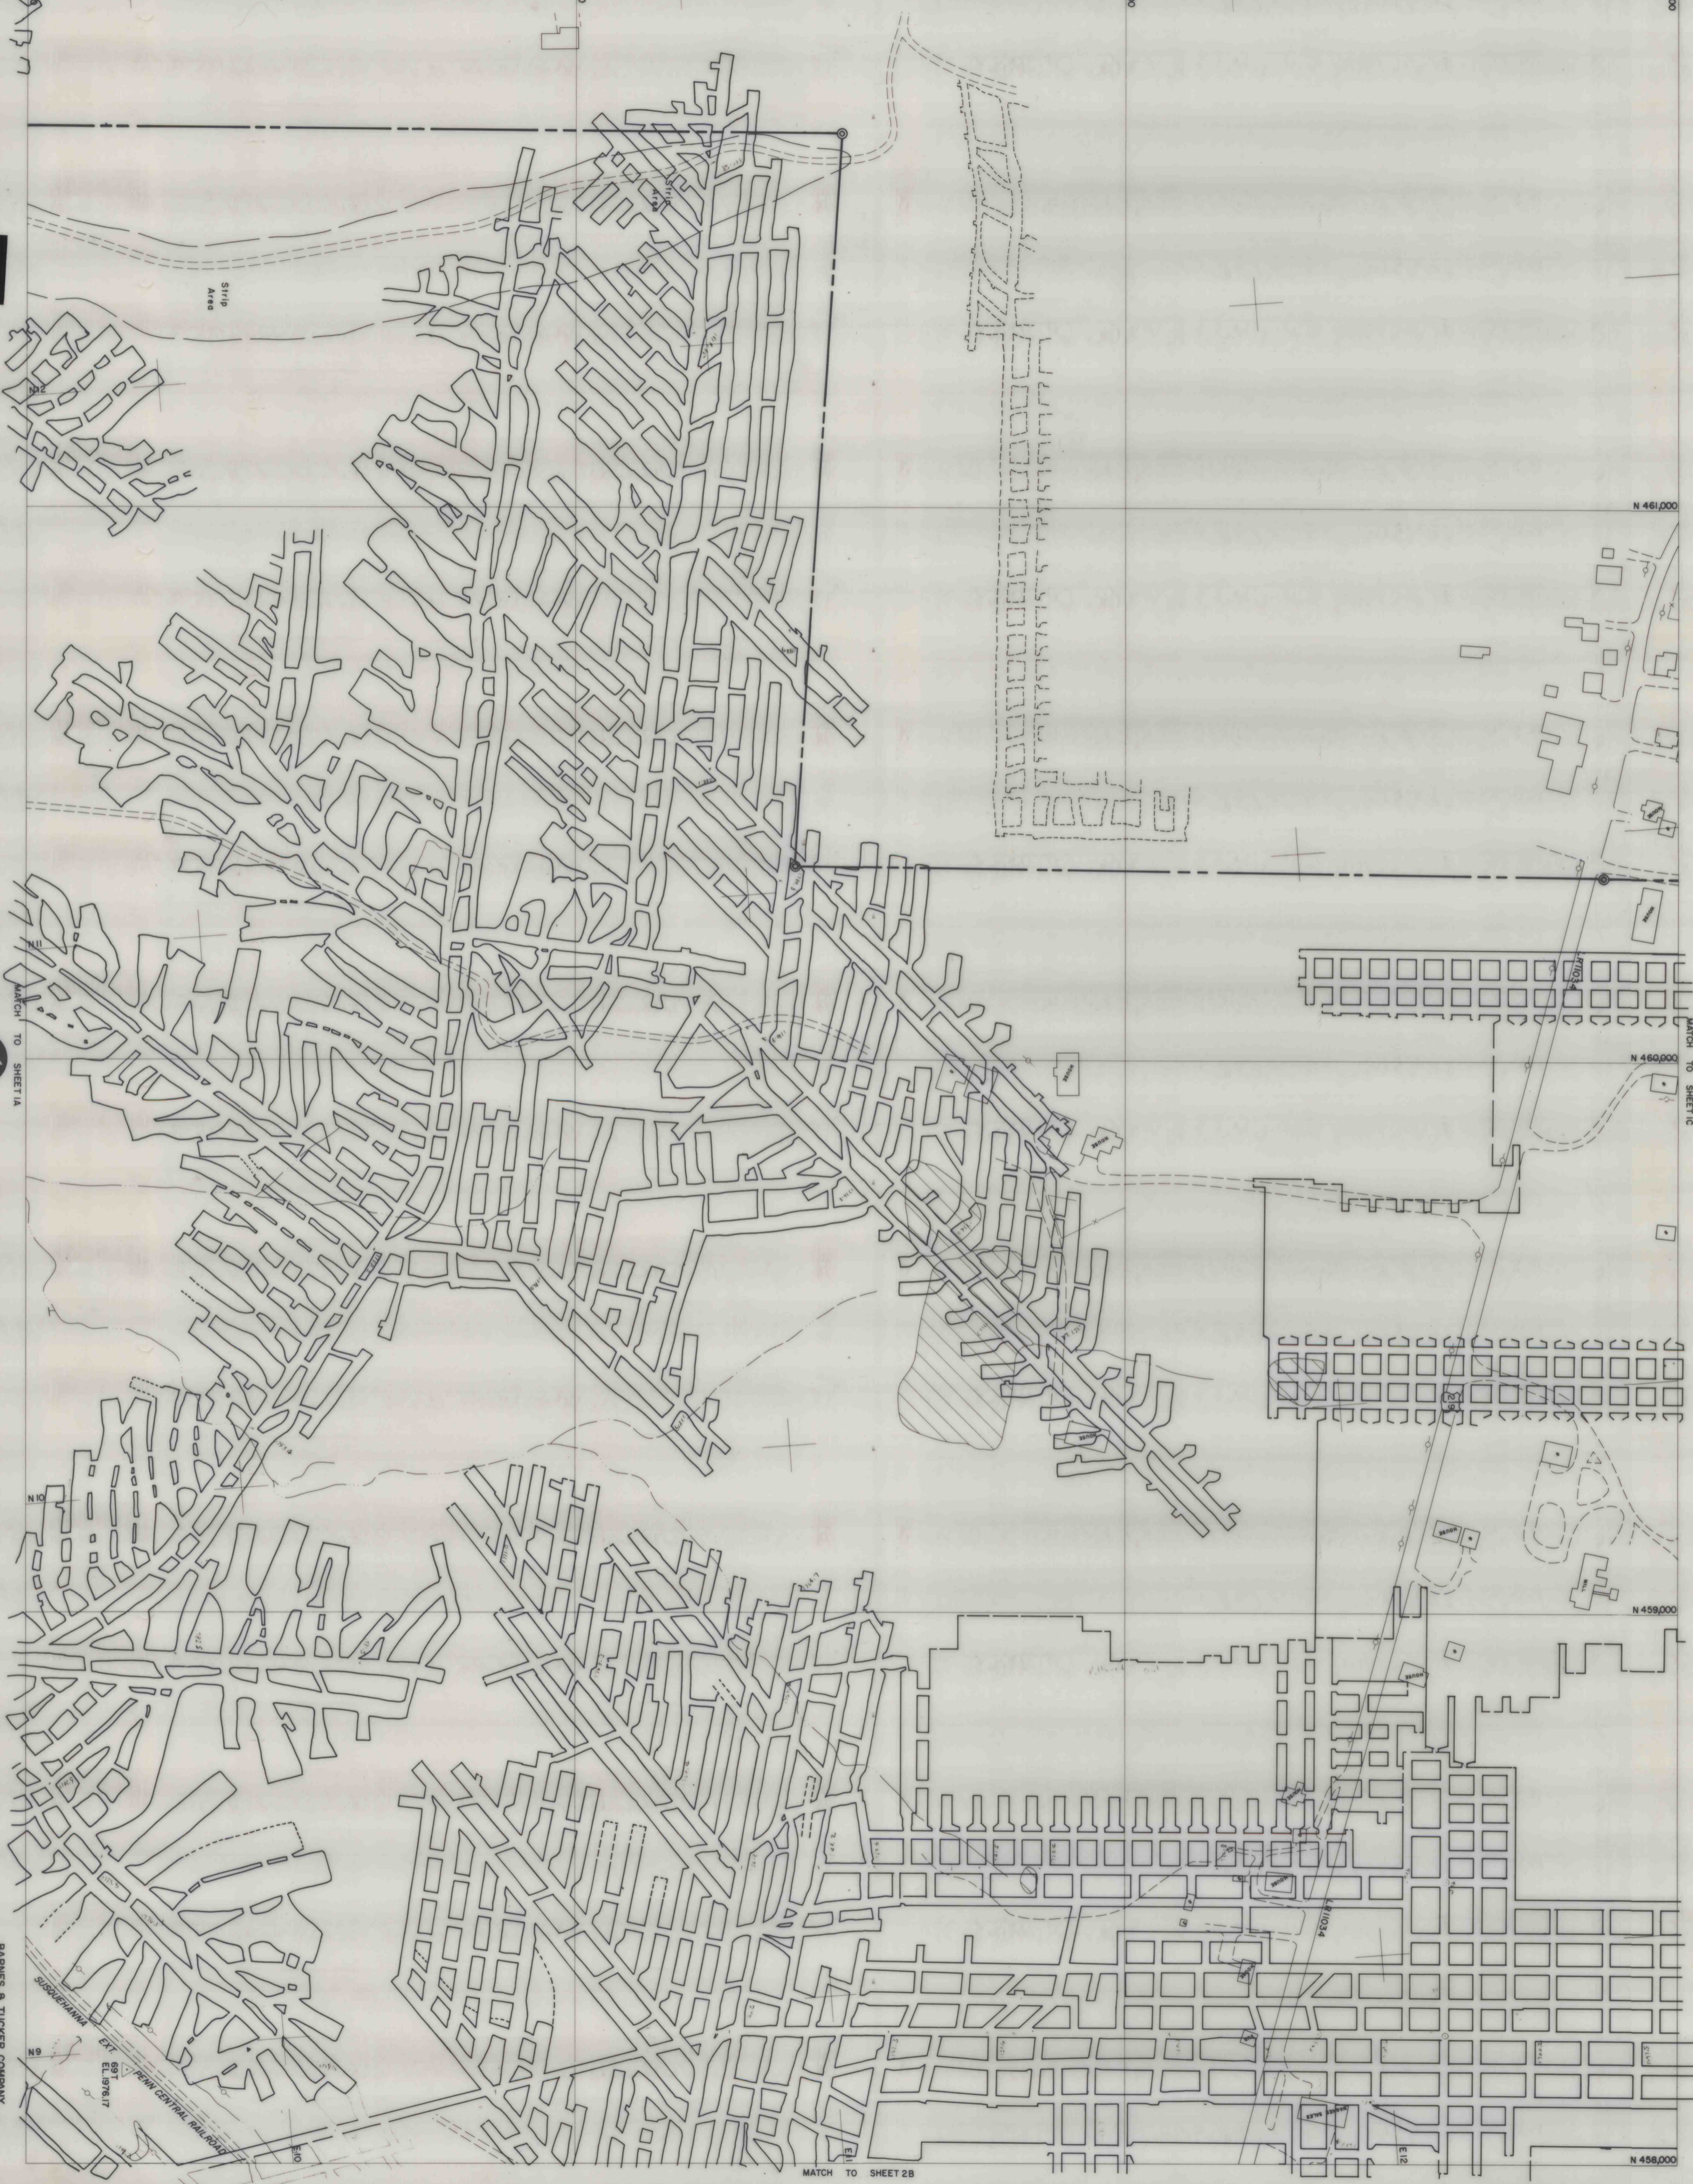

BARNES & TUCKER COMPANY
 LANCASTER NO. 20 MINE
 EAST CARROLL TOWNSHIP, CAMBRIA COUNTY, PENNSYLVANIA
 SCALE 1" = 100'
 DATE JULY, 1976

18

MATCH TO SHEET 2B