

E 1733,000

E 1732,000

E 1731,000

E 1730,000

N 454,000


N 452,000

N 451,000


N 450,000

MATCH TO SHEET 3C

MATCH TO SHEET 4B

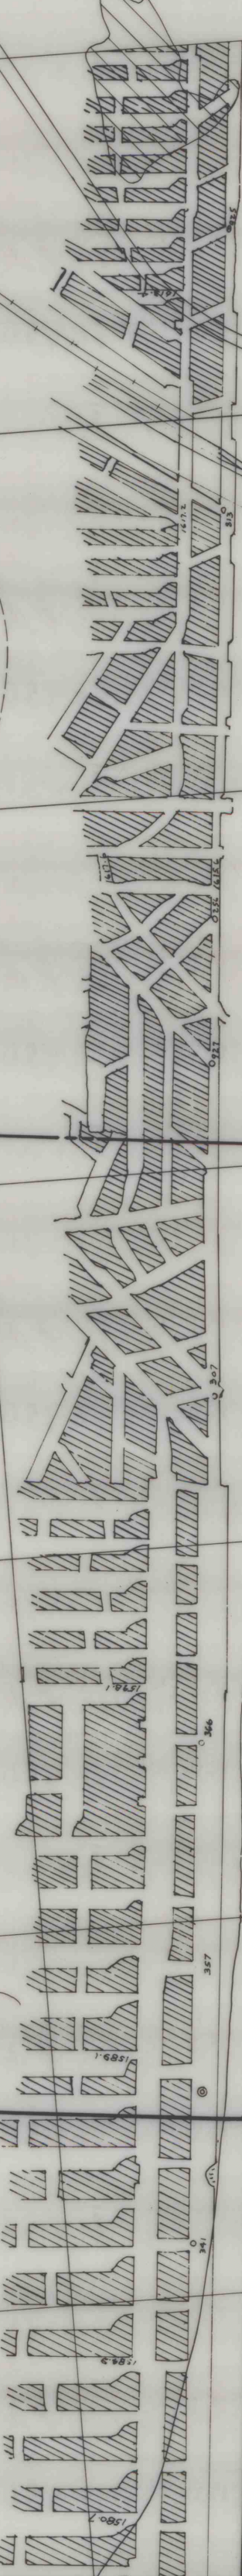

STERLING NO 6

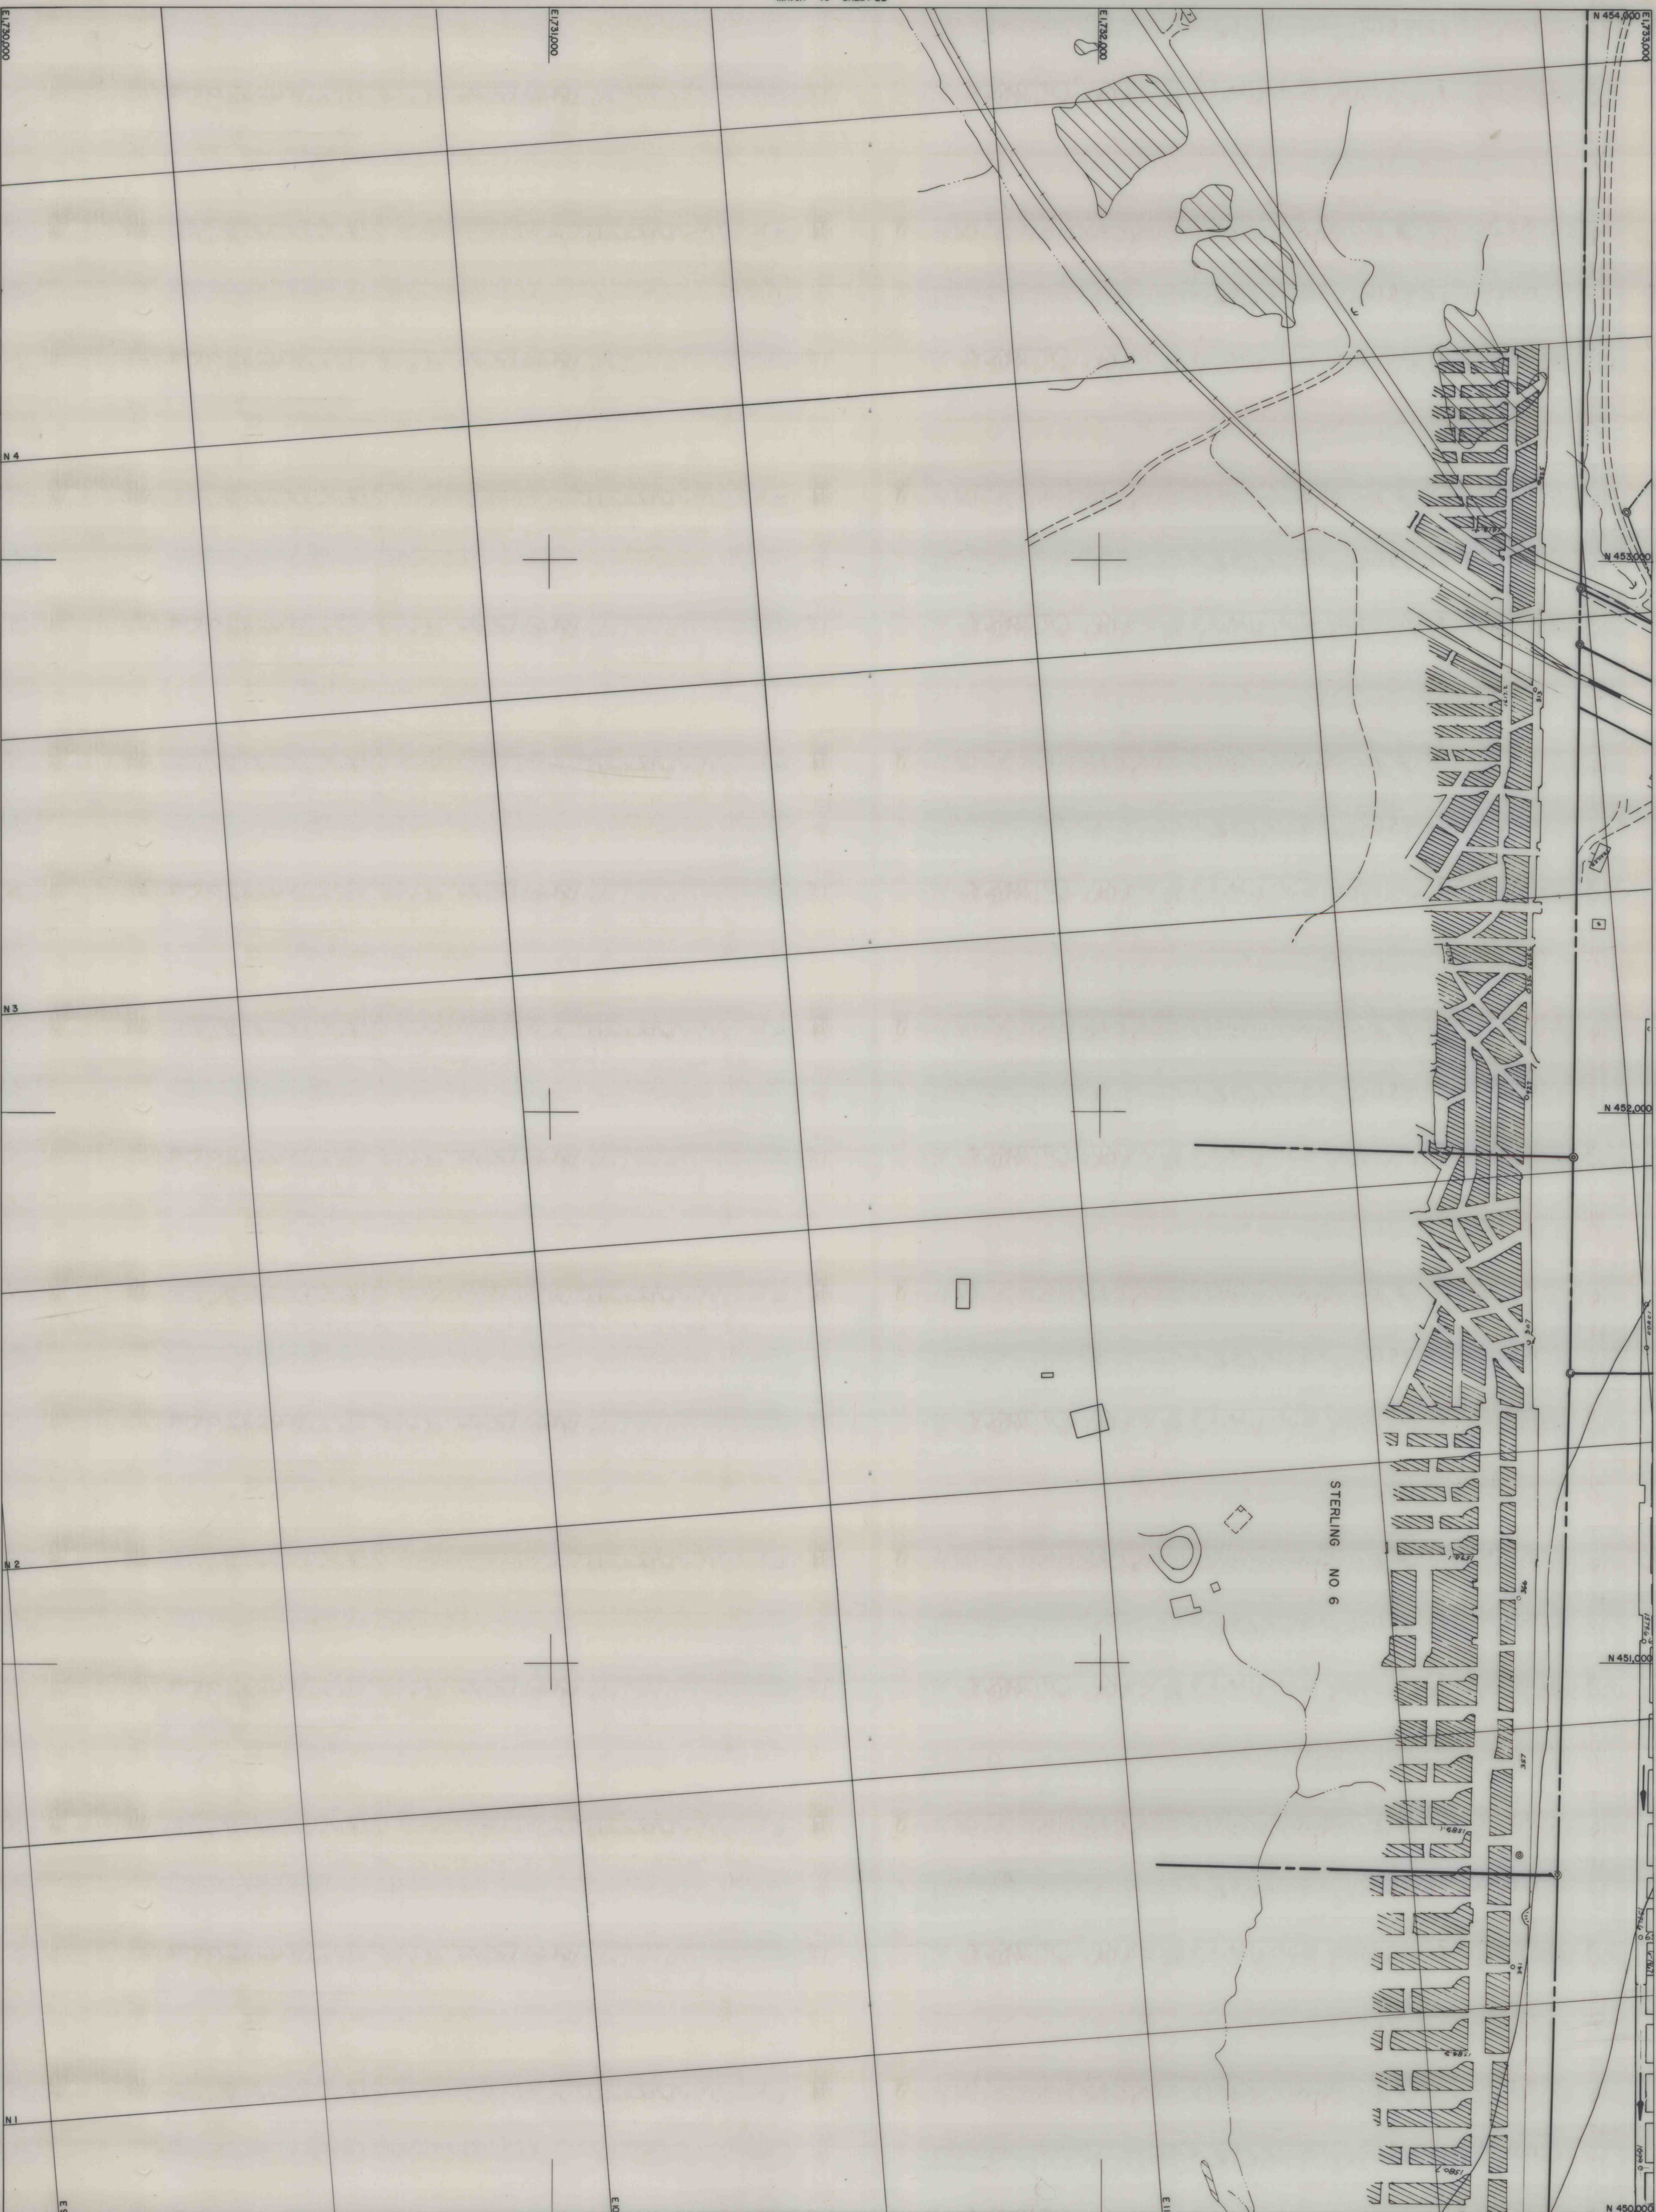

4421



BARNES & TUCKER COMPANY  
 LANCASTER NO. 20 MINE  
 EAST CARROLL TOWNSHIP, CAMBERIA COUNTY, PENNSYLVANIA  
 SCALE 1"=100'  
 DATE JULY, 1976

3B