


Inset Title:  
Southwestern extent of Mine Area #2

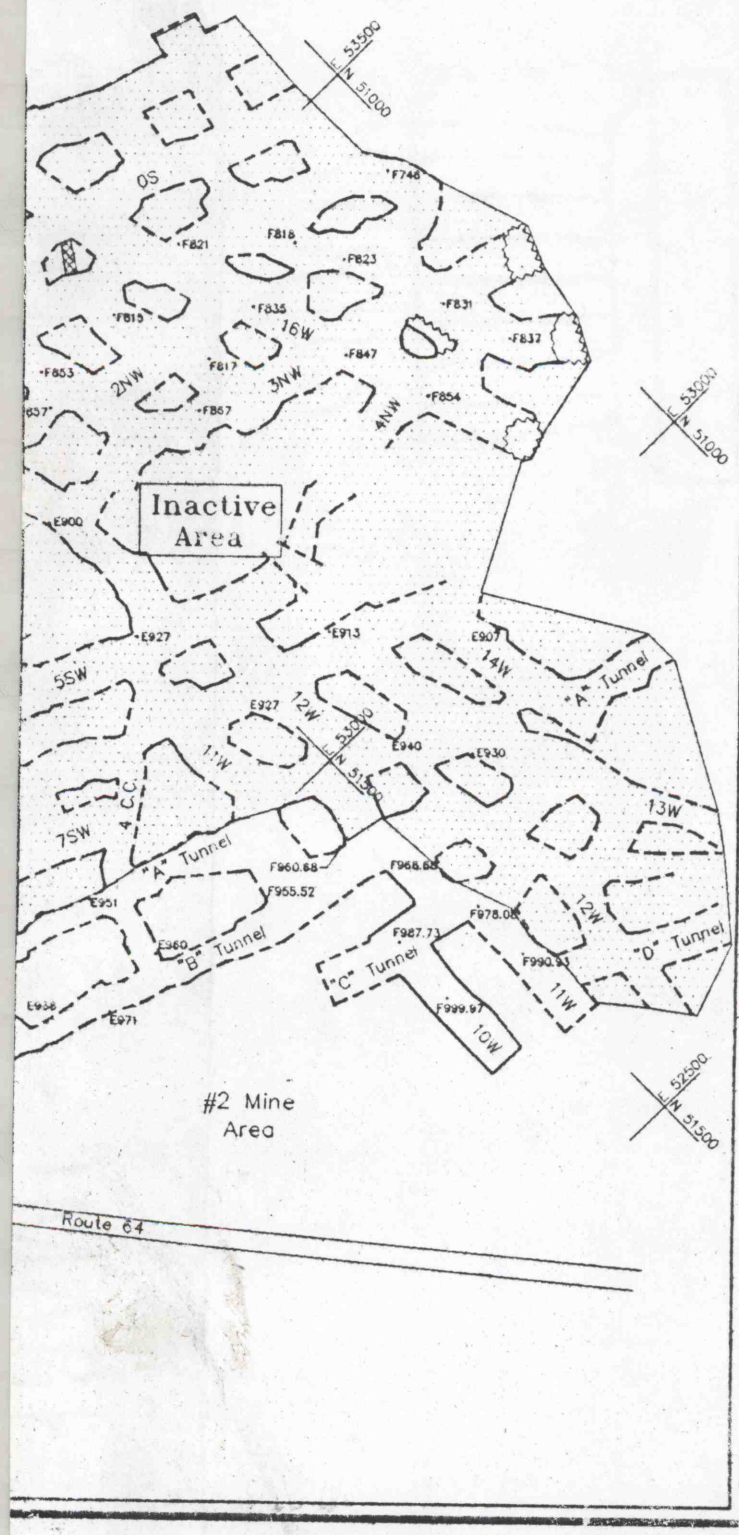

- Legend**
- historically surveyed area of the mine
  - - - projected extension of the mine
  - ▨ rubble
  - 14S heading
  - +7664.36 floor elevation (ft.AMSL)
  - +7333.00 roof elevation (ft.AMSL)
  - ▧ sump
  - inactive area
  - primary travelway
  - ⊞ shanty w/telephone
  - ⊞ existing brattice
  - evacuation alarm
  - ⊞ auxiliary fan/starter
  - ⊞ guardian angel
  - ⊞ communication node
  - \* face sample site

**Bellefonte Lime Company, Inc.**  
Spring Township, Centre County, PA

Limestone Mine - Combined Areas 1&2 and 5&6

J.W. Granville, Mine Superintendent

Drawn By: Lea Monaghan    Date: 3/30/98    Scale: 1"=200'

Revisions		No.	Date	By
Revisions		5	8/31/98	LM
Revisions		6	9/3/98	LM
Revisions		7	11/9/98	LM
Revisions		8	1/14/99	LM