

-1180-



-1170-

-1160-

-1150-

-1140-

-1130-

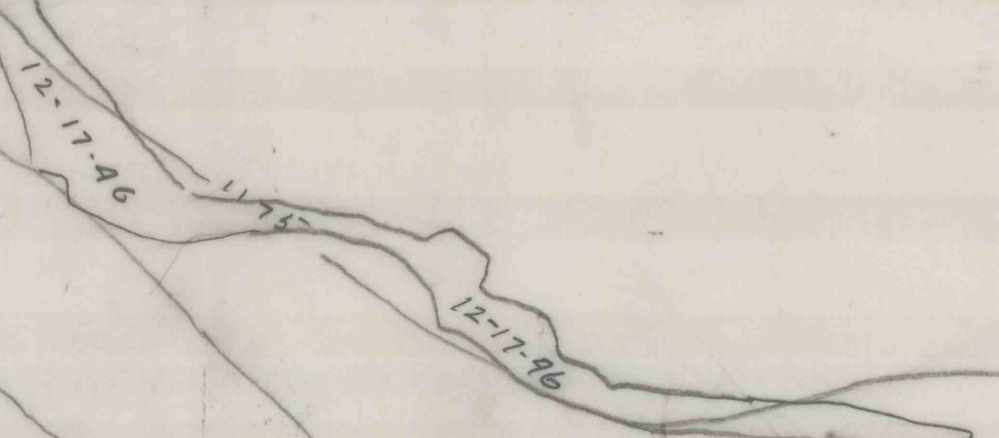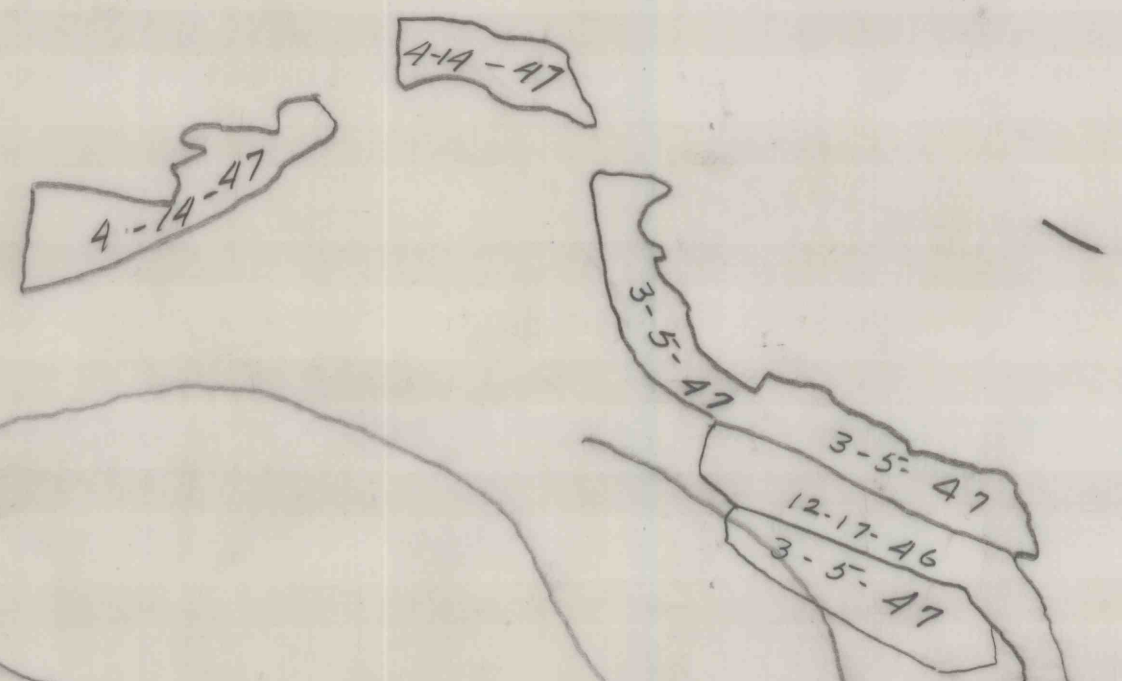

MAGADAMA ROAD

