


359

MONTOUR No. 9

LEASED TO PITTSBURGH MONTOUR No. 9

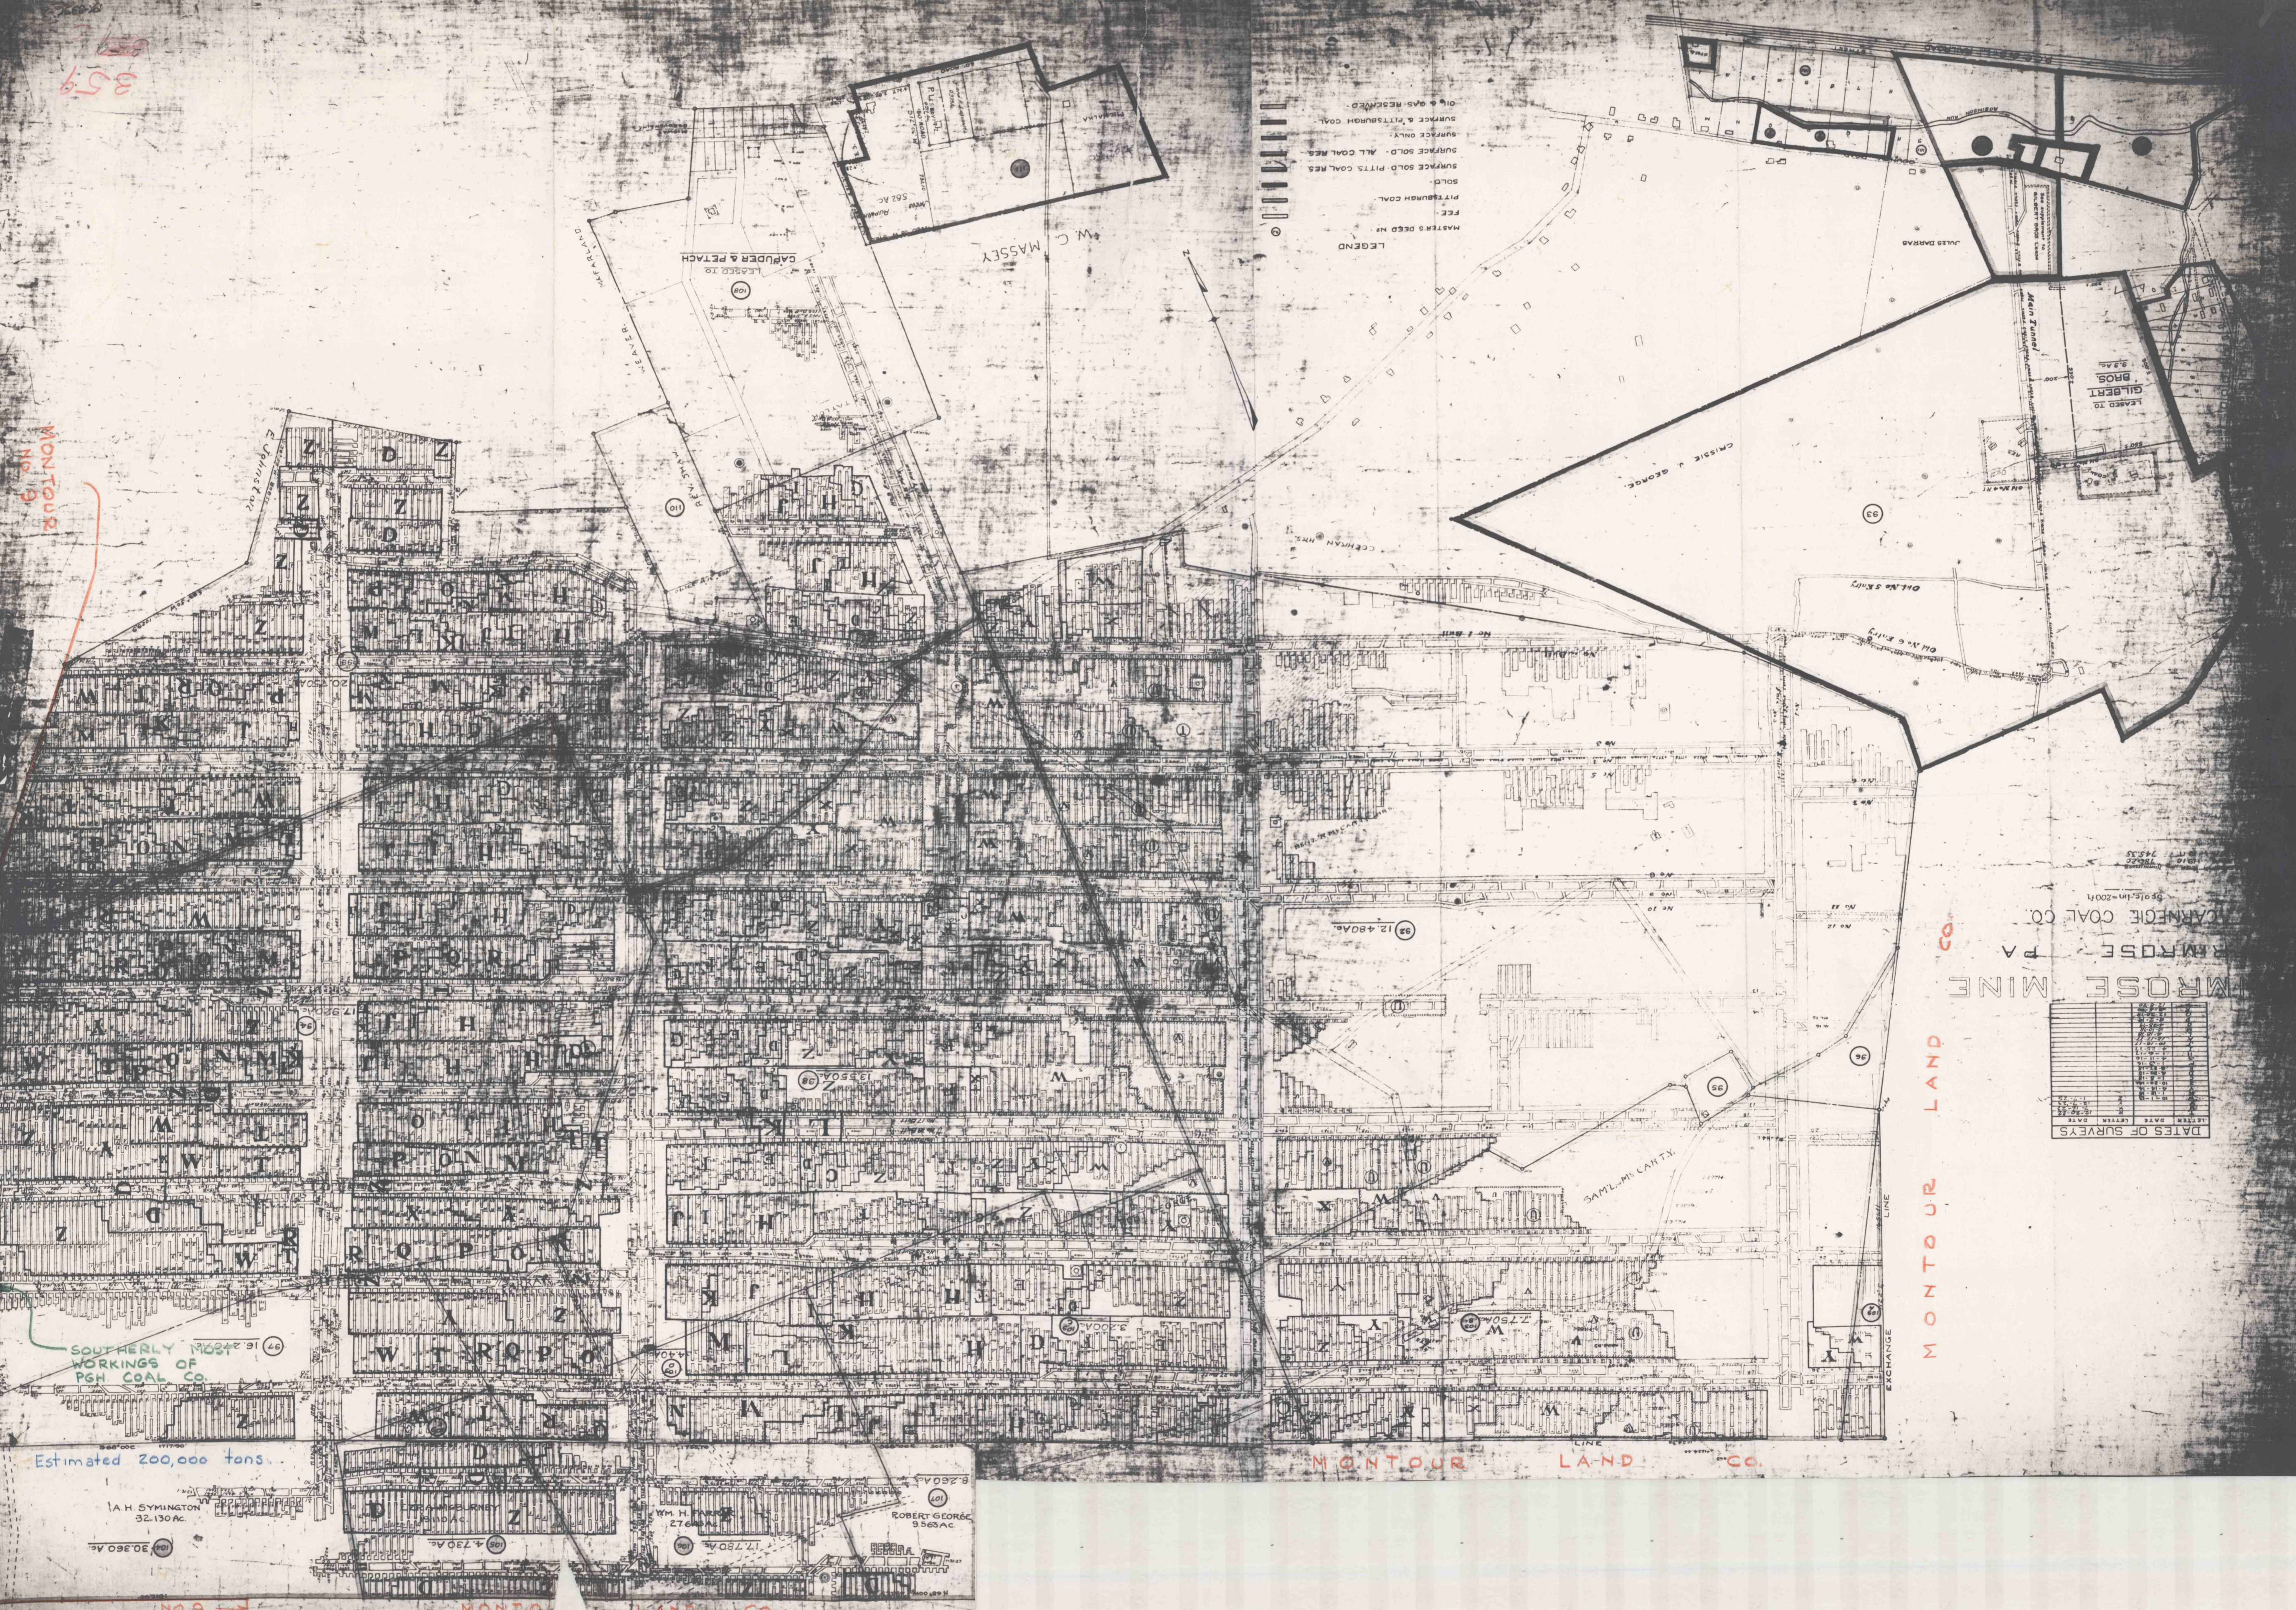

MONROSE MINE
ARMROSE PA
CARNegie COAL CO.

DATE	NO.
1882	1

Estimated 200,000 tons

A.H. SYMINGTON
32.130 AC

4.730 AC

W.M. HARRIS
27.6 AC

ROBERT GEORGE
9.563 AC

NO. 609

MONTOUR LAND CO.