

1"=200'  
SEAL PLAN FOR  
3RD SW BUTT


Seal 2 will be build first  
Seals 1 and 3 will be  
built simultaneously. Air  
flow will be provided to the  
work site.

Seals will be installed with  
a minimum distance of 10ft  
from rib to pillar corners.

Seals will be built as per  
30 CFR 75c335.

No. 3 will be the wet  
seals.

No. 2 seal will have the  
sampling tube.

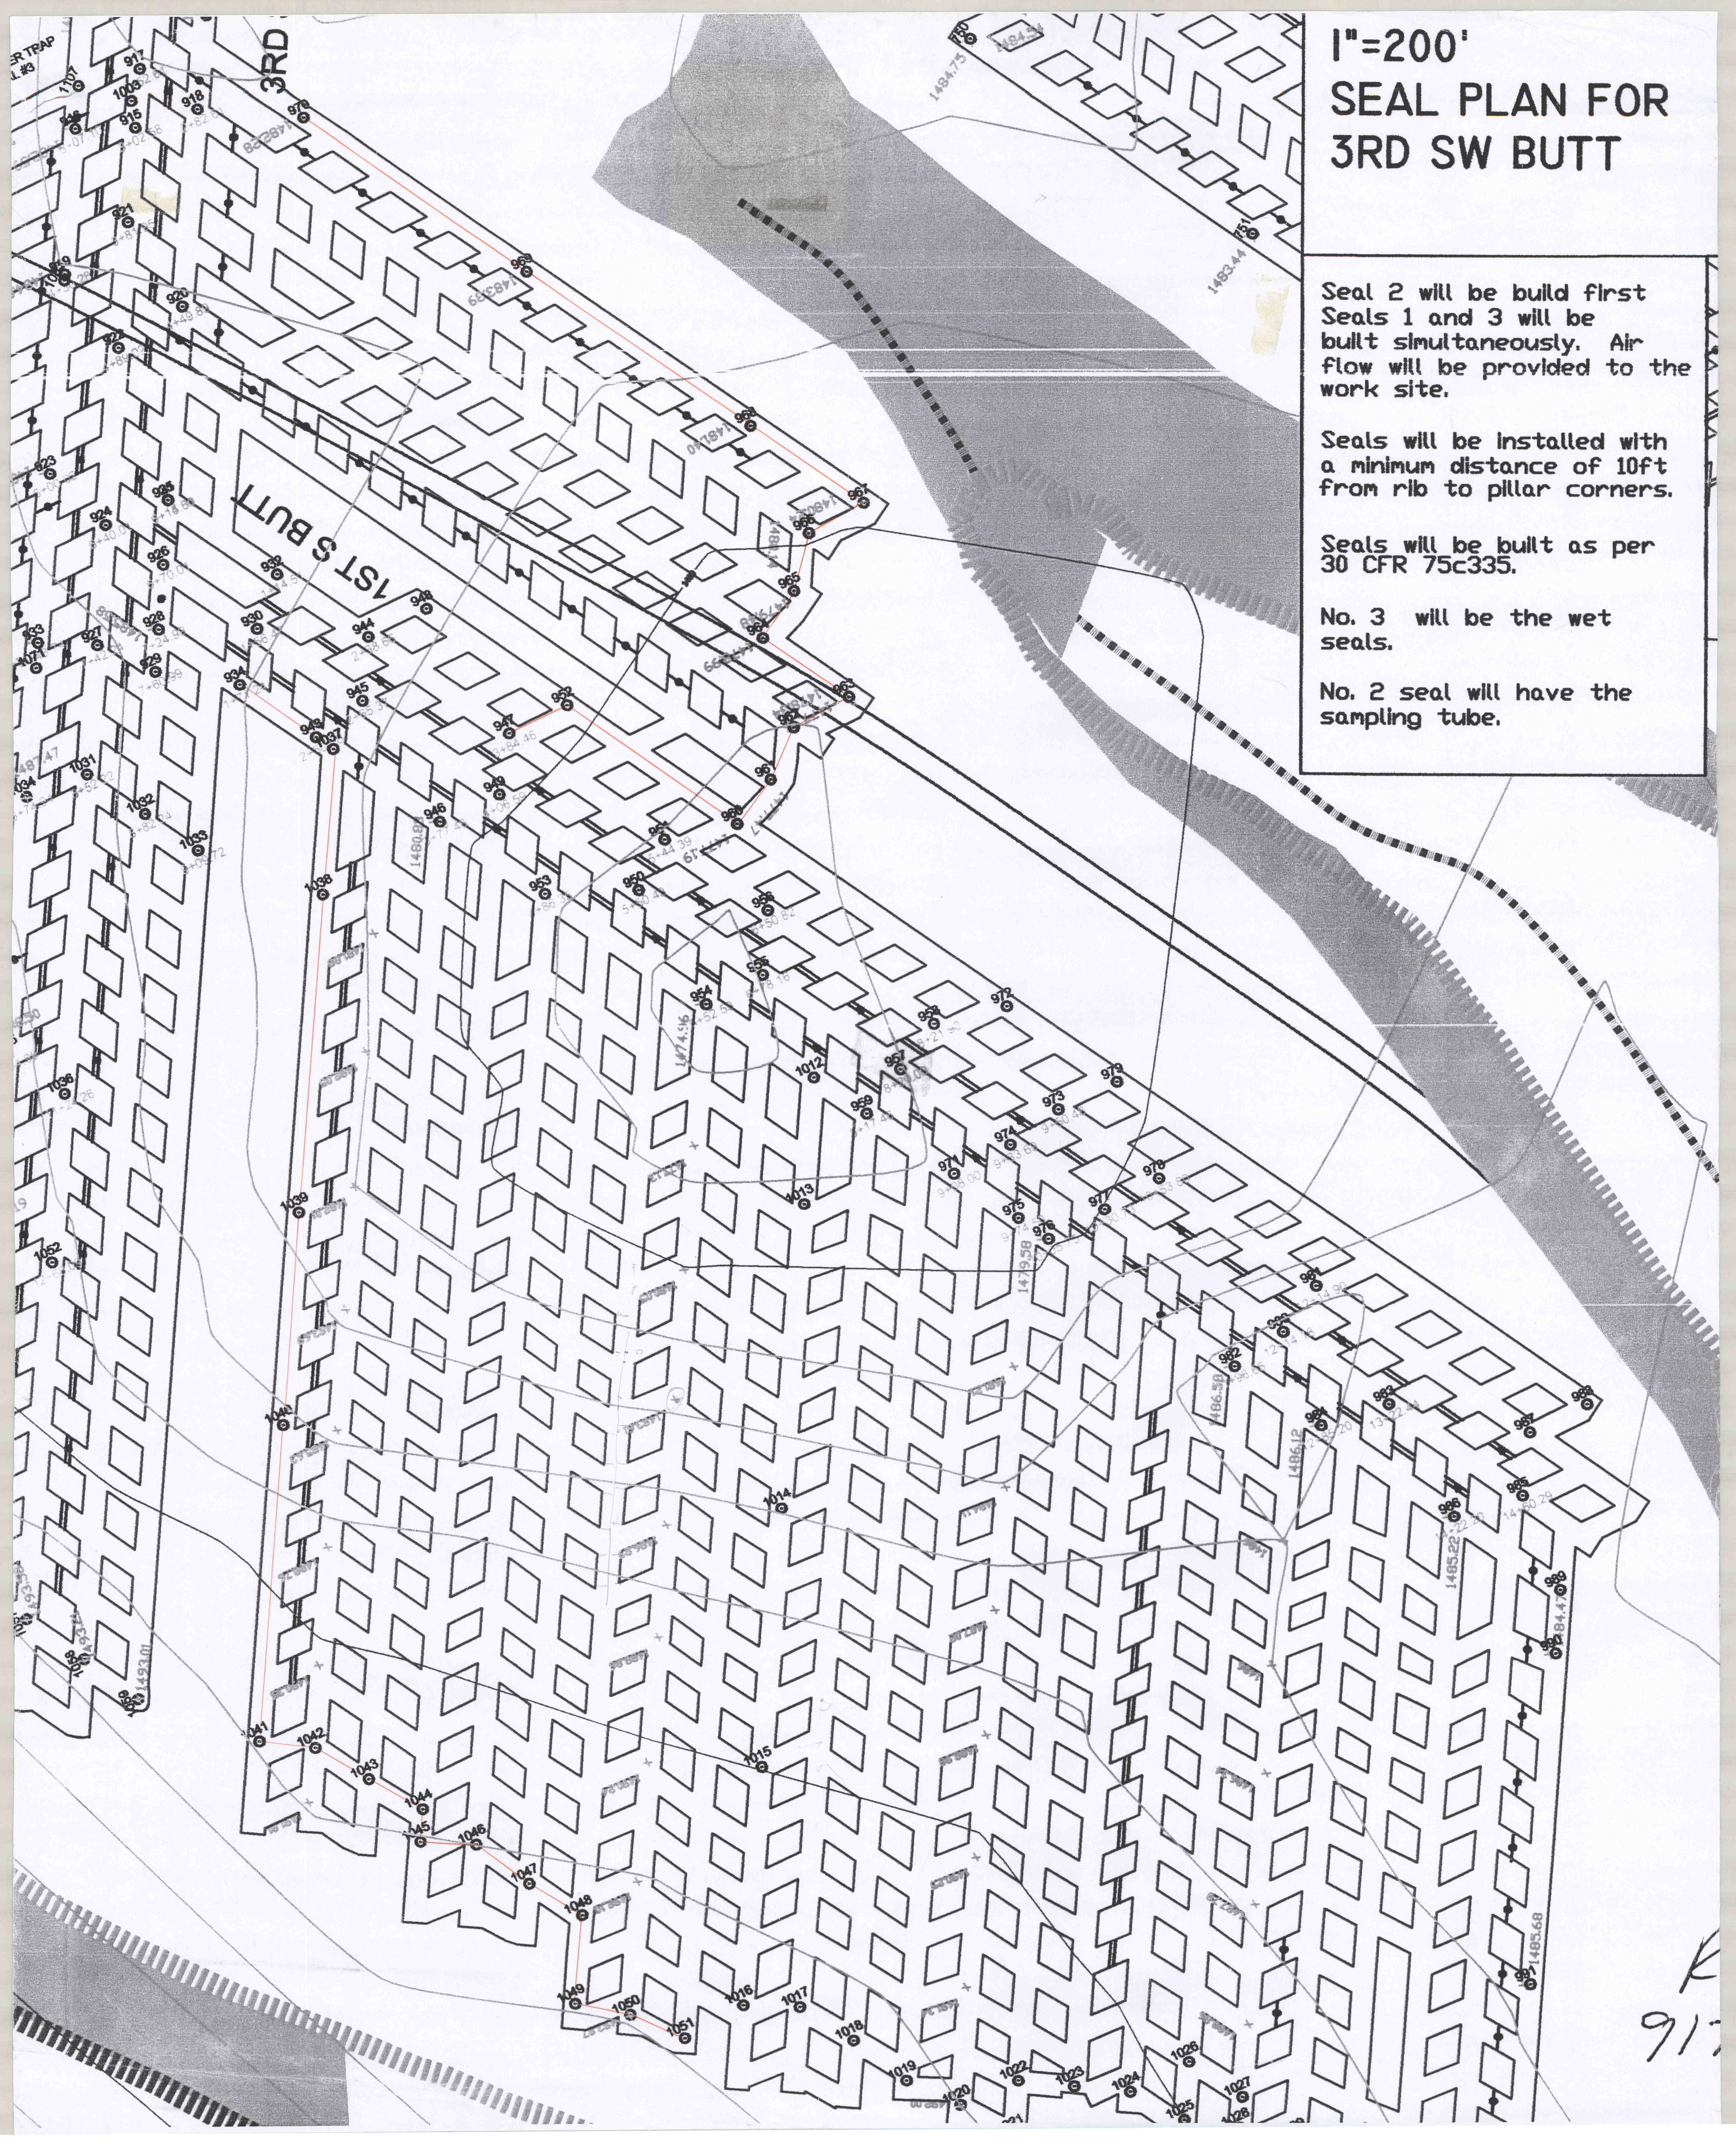

K  
9/1