


FIT TO DWG. 15

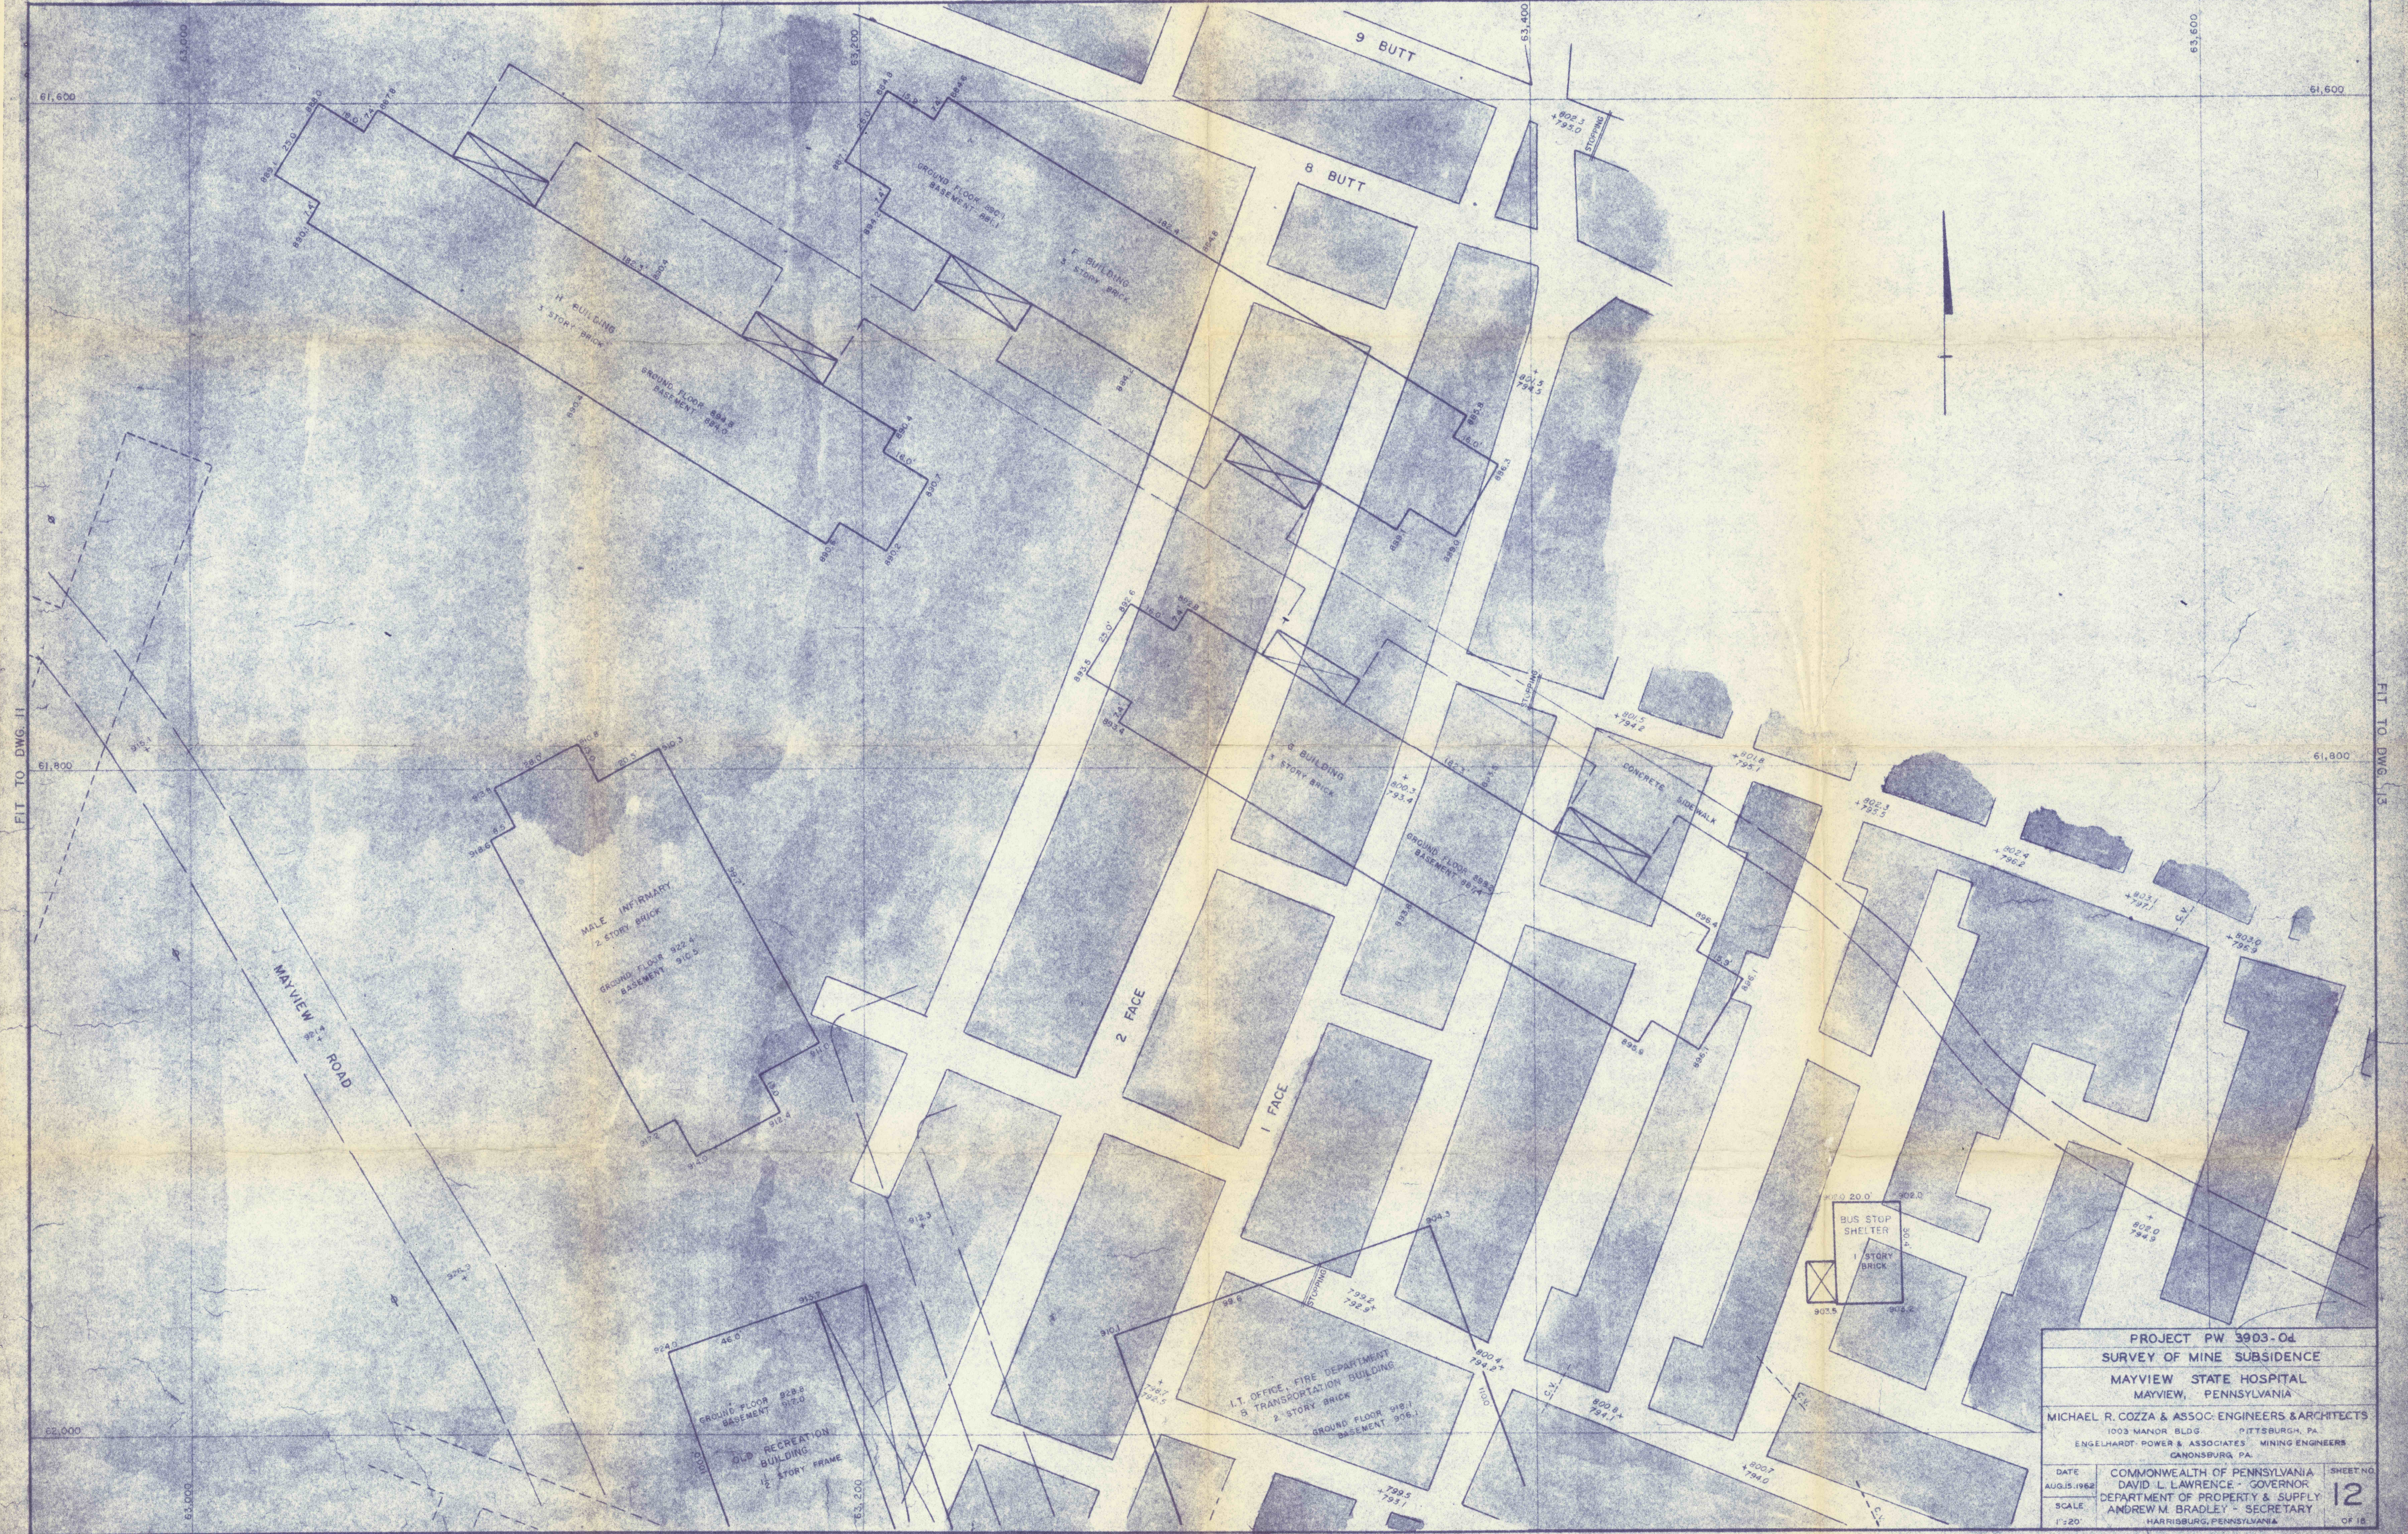

FIT TO DWG. 11

FIT TO DWG. 13

PROJECT PW 3903-0d	
SURVEY OF MINE SUBSIDENCE	
MAYVIEW STATE HOSPITAL MAYVIEW, PENNSYLVANIA	
MICHAEL R. COZZA & ASSOC. ENGINEERS & ARCHITECTS 1003 MANOR BLDG. PITTSBURGH, PA. ENGELHARDT POWER & ASSOCIATES MINING ENGINEERS CANONSBURG, PA.	
DATE AUG. 15, 1964	COMMONWEALTH OF PENNSYLVANIA DAVID L. LAWRENCE - GOVERNOR DEPARTMENT OF PROPERTY & SUPPLY ANDREW M. BRADLEY - SECRETARY HARRISBURG, PENNSYLVANIA
SCALE 1" = 20'	SHEET NO. 12 OF 18

COAL LEFT IN PLACE

FIT TO DWG. 8

108834-1