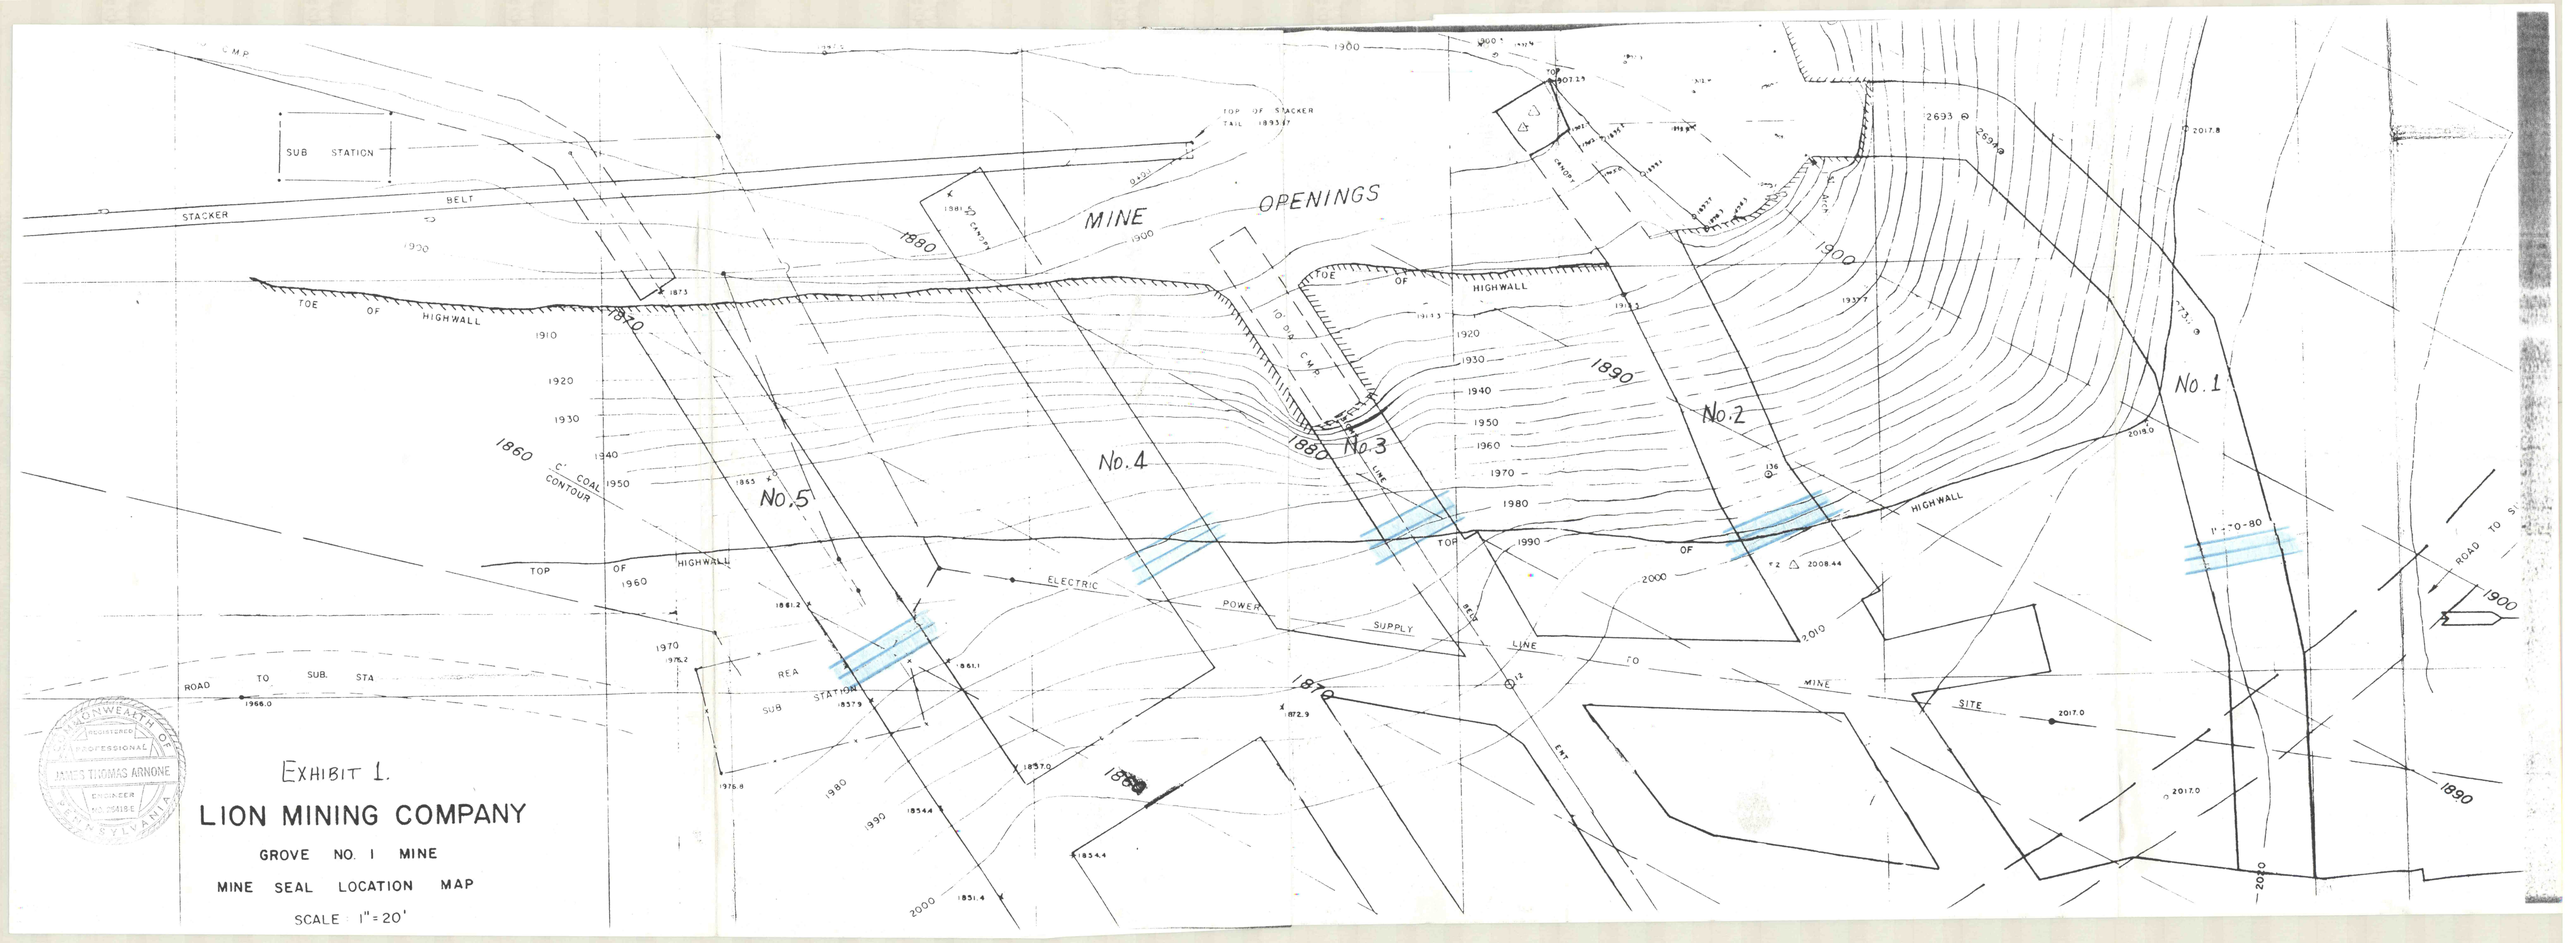

COMMONWEALTH OF PENNSYLVANIA
REGISTERED PROFESSIONAL
JAMES THOMAS ARNONE
ENGINEER
NO. 25185
PENNSYLVANIA

EXHIBIT 1.

LION MINING COMPANY

GROVE NO. 1 MINE

MINE SEAL LOCATION MAP

SCALE 1" = 20'