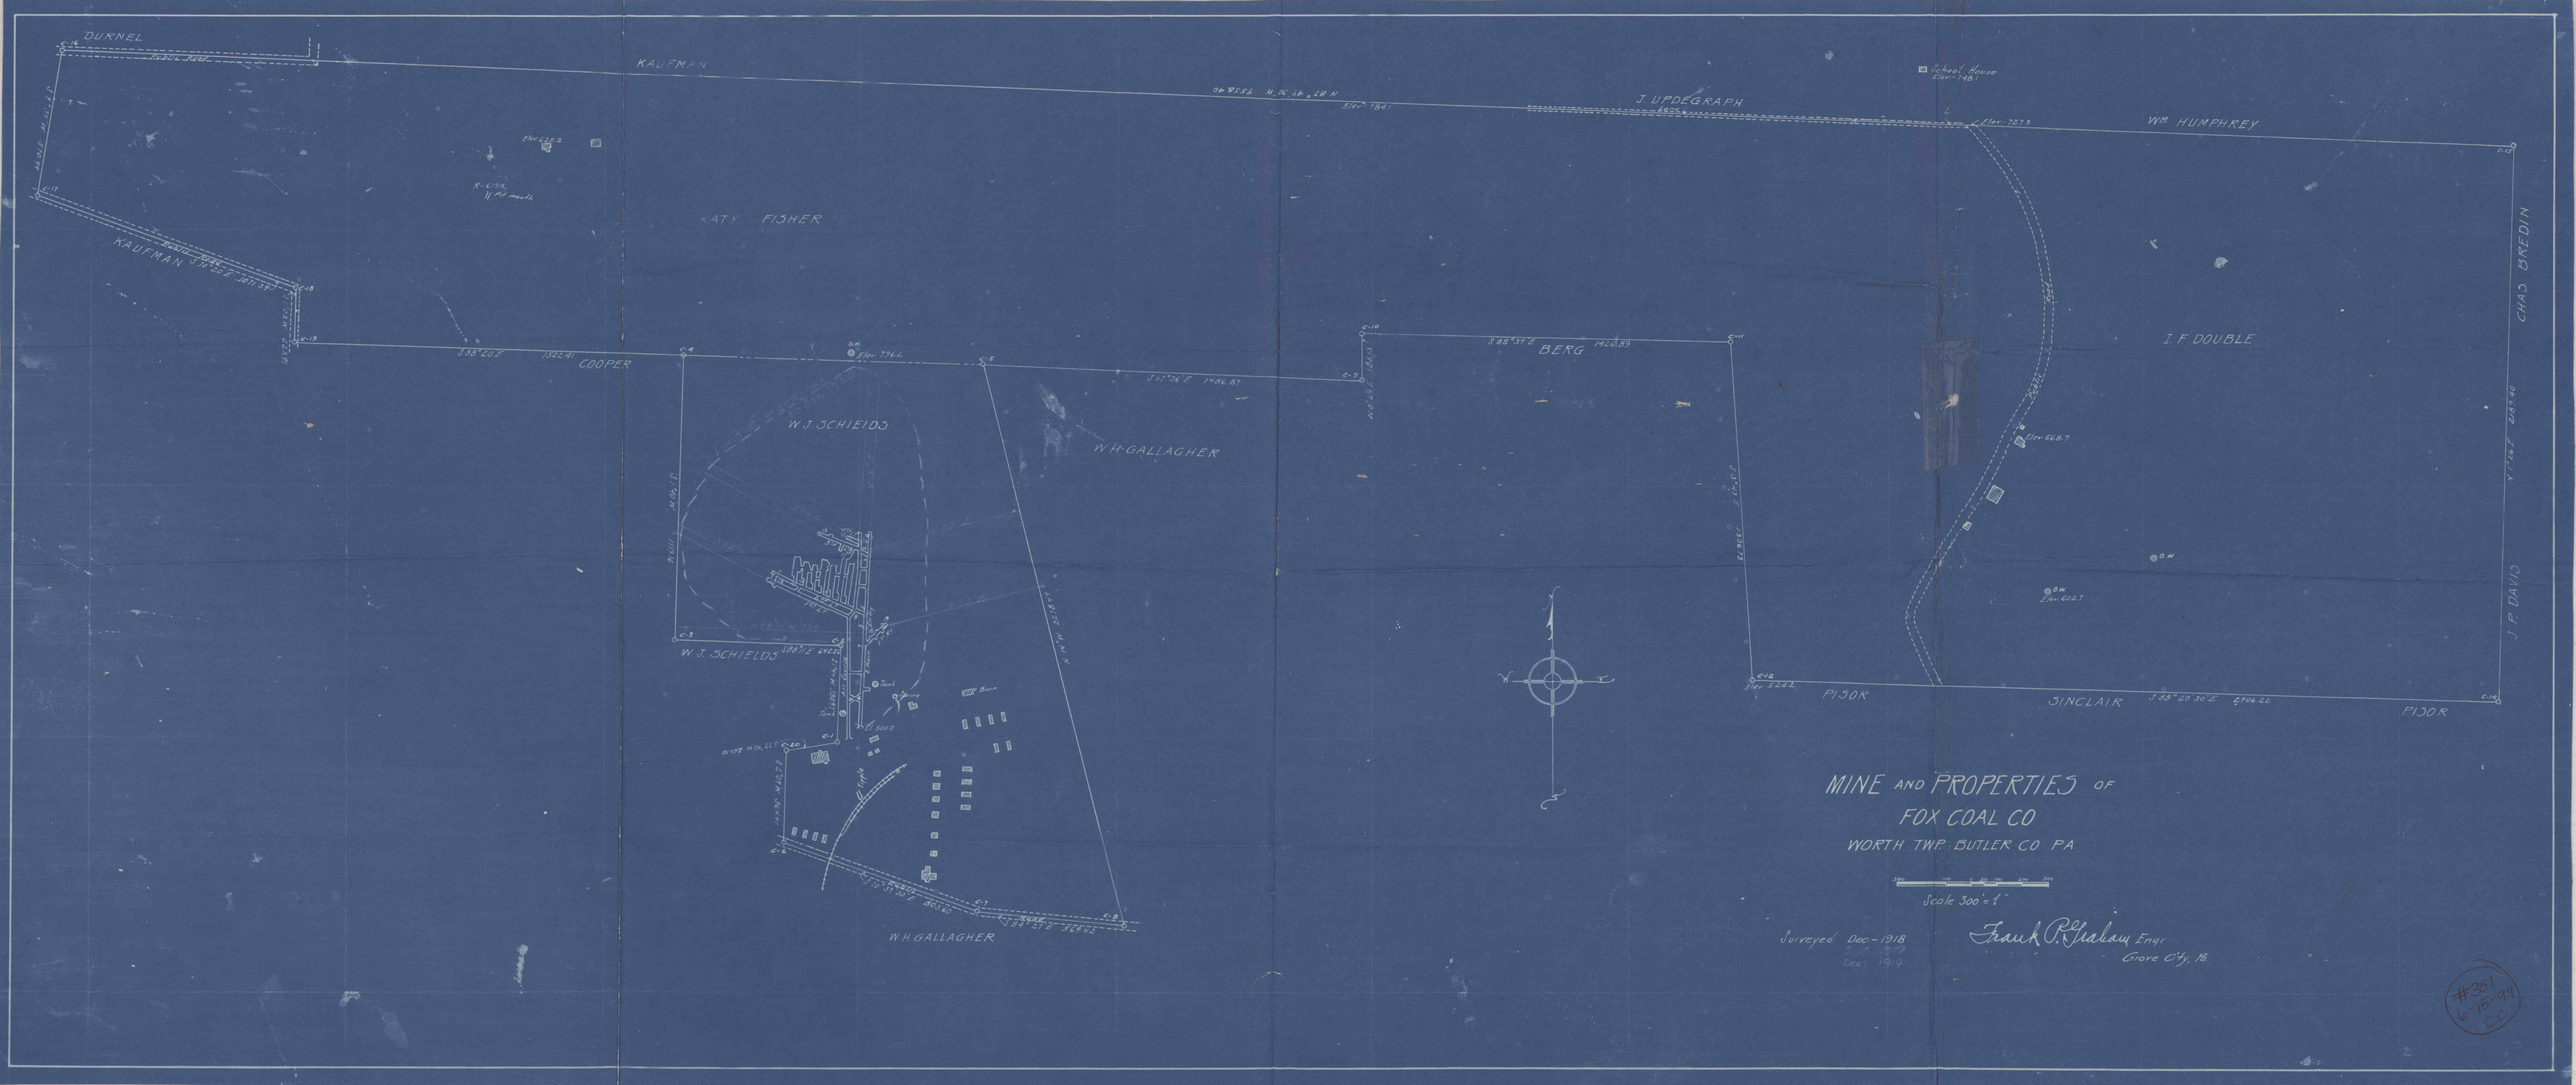
DURNEL
KAUFMAN
KATY FISHER
KAUFMAN
J. UPDEGRAPH
School House
Wm HUMPHREY
COOPER
W.J. SCHIELDS
W.H. GALLAGHER
BERG
I.F. DOUBLE
CHAS BREDIN
J.F. DAVIS
W.J. SCHIELDS
W.H. GALLAGHER
FIJOR
SINCLAIR
FIJOR
MINE AND PROPERTIES OF
FOX COAL CO
WORTH TWP. BUTLER CO PA
Scale 300' = 1"
Surveyed Dec-1918
Dec 1919
Frank R. Graham Engr
Grove City, Pa.