


Pasture Lines

584-48E

60  
60

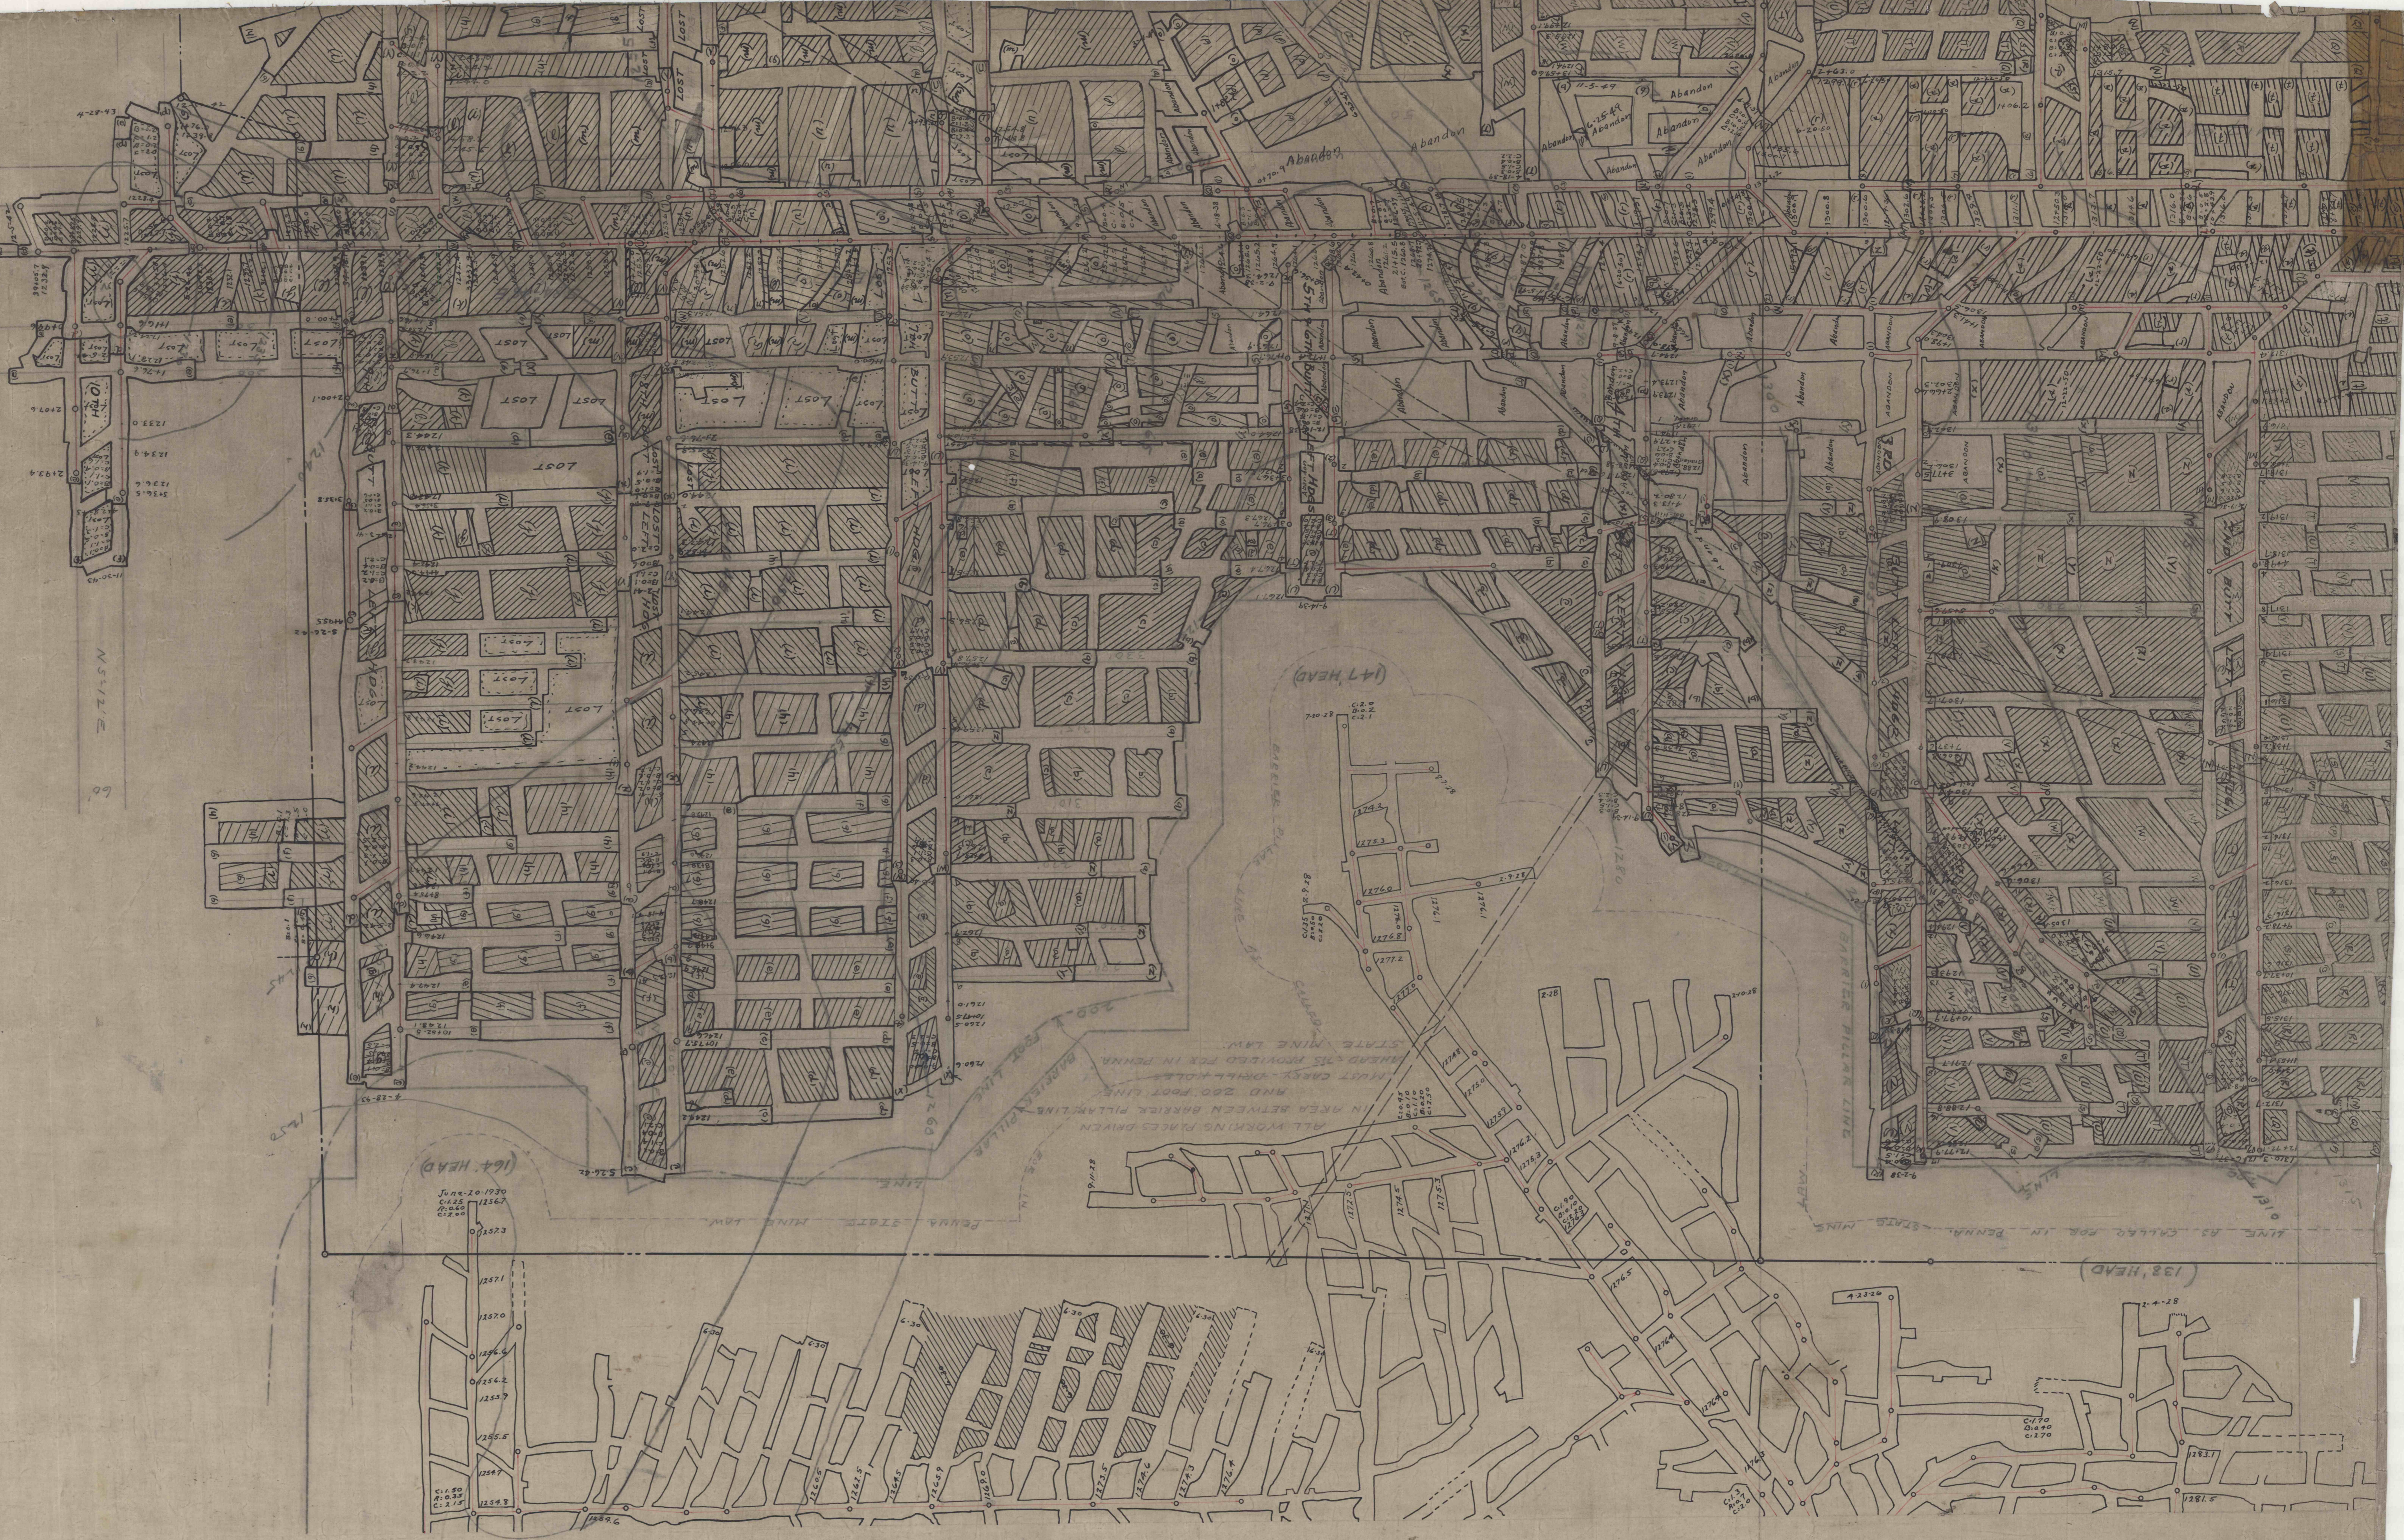

5 BLUE