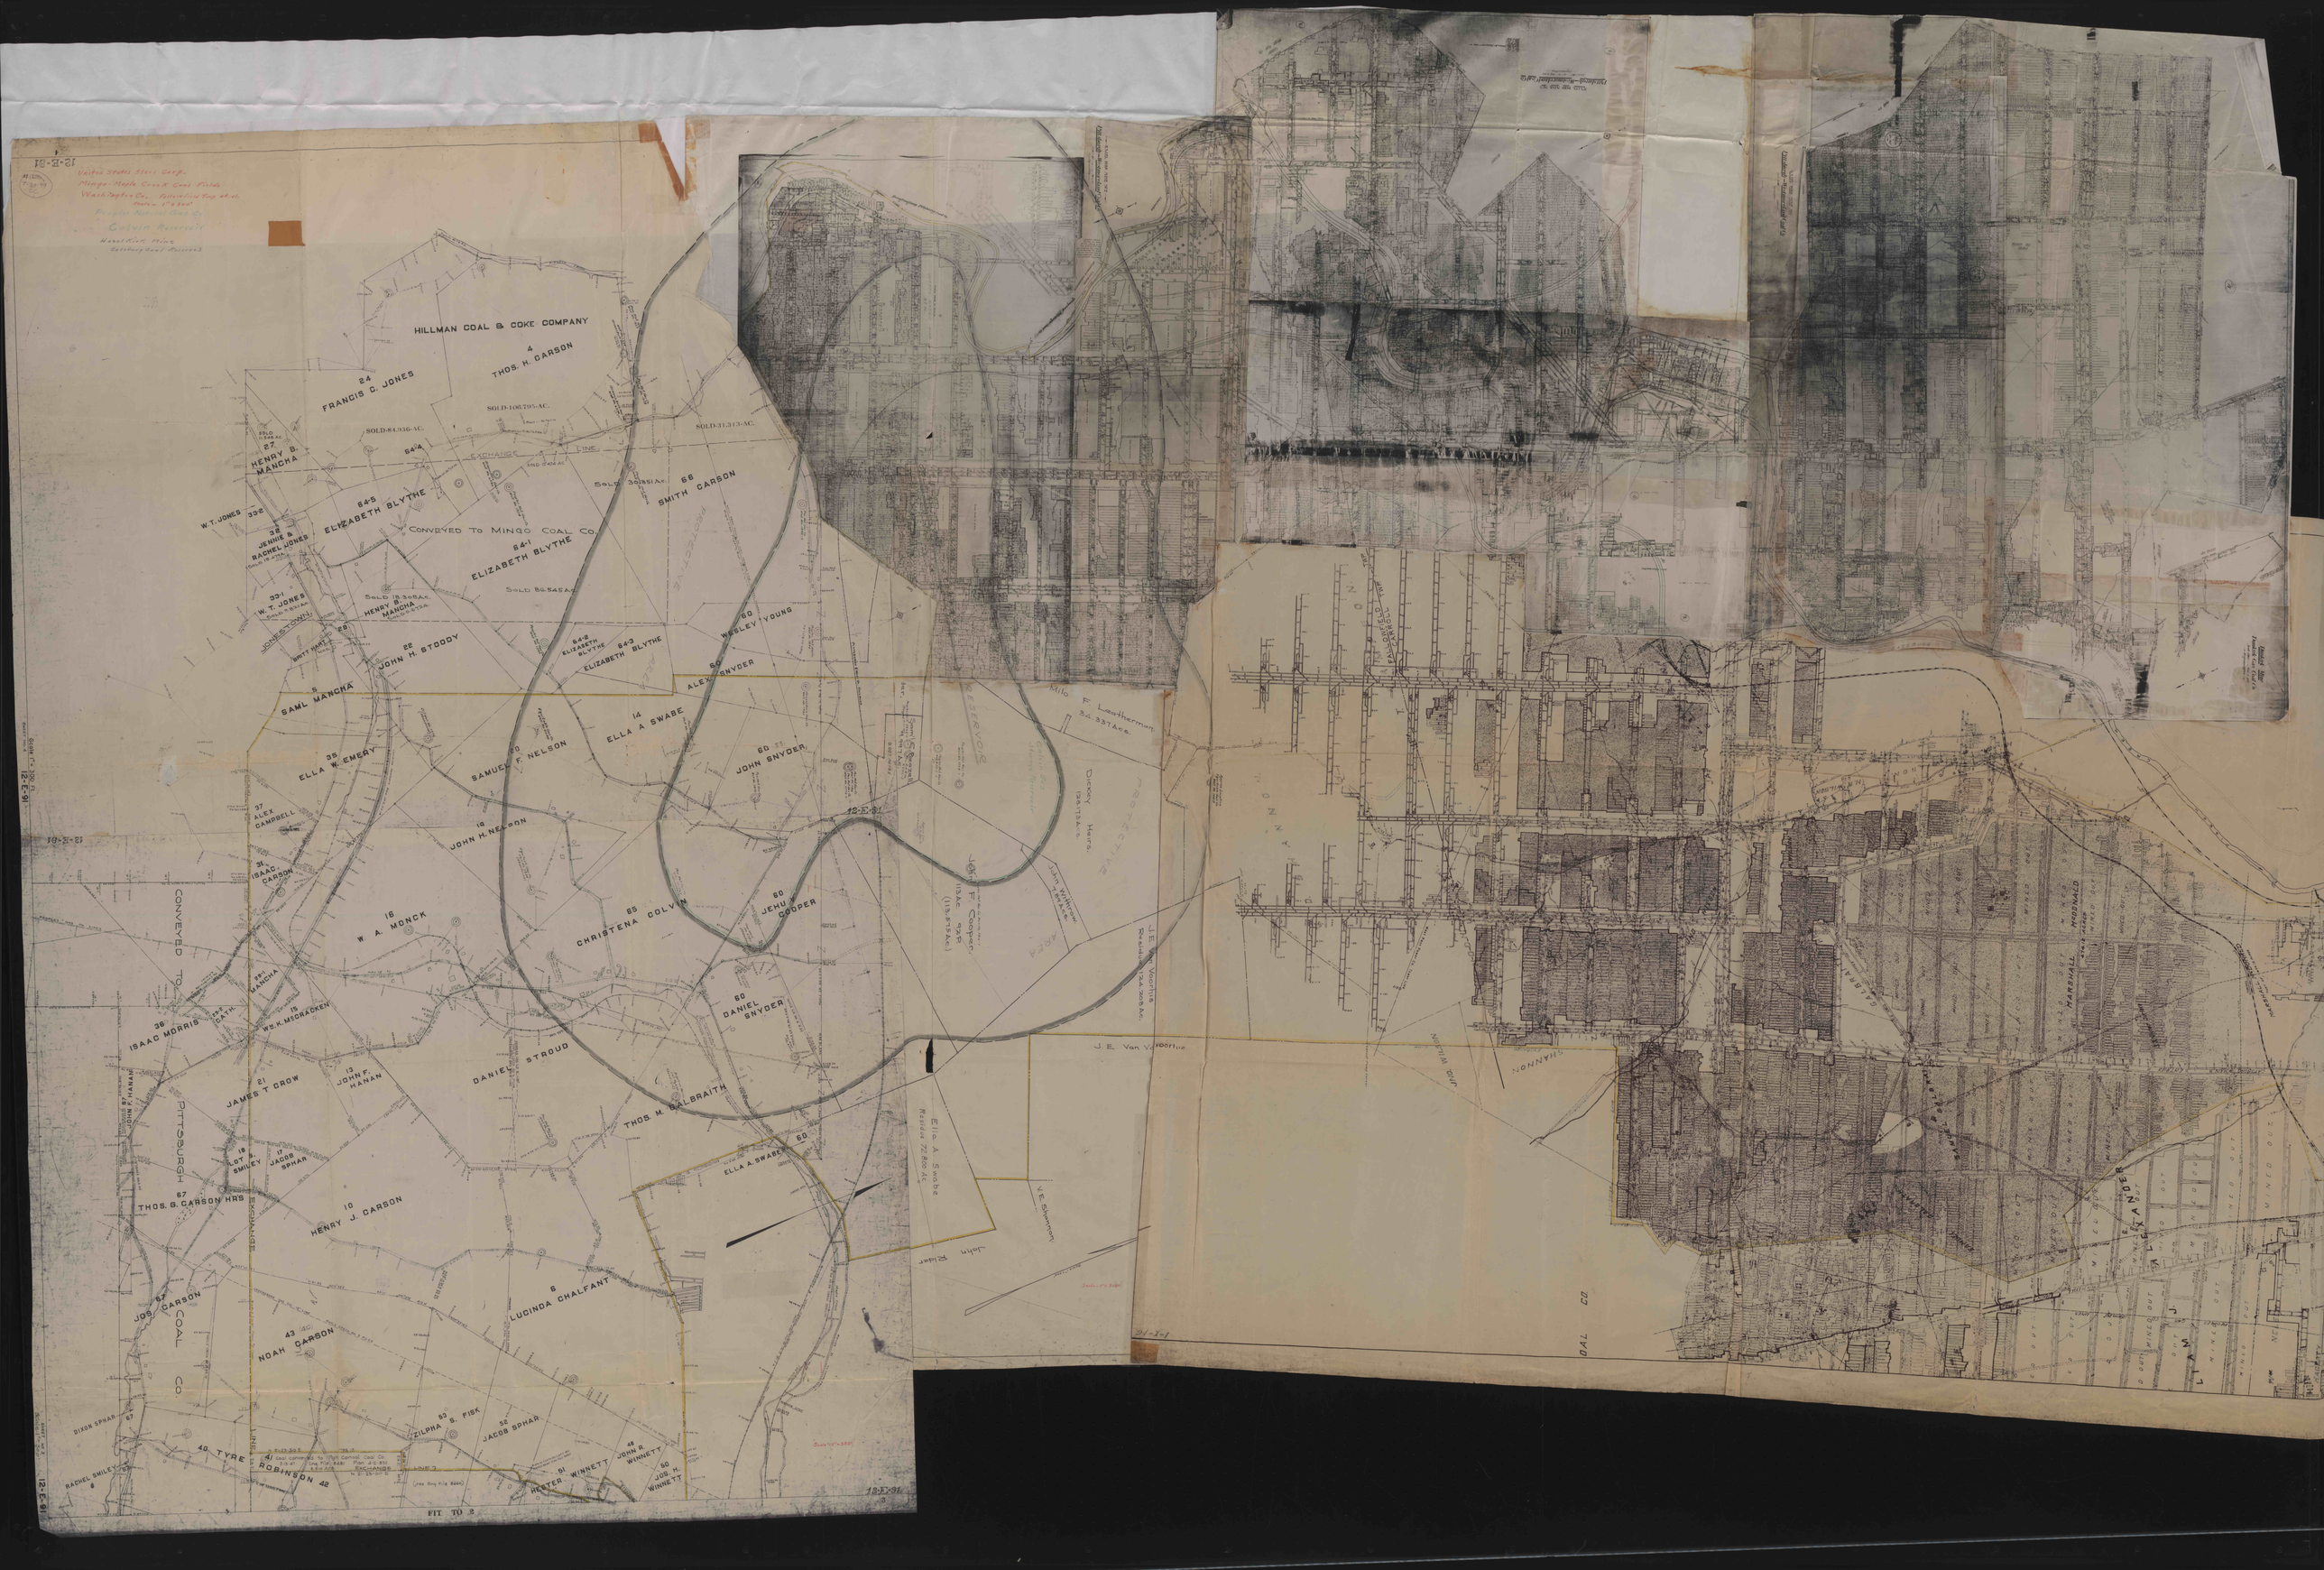
HILLMAN COAL & COKE COMPANY
THOS. H. CARSON
FRANCIS C. JONES
HENRY B. MANCHA
ELIZABETH BLYTHE
CONVEYED TO MINGO COAL CO.
SMITH CARSON
W. T. JONES
JENNIE & RACHEL JONES
JOHN H. STOODY
SAML MANCHA
ELLA W. EMERY
SAMUEL T. NELSON
ELLA A SWABE
JOHN SNYDER
WESLEY YOUNG
ALEX SNYDER
JOHN H. NELSON
W. A. MONCK
CHRISTENA COLVIN
JEHU COOPER
DANIEL SNYDER
ISAAC MORRIS
DANIEL STROUD
JAMES T. CROW
JOHN F. HANAN
THOS. M. GALBRAITH
THOS. G. CARSON HRS
HENRY J CARSON
LUCINDA CHALFANT
JOS. CARSON COAL CO.
NOAH CARSON
TYRE ROBINSON
ZILPHA S. FISK
JACOB SPHAR
REUBEN WINNETT
JOHN R. WINNETT
JOS. H. WINNETT
PITTSBURGH
CONVEYED TO
Milo F. Leatherman
Dicky Heirs
J. E. Van Voorhis
Ella A. Swabe
J. E. Shannon
SHANNON
MARSHALL
FRANKLIN
GAL CO