


SHEET NO. 4

SHEET NO. 3

BLACKBYE COAL CO

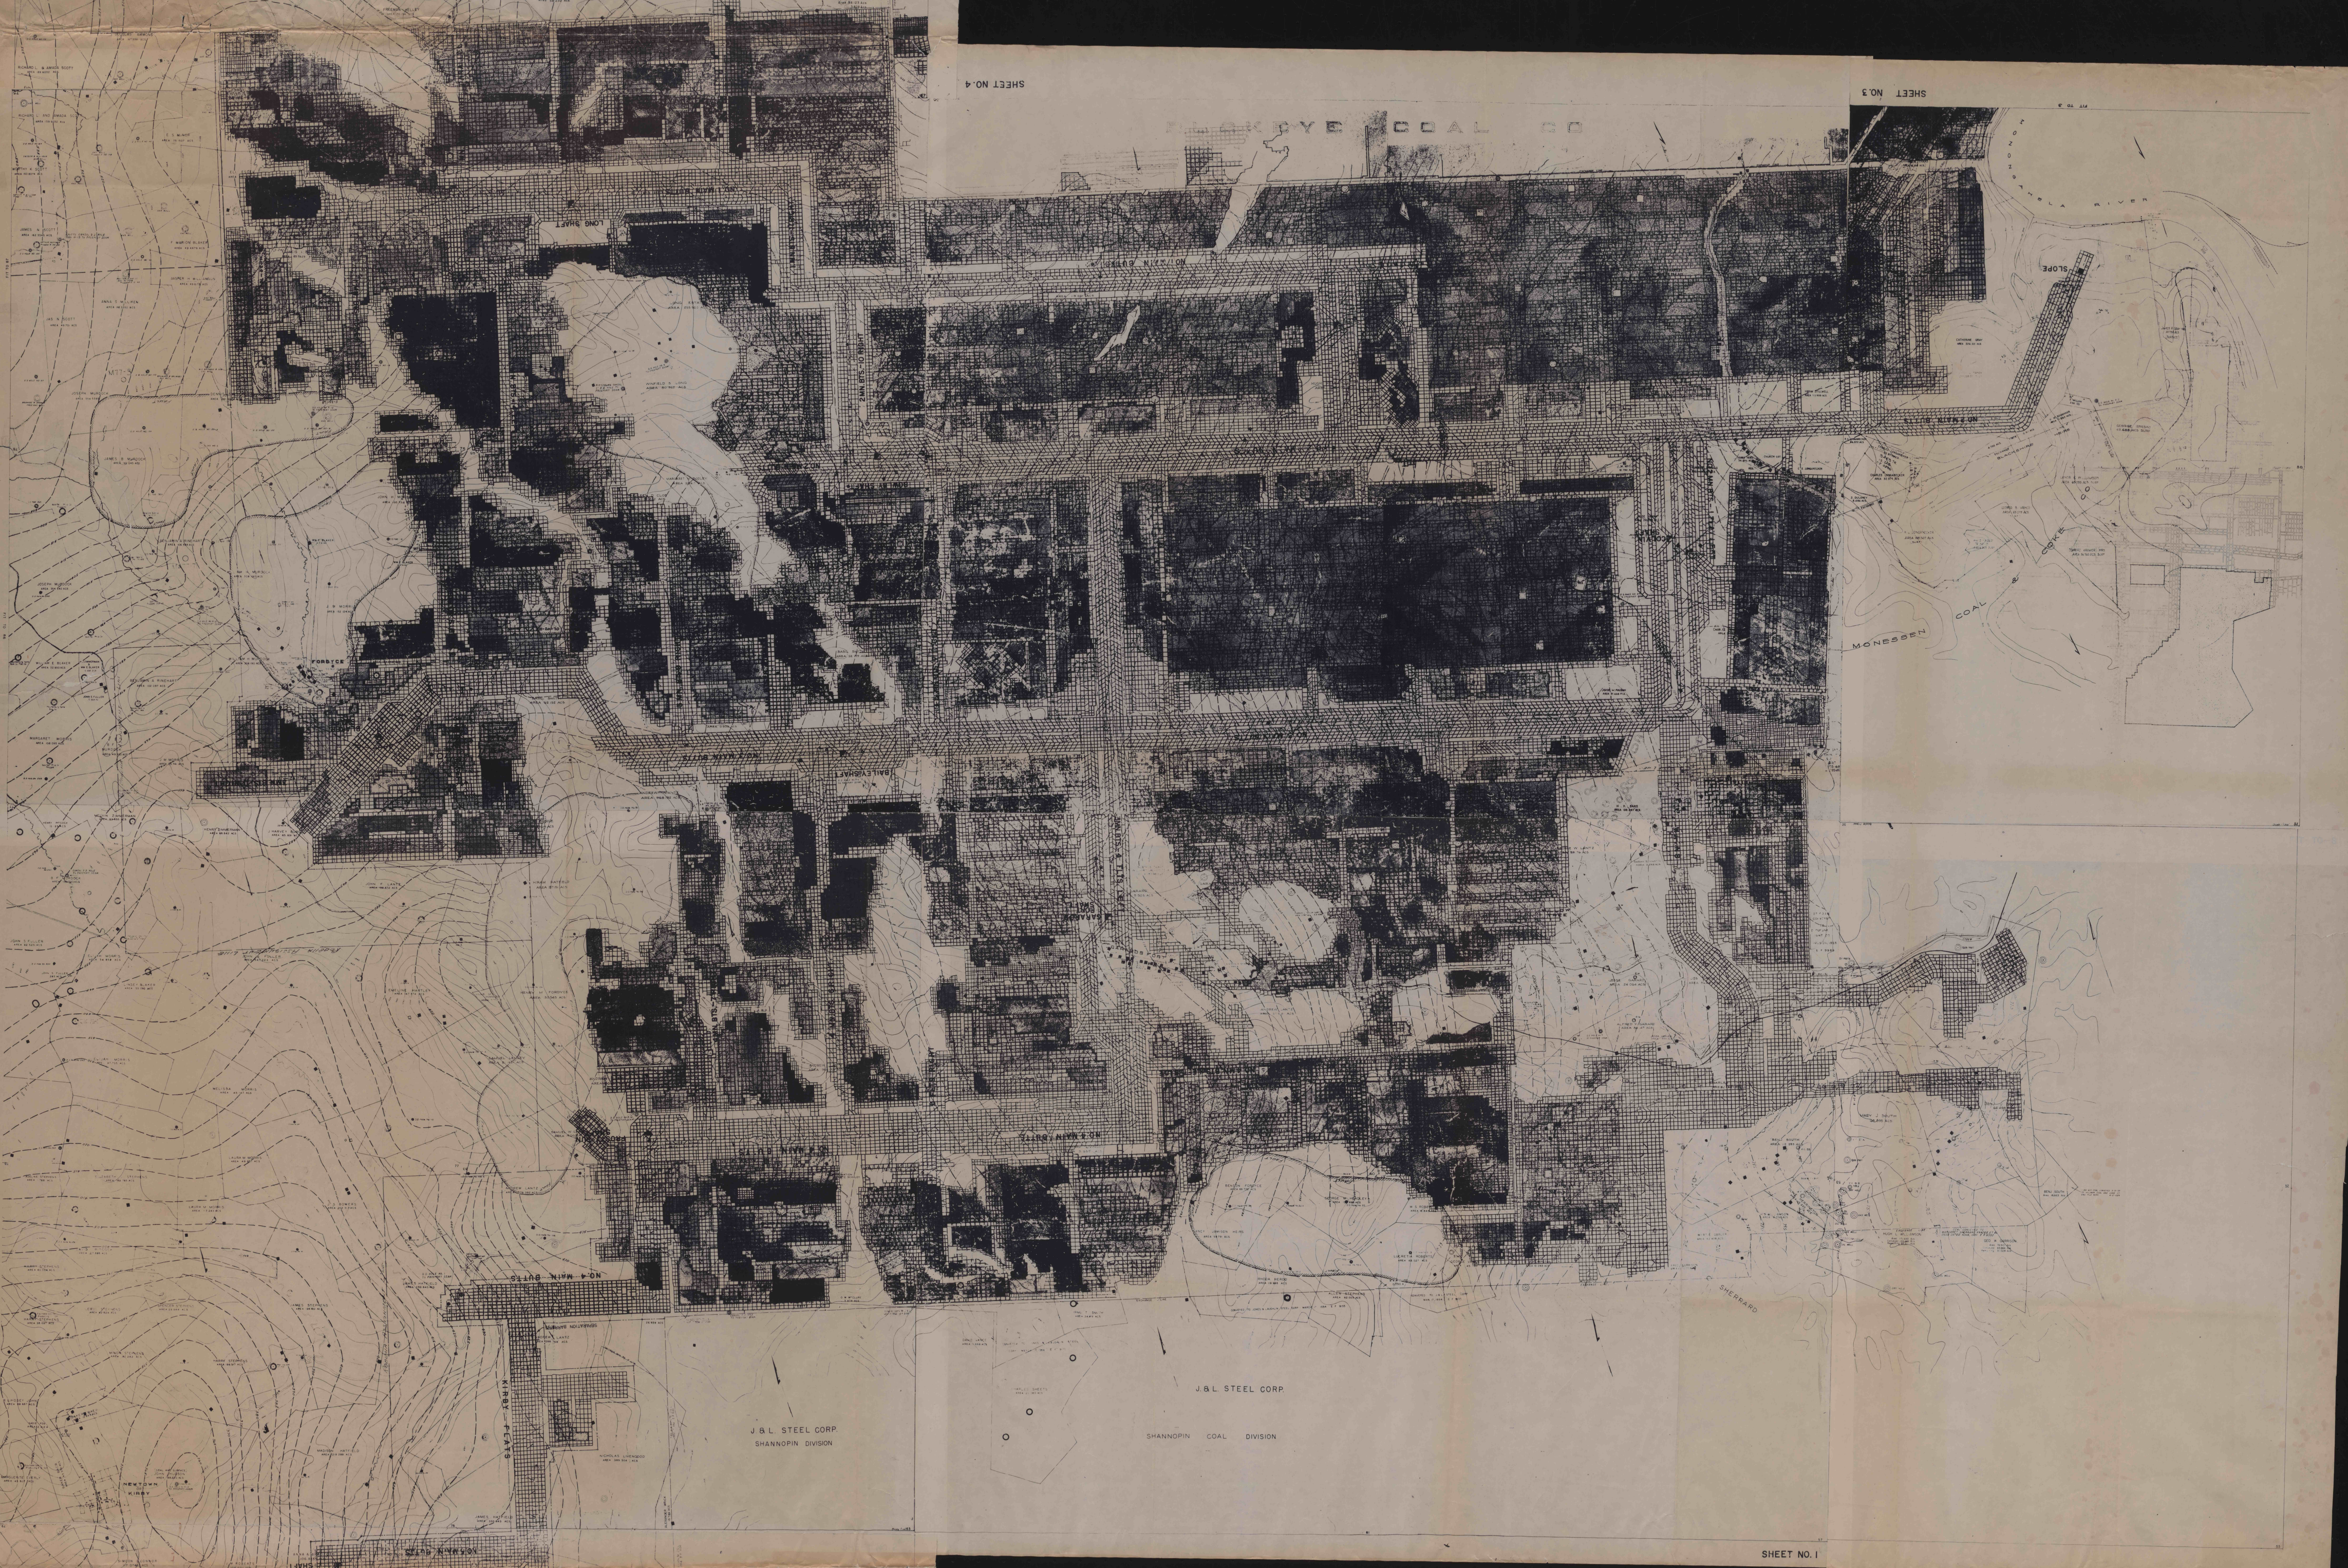

J. & L. STEEL CORP.  
SHANNOPIN DIVISION

J. & L. STEEL CORP.  
SHANNOPIN COAL DIVISION

SHEET NO. 1