


BUCKEYE

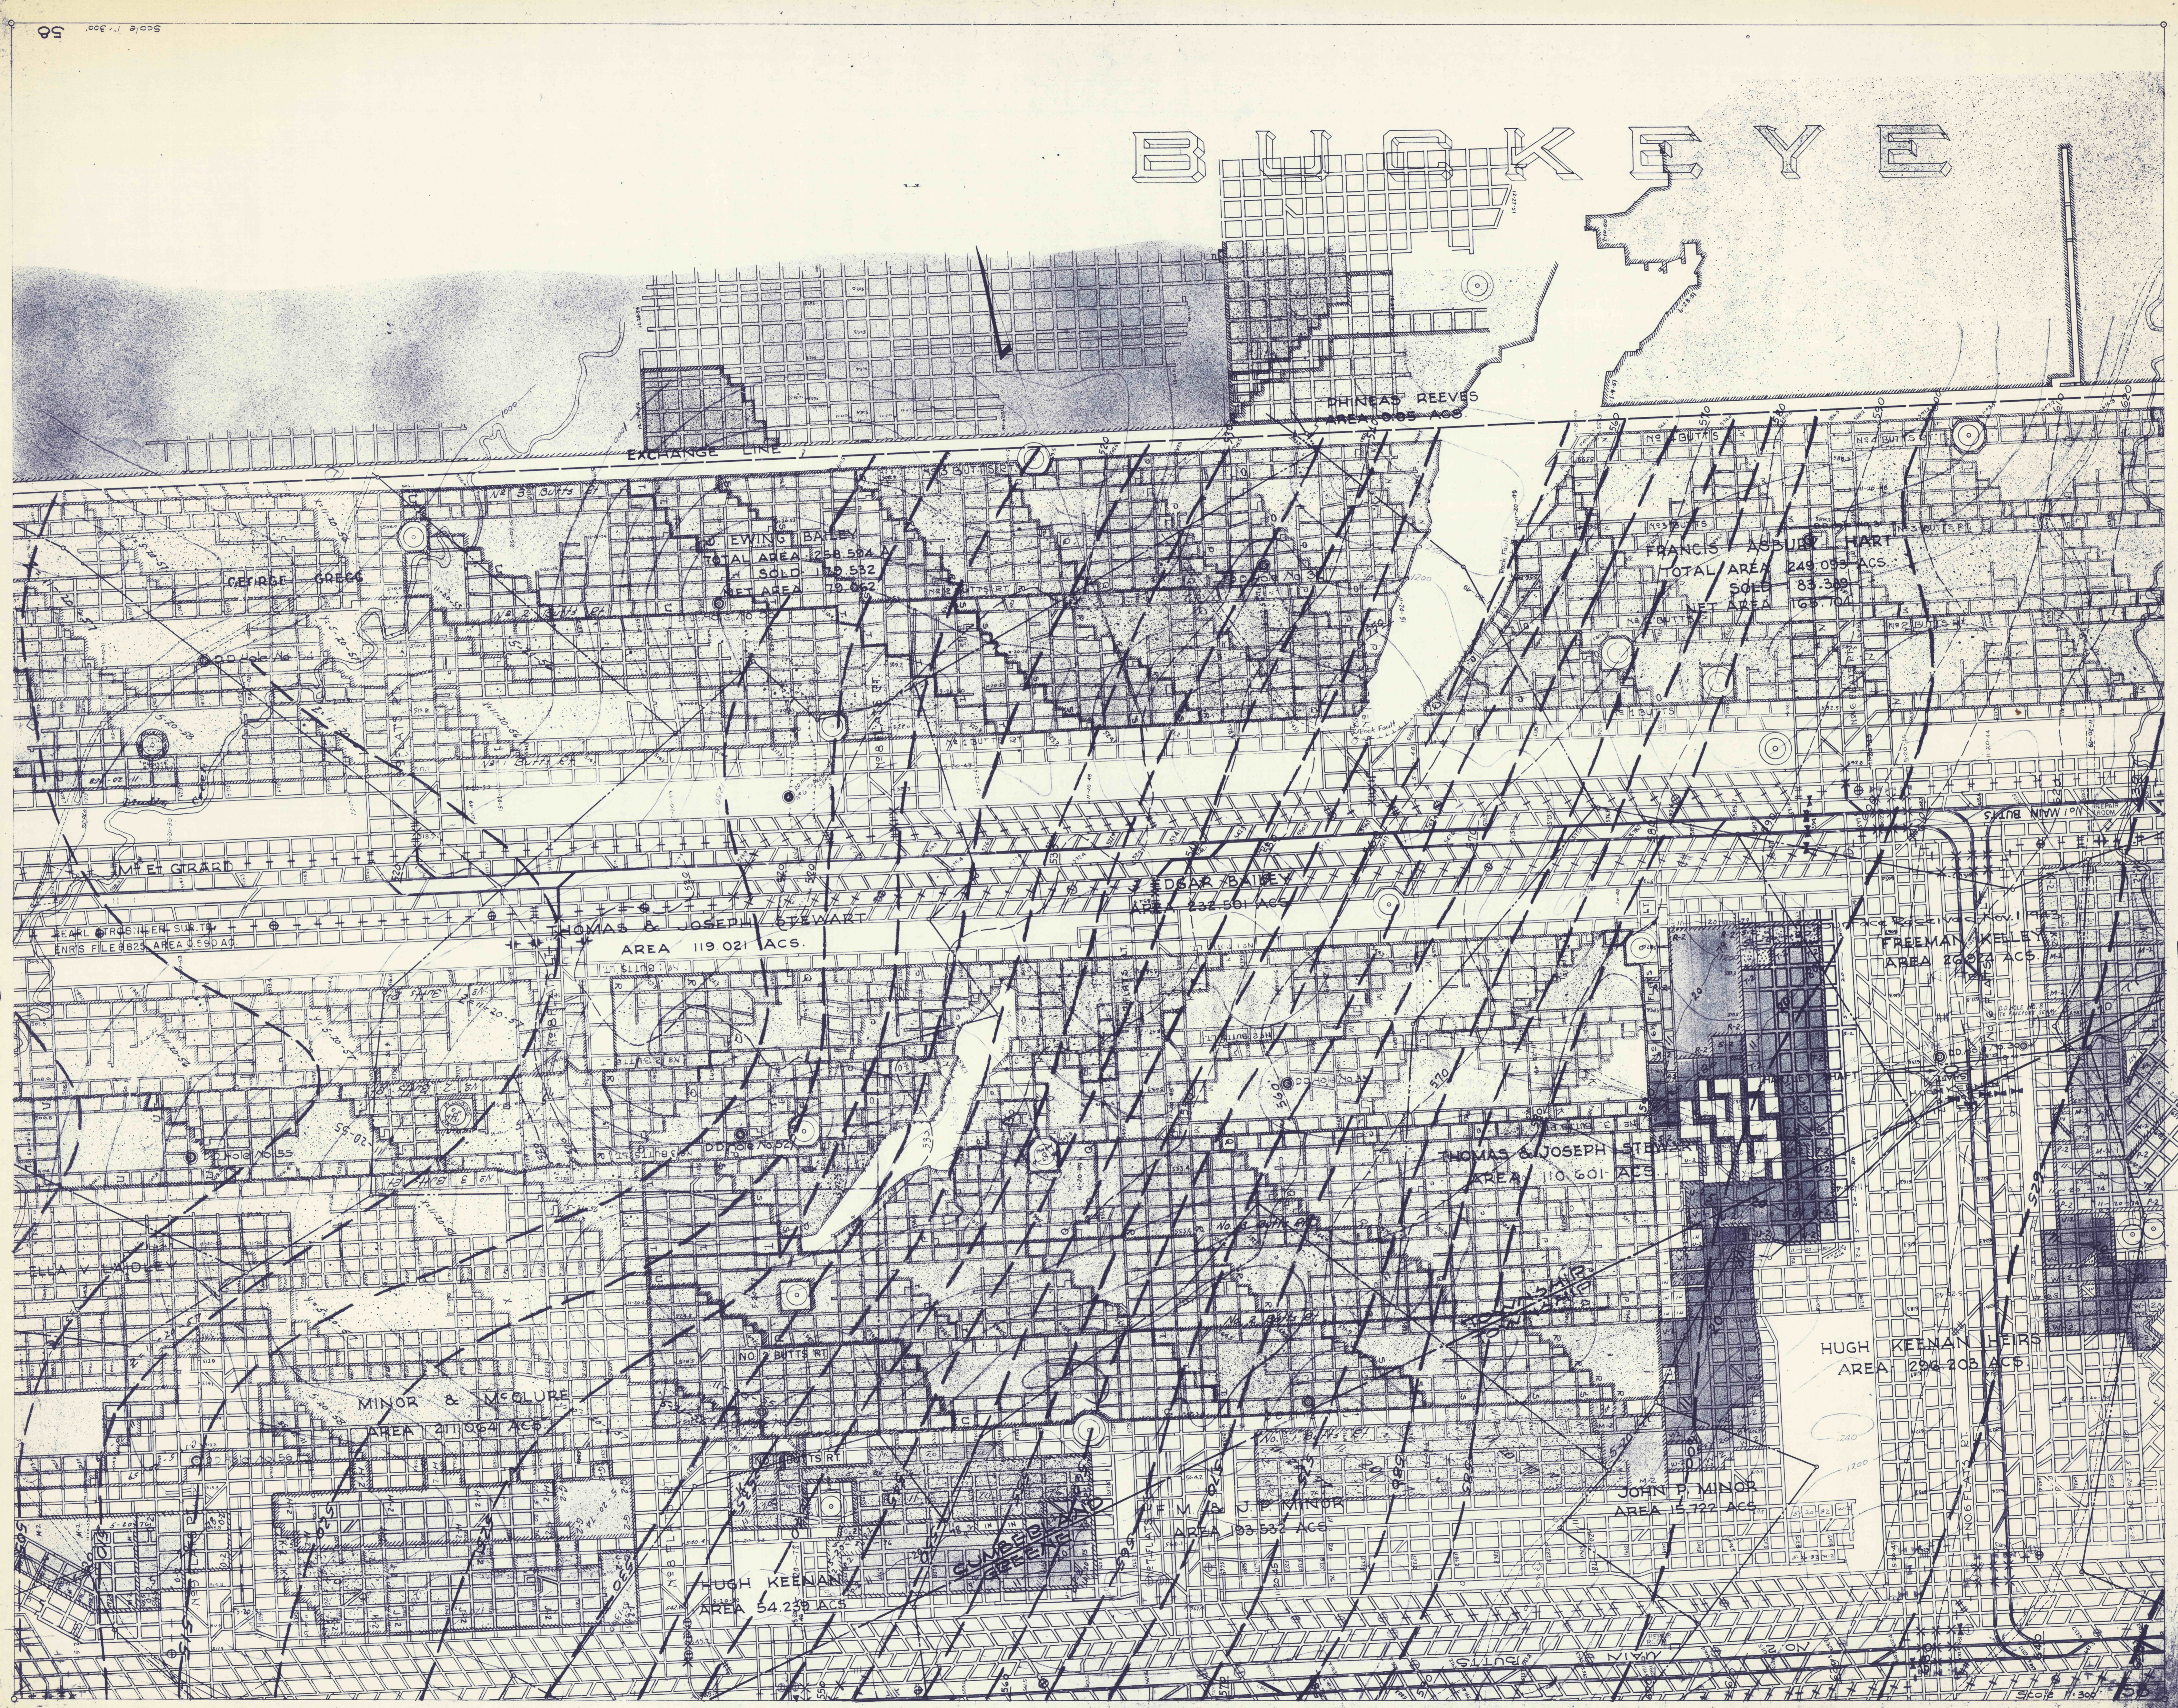


PHINEAS REEVES
AREA 3,005 ACES

FRANCIS ASBURY HART
TOTAL AREA 249,099 ACES
SOLD 83,349
NET AREA 165,750

THOMAS & JOSEPH STEWART
AREA 119,021 ACES

J. EDGAR BAILEY
AREA 232,501 ACES

FREEMAN KELLEY
AREA 20,677 ACES

THOMAS & JOSEPH STEWART
AREA 110,601 ACES

MINOR & McCLURE
AREA 211,064 ACES

HUGH KEENAN
AREA 54,239 ACES

J. F. M. A. J. MINOR
AREA 93,532 ACES

JOHN P. MINOR
AREA 15,722 ACES

HUGH KEENAN HEIRS
AREA 296,208 ACES