


FIT TO 75

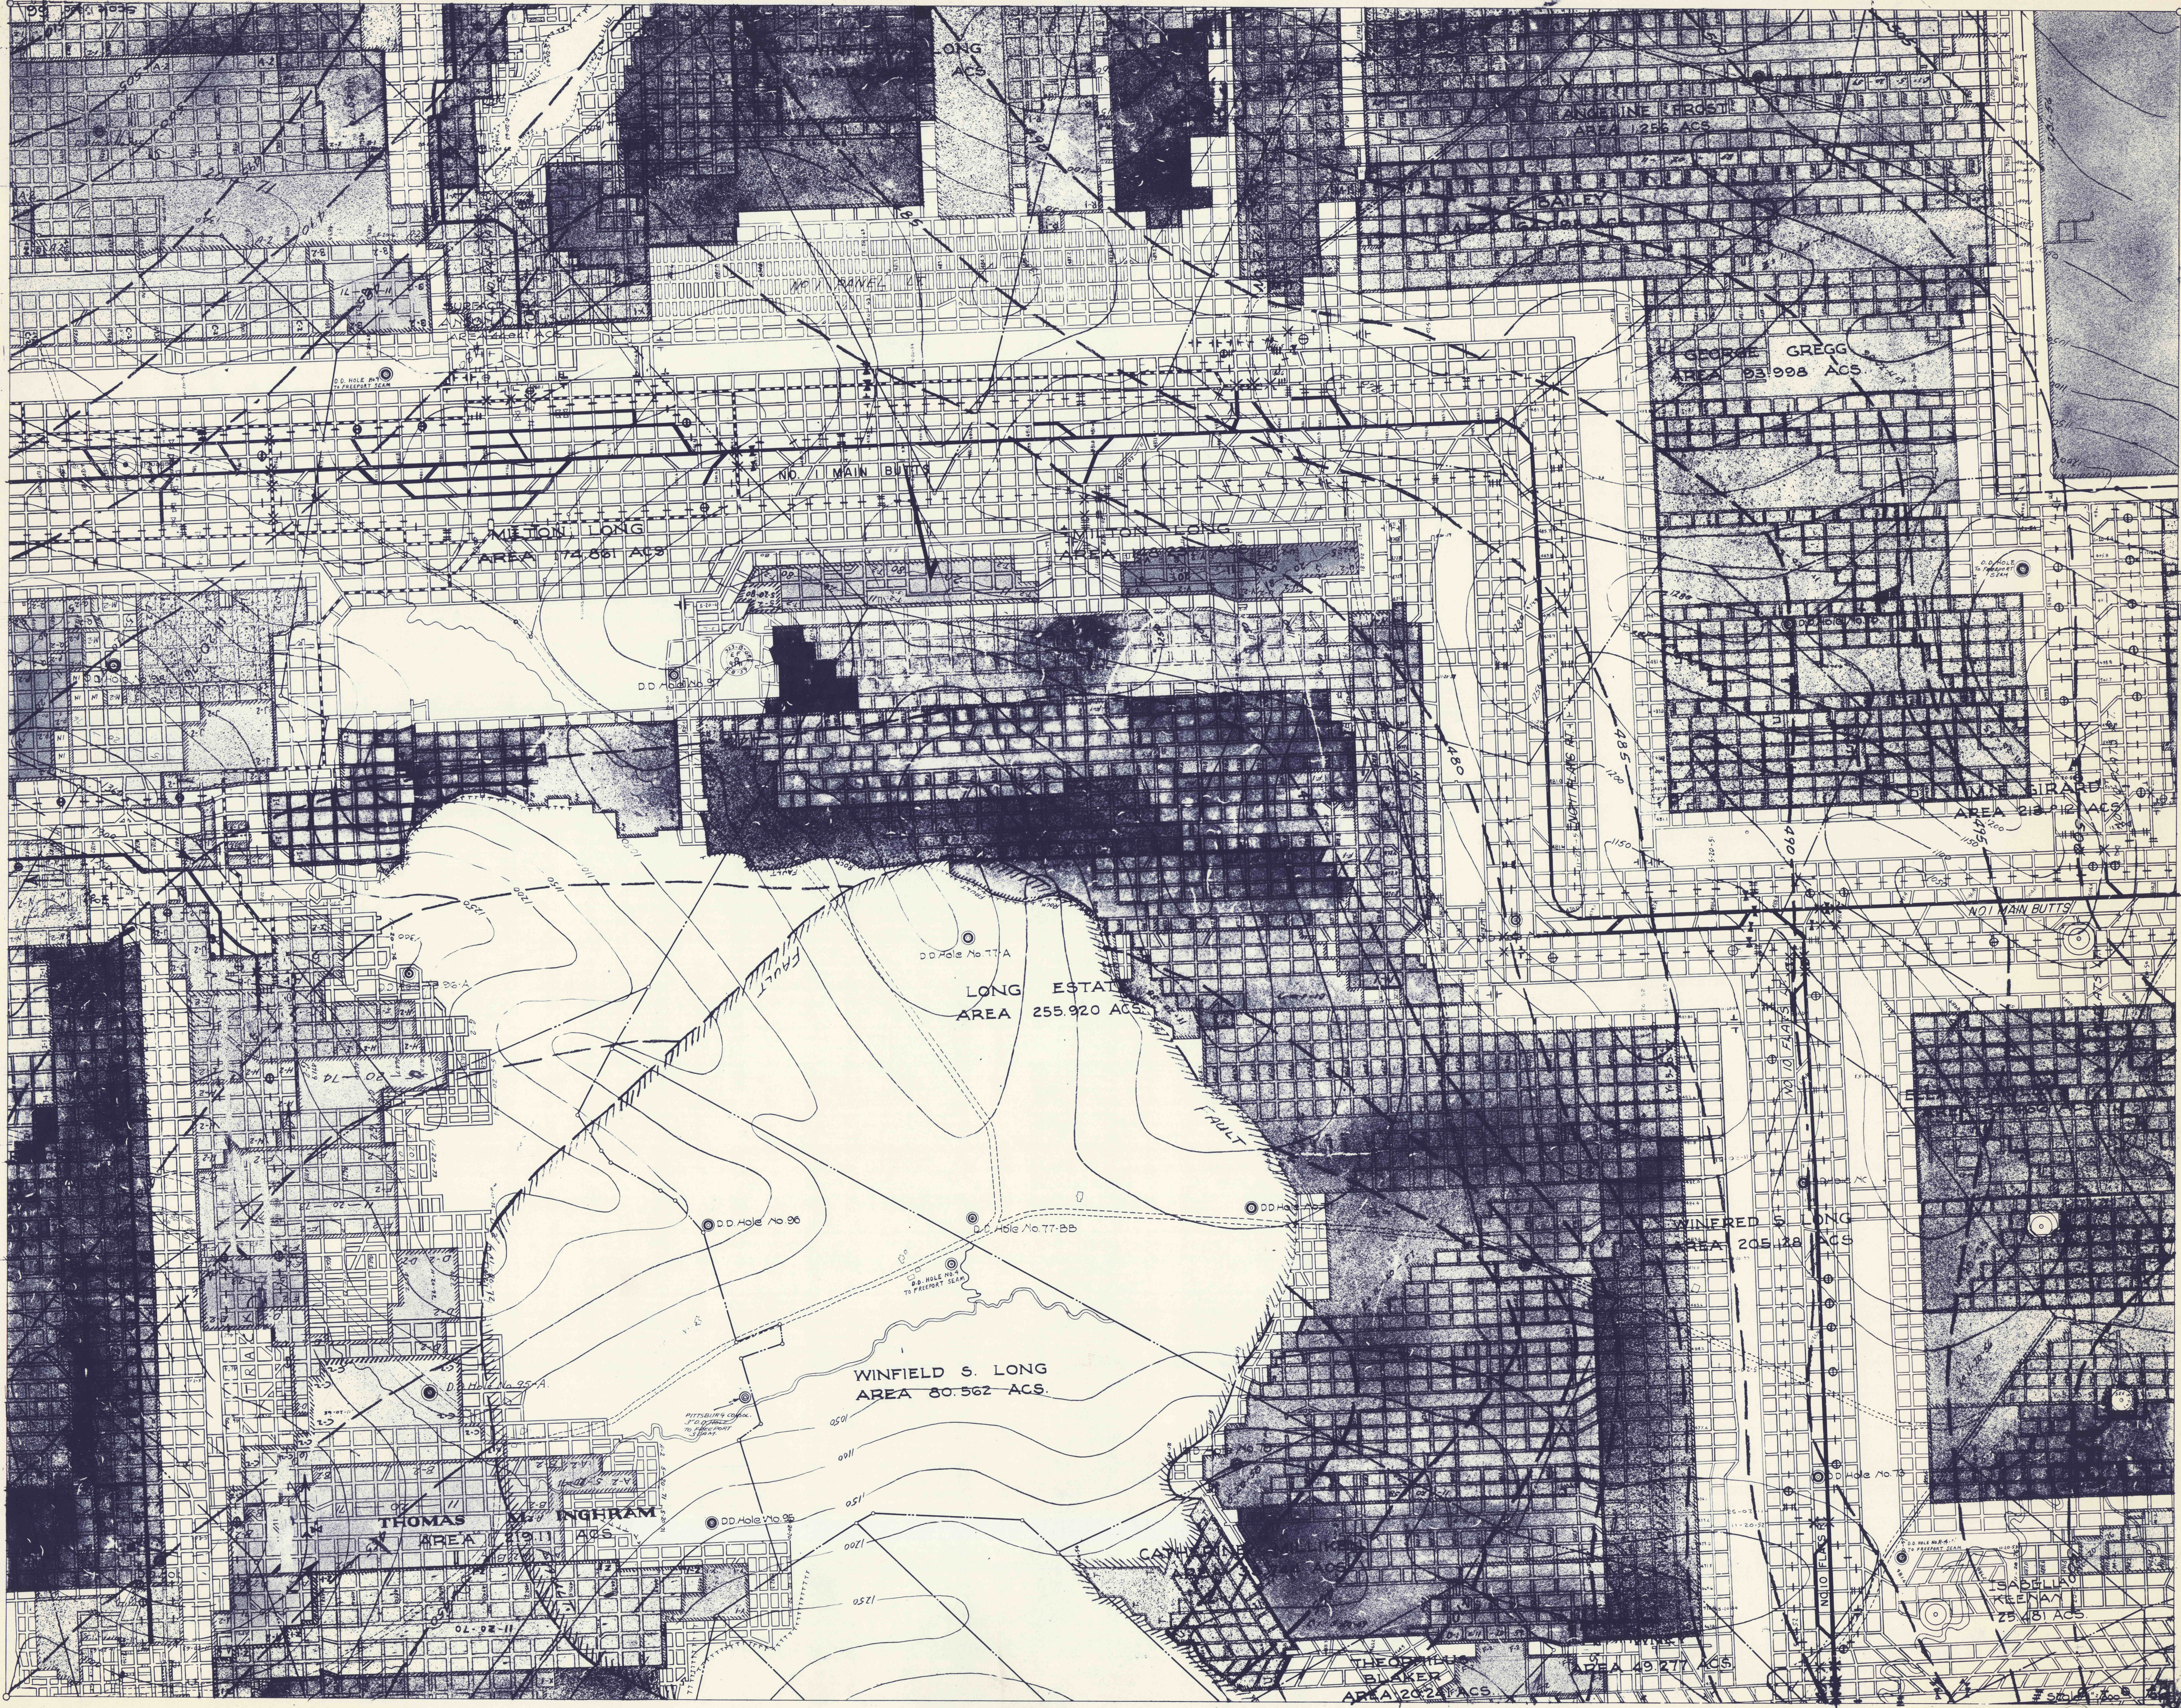

FIT TO 58