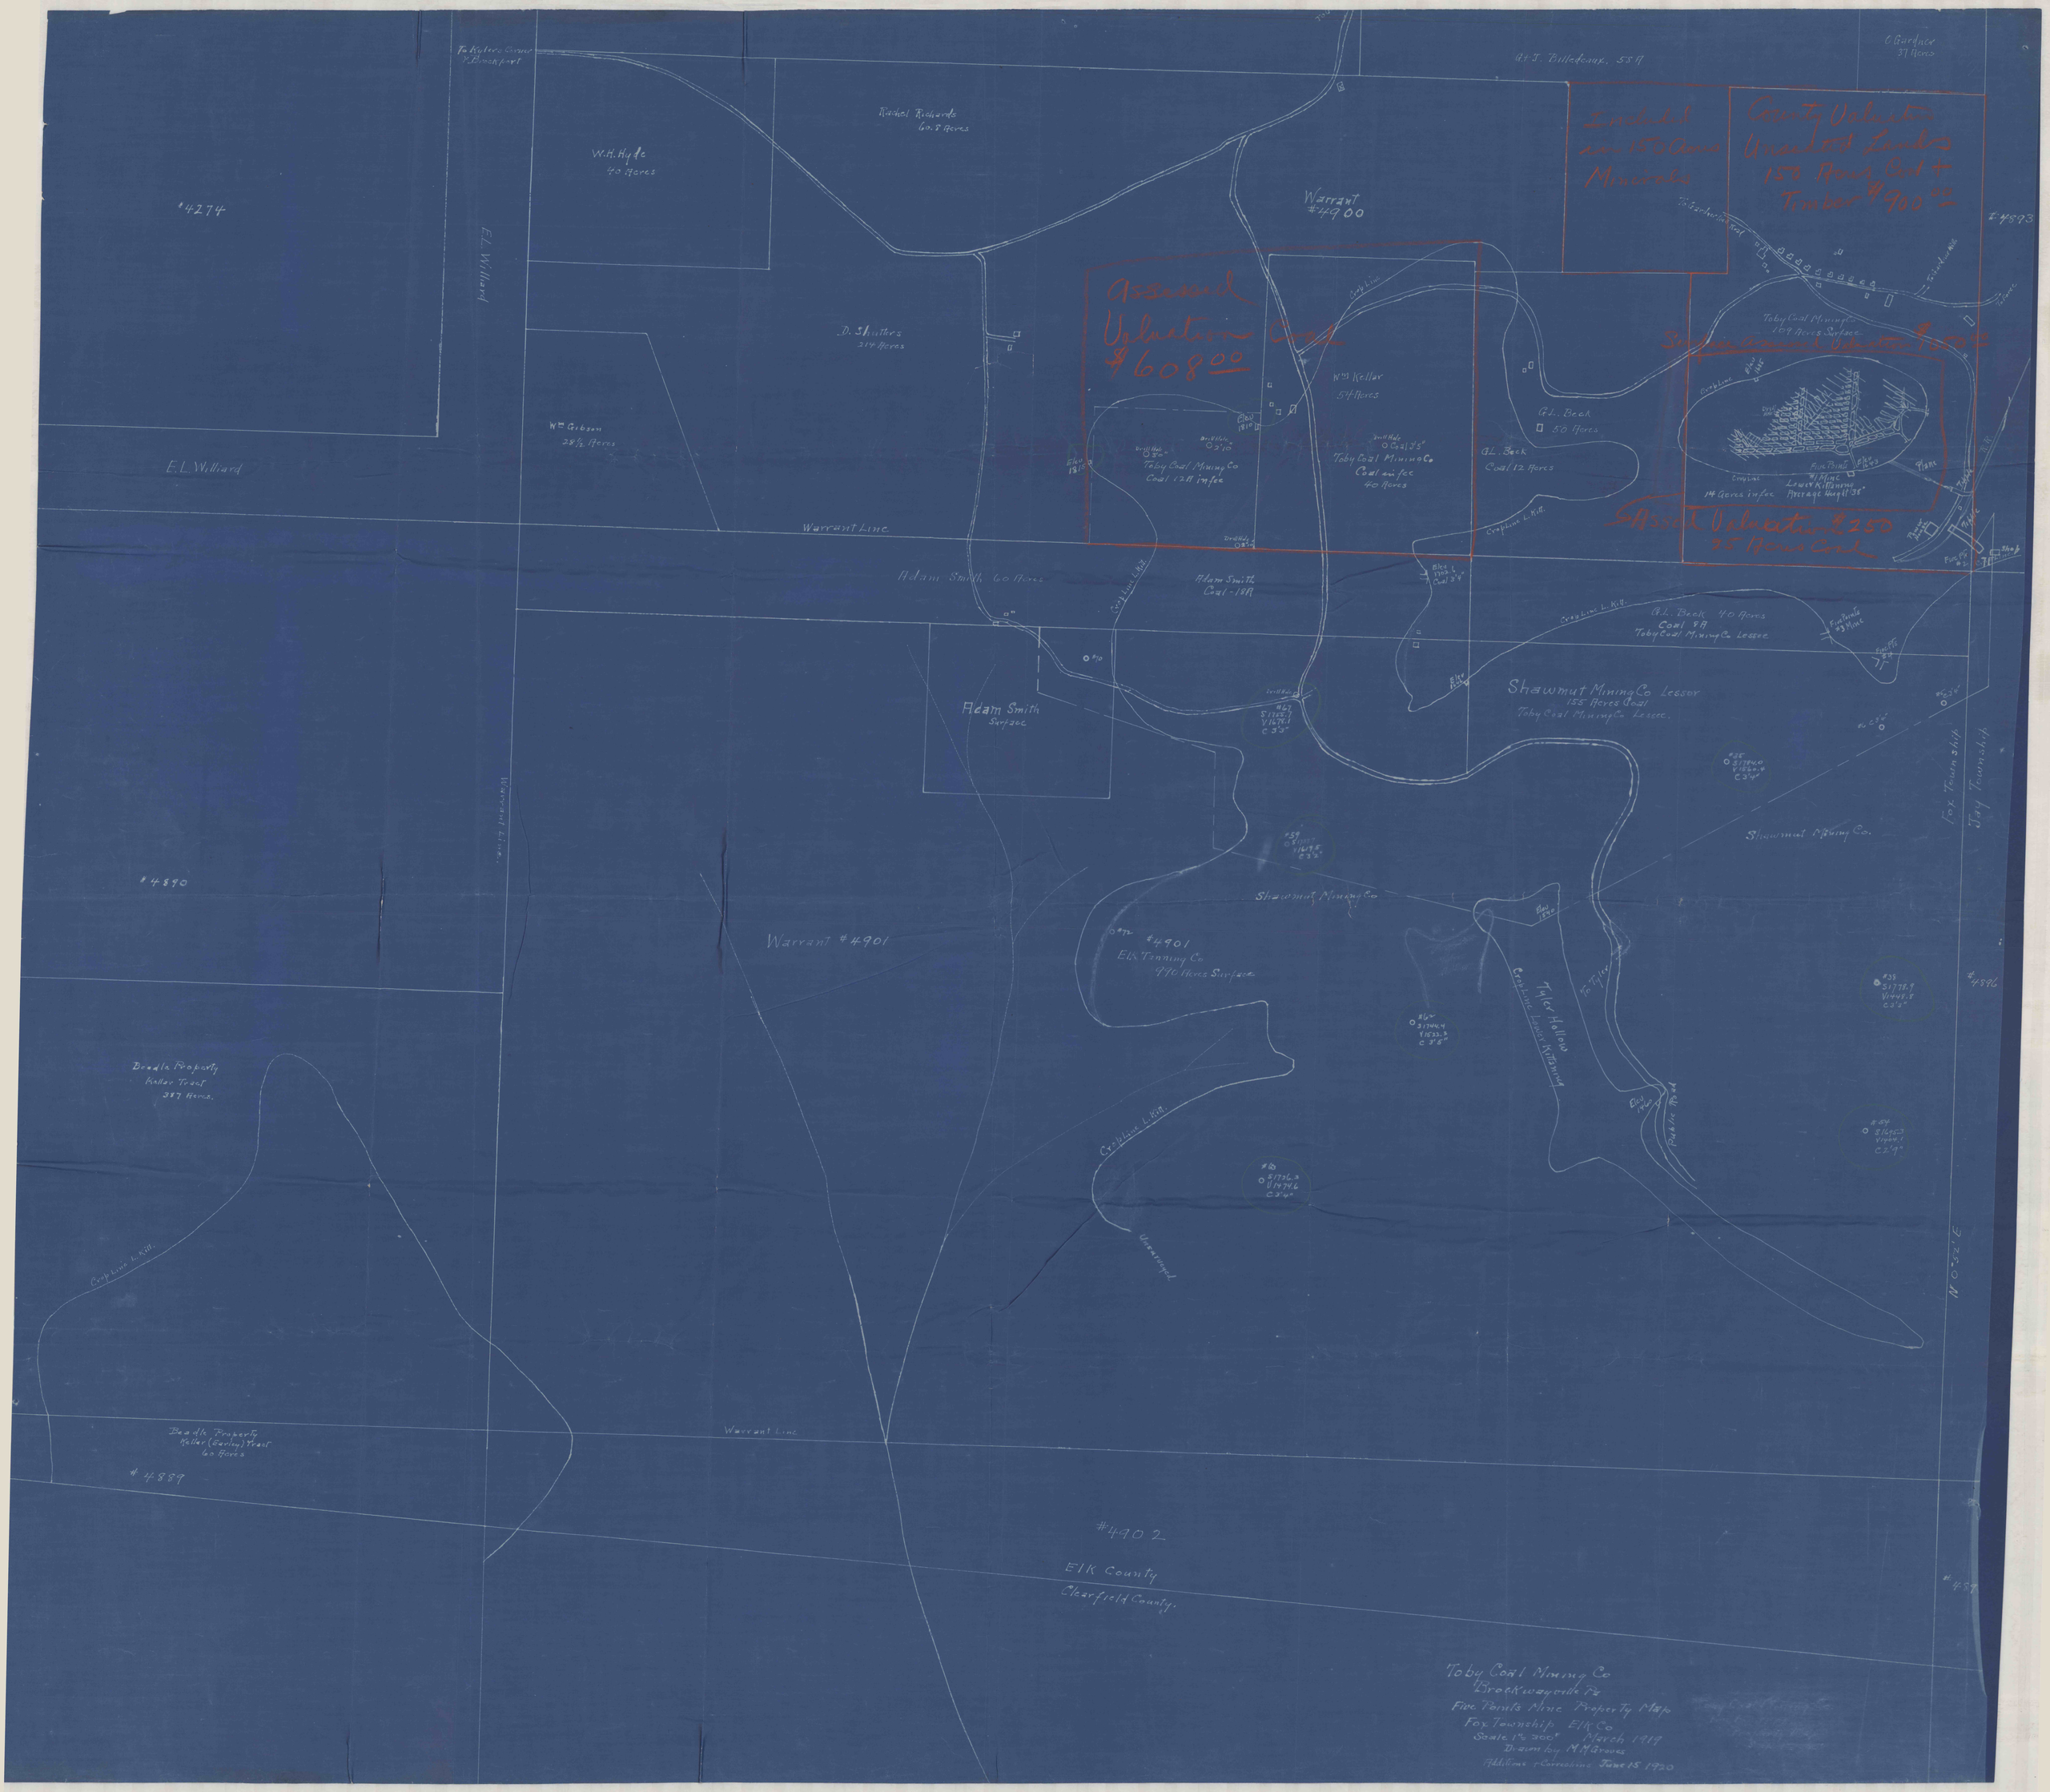

Included in 150 Acres Minerals
County Valuation Unseated Lands 150 Acres Coal + Timber $900.00
Assessed Valuation Coal $608.00
Surface Assessed Valuation $250.00
Assessed Valuation $250 25 Acres Coal
Warrant #4900
Warrant #4901
Warrant Line
Adam Smith 60 Acres
Adam Smith Coal - 18A
Adam Smith Surface
Toby Coal Mining Co Coal 12A in fee
Toby Coal Mining Co Coal in fee 40 Acres
Toby Coal Mining Co 109 Acres Surface
Toby Coal Mining Co Lessee
Shawmut Mining Co Lessor 155 Acres Coal
Shawmut Mining Co.
Elk Tanning Co 990 Acres Surface
Tyler Hollow
Crop Line Lower Kittanning
Public Road
Fox Township
Jay Township
Beadle Property Kellar Tract 387 Acres.
Beadle Property Kellar (Earley) Tract 60 Acres
#4274
#4890
#4889
#4902
#4893
#4896
#4897
Elk County
Clearfield County.
Toby Coal Mining Co
Brockwayville Pa
Five Points Mine Property Map
Fox Township Elk Co
Scale 1" = 300'
March 1919
Drawn by M M Groves
Additions + Corrections June 15 1920