


LEGEND

OPERATING COMPANY	START DATE SHOWING
MAFEL - STERLING COAL COMPANY	DEC 2, 1933
WEST-POINT MARION COAL COMPANY	MAR 1, 1943
WEST-POINT MARION COAL COMPANY	MAR 1, 1943
MAFEL - STERLING COAL COMPANY	JULY 1, 1943
KELLEY'S CREEK COAL COMPANY	MAR 1, 1950
ROSEDALE COAL COMPANY	MAR 1, 1950

SURVEY DATE	SURVEY DATE
JAN 15, 1934	
MAY 5, 1935	
DEC 29, 1937	
MAR 1, 1943	
SEPT 22, 1944	
JUN 23, 1946	
DEC 27, 1946	
JUN 11, 1947	
JUNE 23, 1948	
DEC 14, 1949	
MAR 18, 1949	
DEC 28, 1949	
MAR 28, 1950	
JUNE 10, 1950	

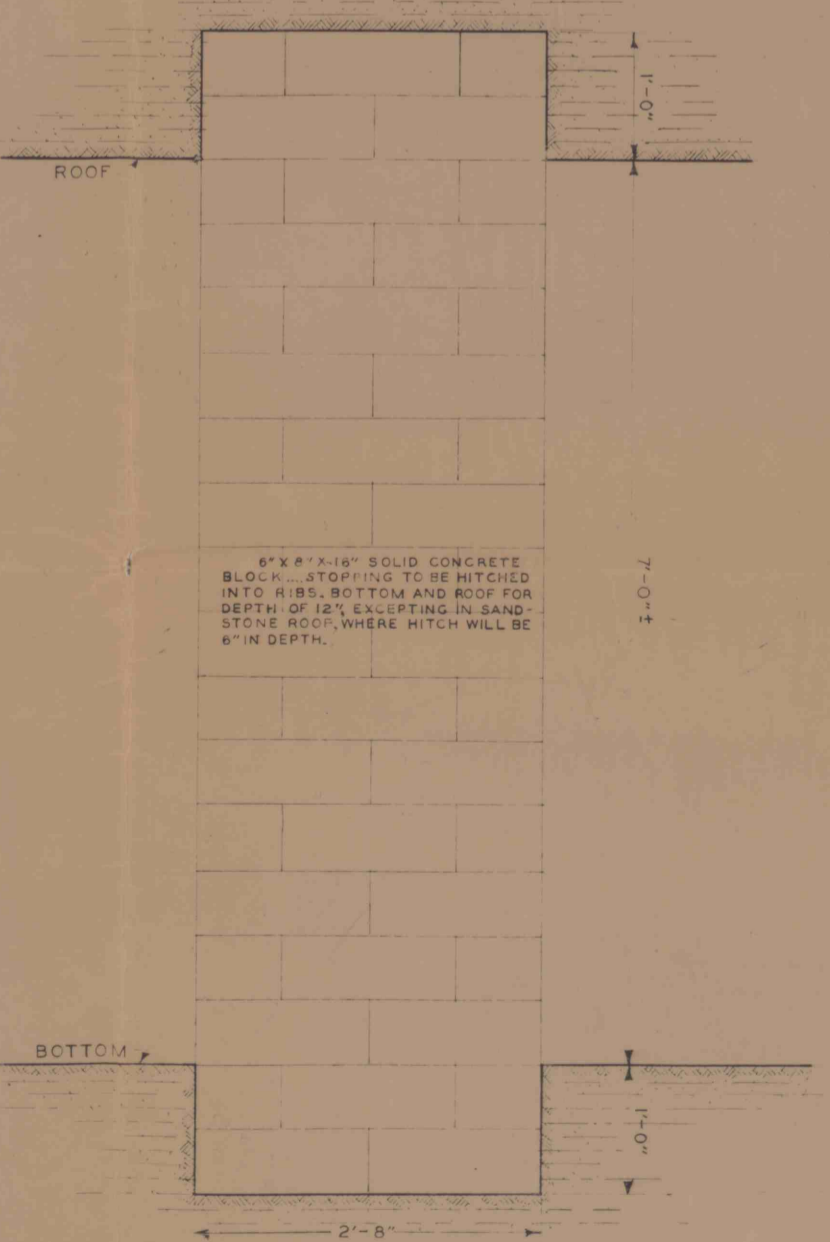

TYPICAL STOPPING TO BE CONSTRUCTED BETWEEN MINE WORKINGS OF MORFET MINE OF HILLMAN COAL & SKE CO AND MAIDEN MINE OF THE VALLEY CAMP COAL CO AT LOCATIONS 1 TO 10
 JUNE 1950 - SCALE 1"=10'

SCALE 1"=300'