


EXTENDED APRIL 29, 1916.
 TO 77 28, 1917.
 77 OCT. 25, 1917.
 77 APR. 24, 1918.
 77 NOV. 9, 1918.
 77 APR. 22, 1919.
 77 OCT. 22, 1919.
 77 APR. 24, 1920.

A. L. KEISTER & CO.

WILSON SHIELDS

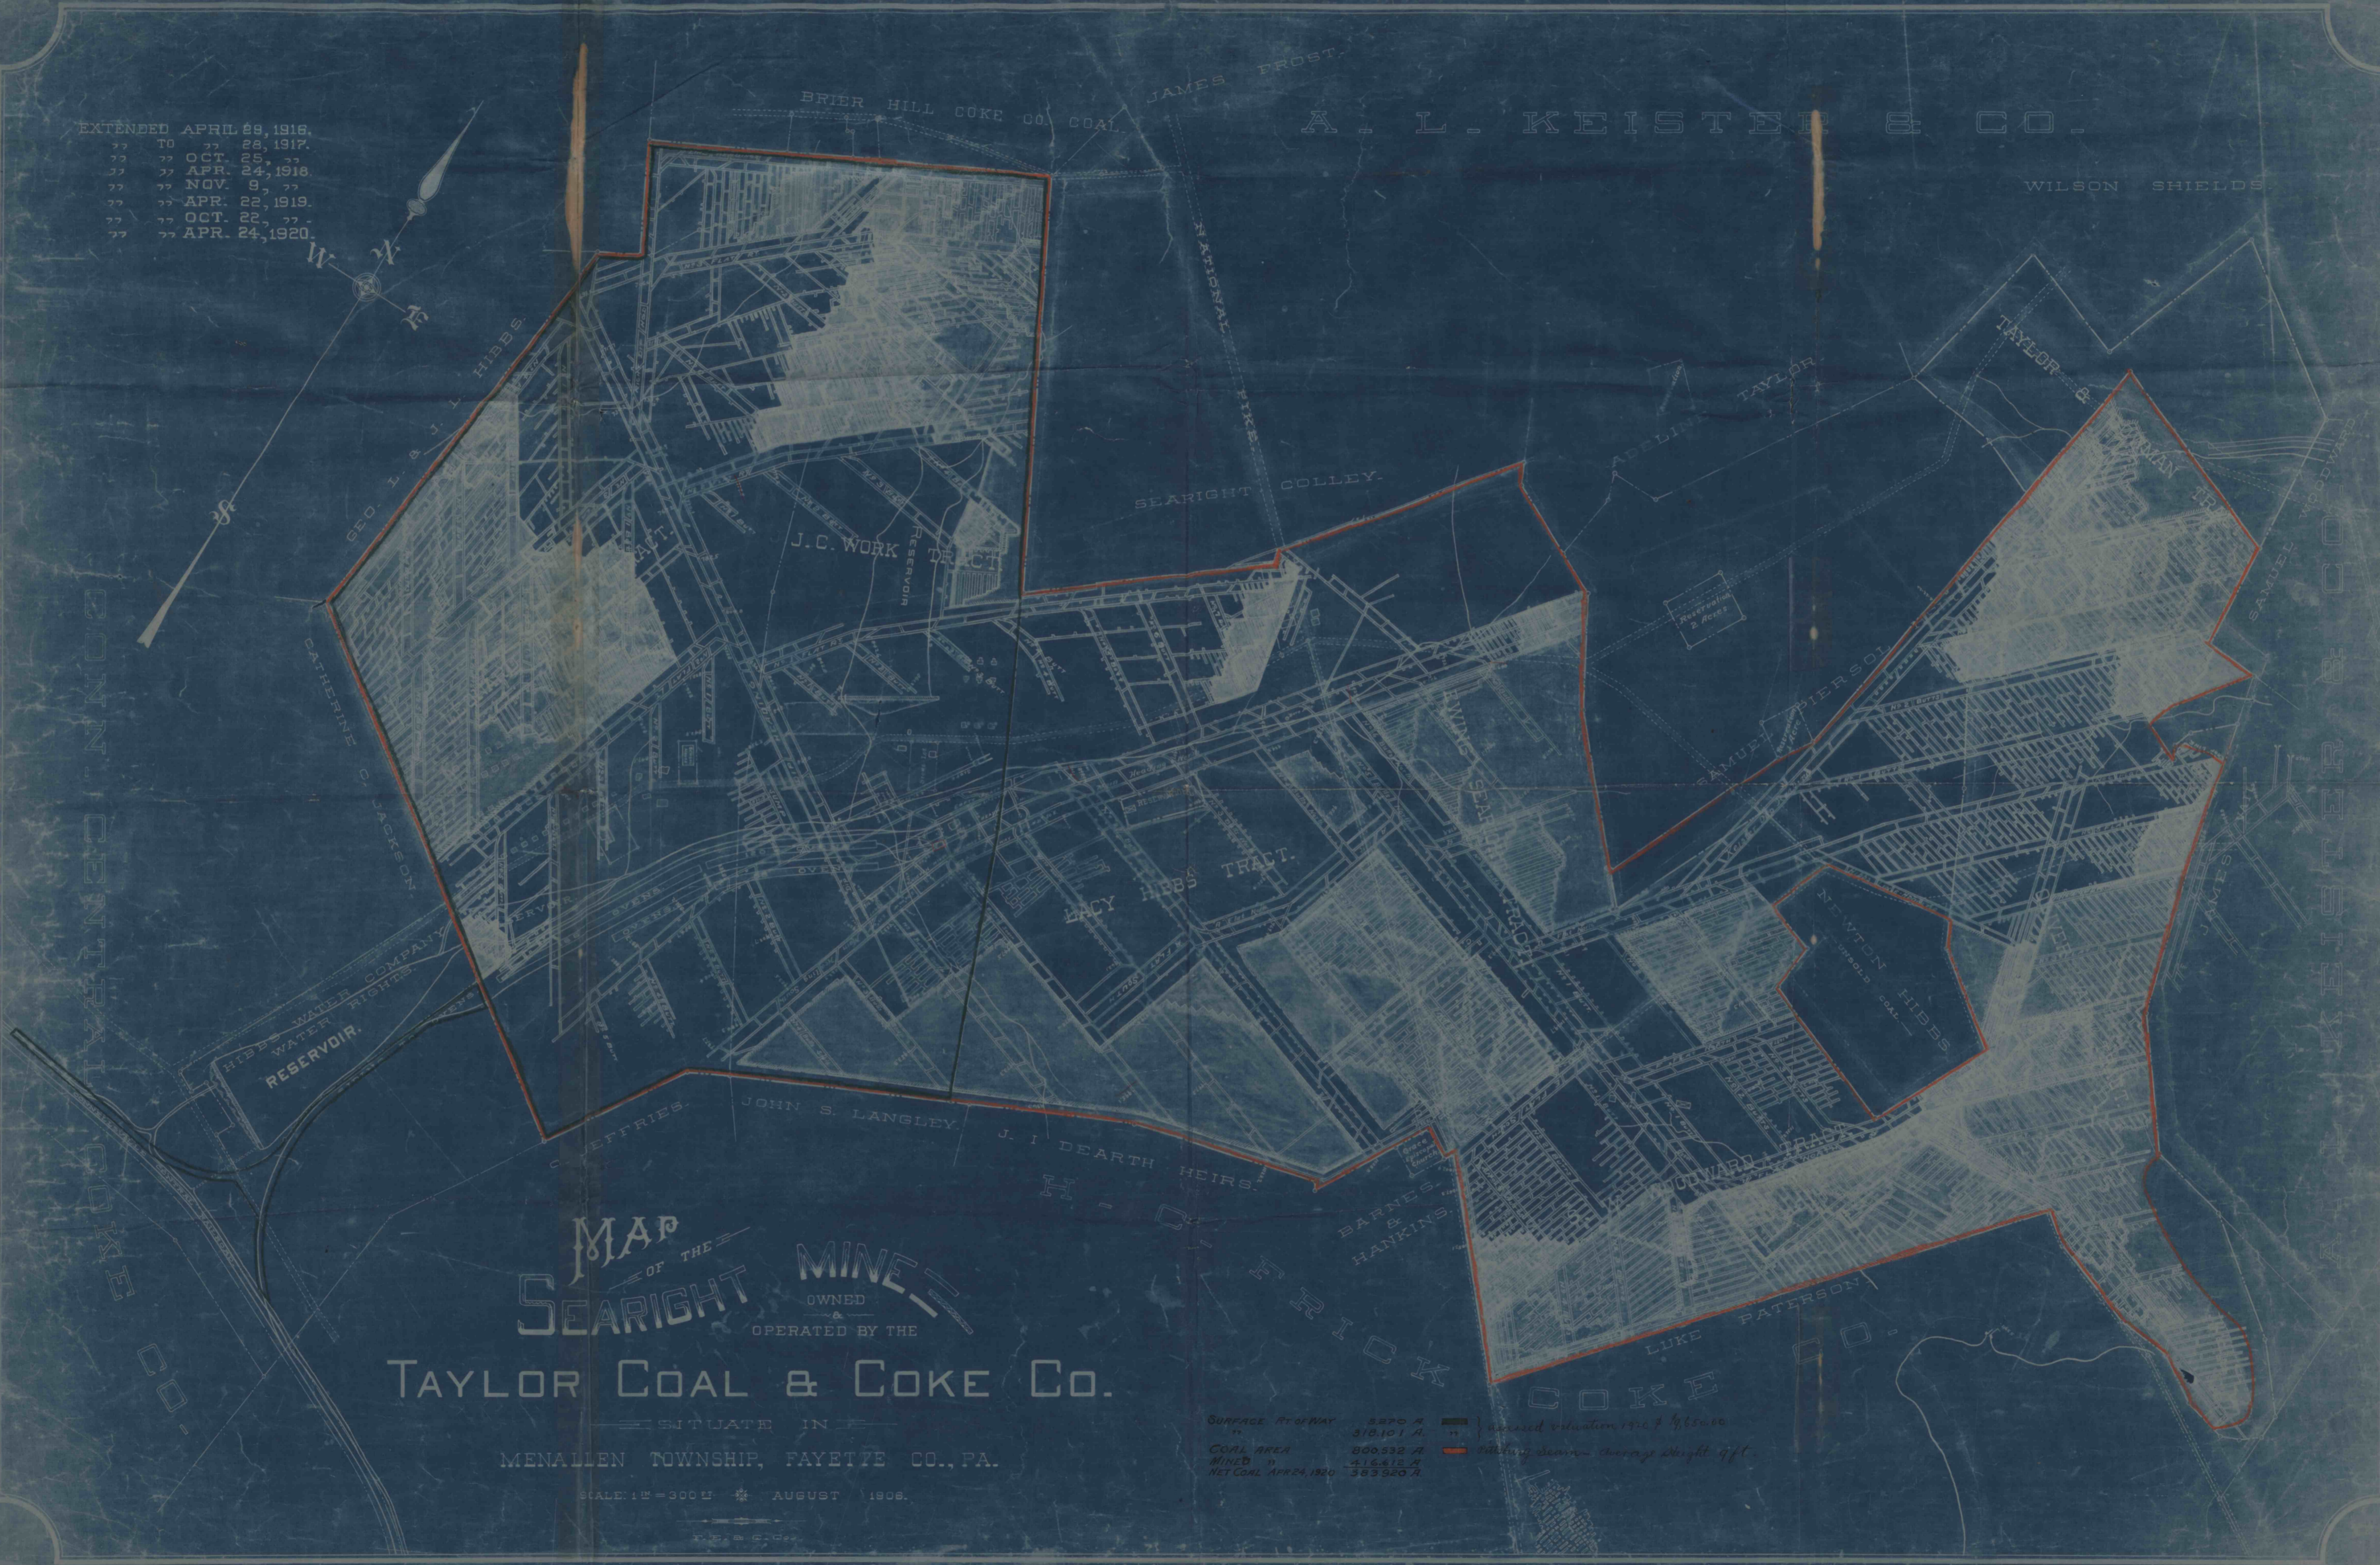

MAP OF THE **SEARIGHT MINE**
 OWNED & OPERATED BY THE
TAYLOR COAL & COKE CO.

SITUATE IN
 MENALLEN TOWNSHIP, FAYETTE CO., PA.

SCALE: 1" = 300' AUGUST 1908.

SURFACE AREA	2270 A.	} assessed valuation 1916 \$ 46500
"	318,101 A.	
COAL AREA	800,532 A.	} bitting seams average weight 9 ft.
MINED "	416,612 A.	
NET COAL APR 24, 1920	383,950 A.	