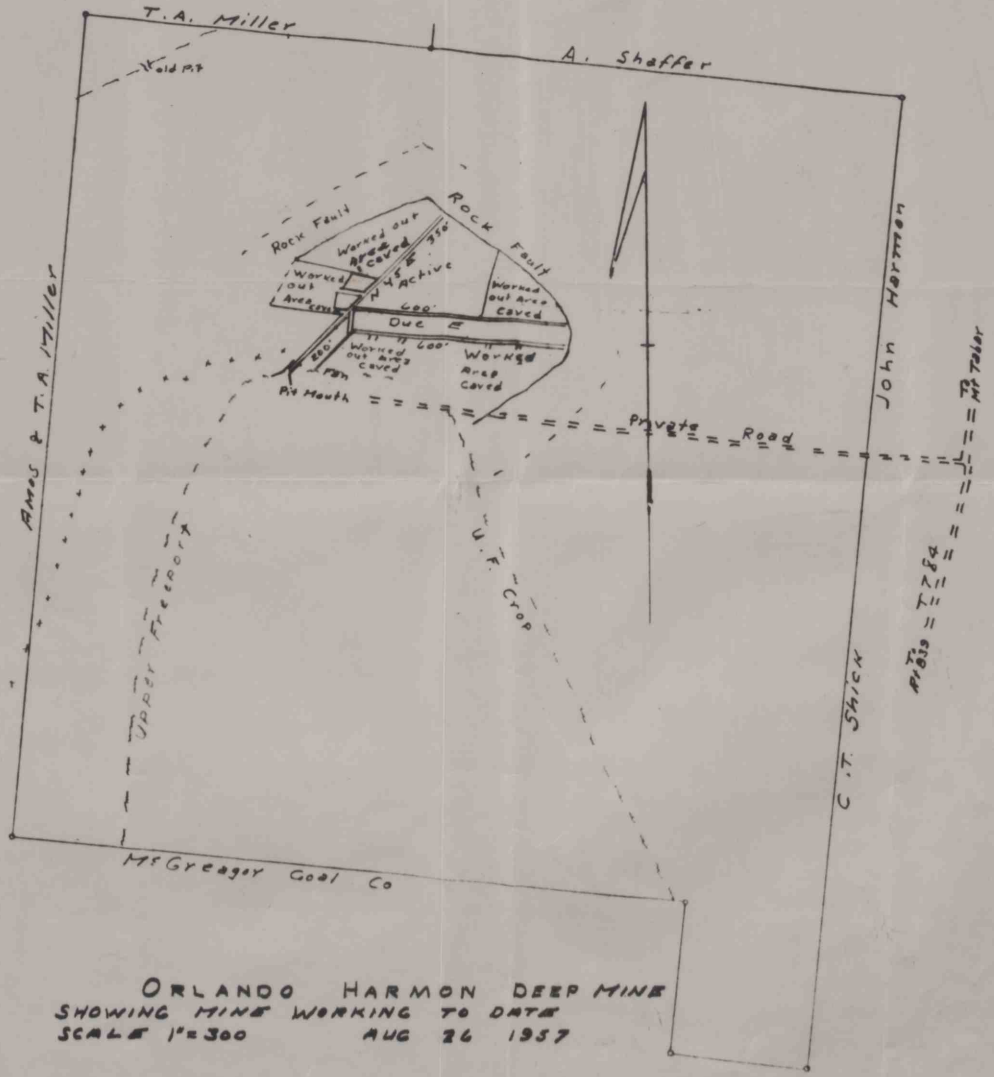

ORLANDO HARMON DEEP MINE
SHOWING MINE WORKING TO DATE
SCALE 1"=300 AUG 26 1957

ARMSTRONG CO DIST 2