


MATHER COLLIERIES

MATHER, PA.

COAL PROPERTIES SITUATED IN MONROE AND JEFFERSON TOWNSHIPS AND JEFFERSON BOROUGH, GREENE COUNTY, PA.

Copyright 1908
MATHER & COMPANY

Scale 1" = 400'

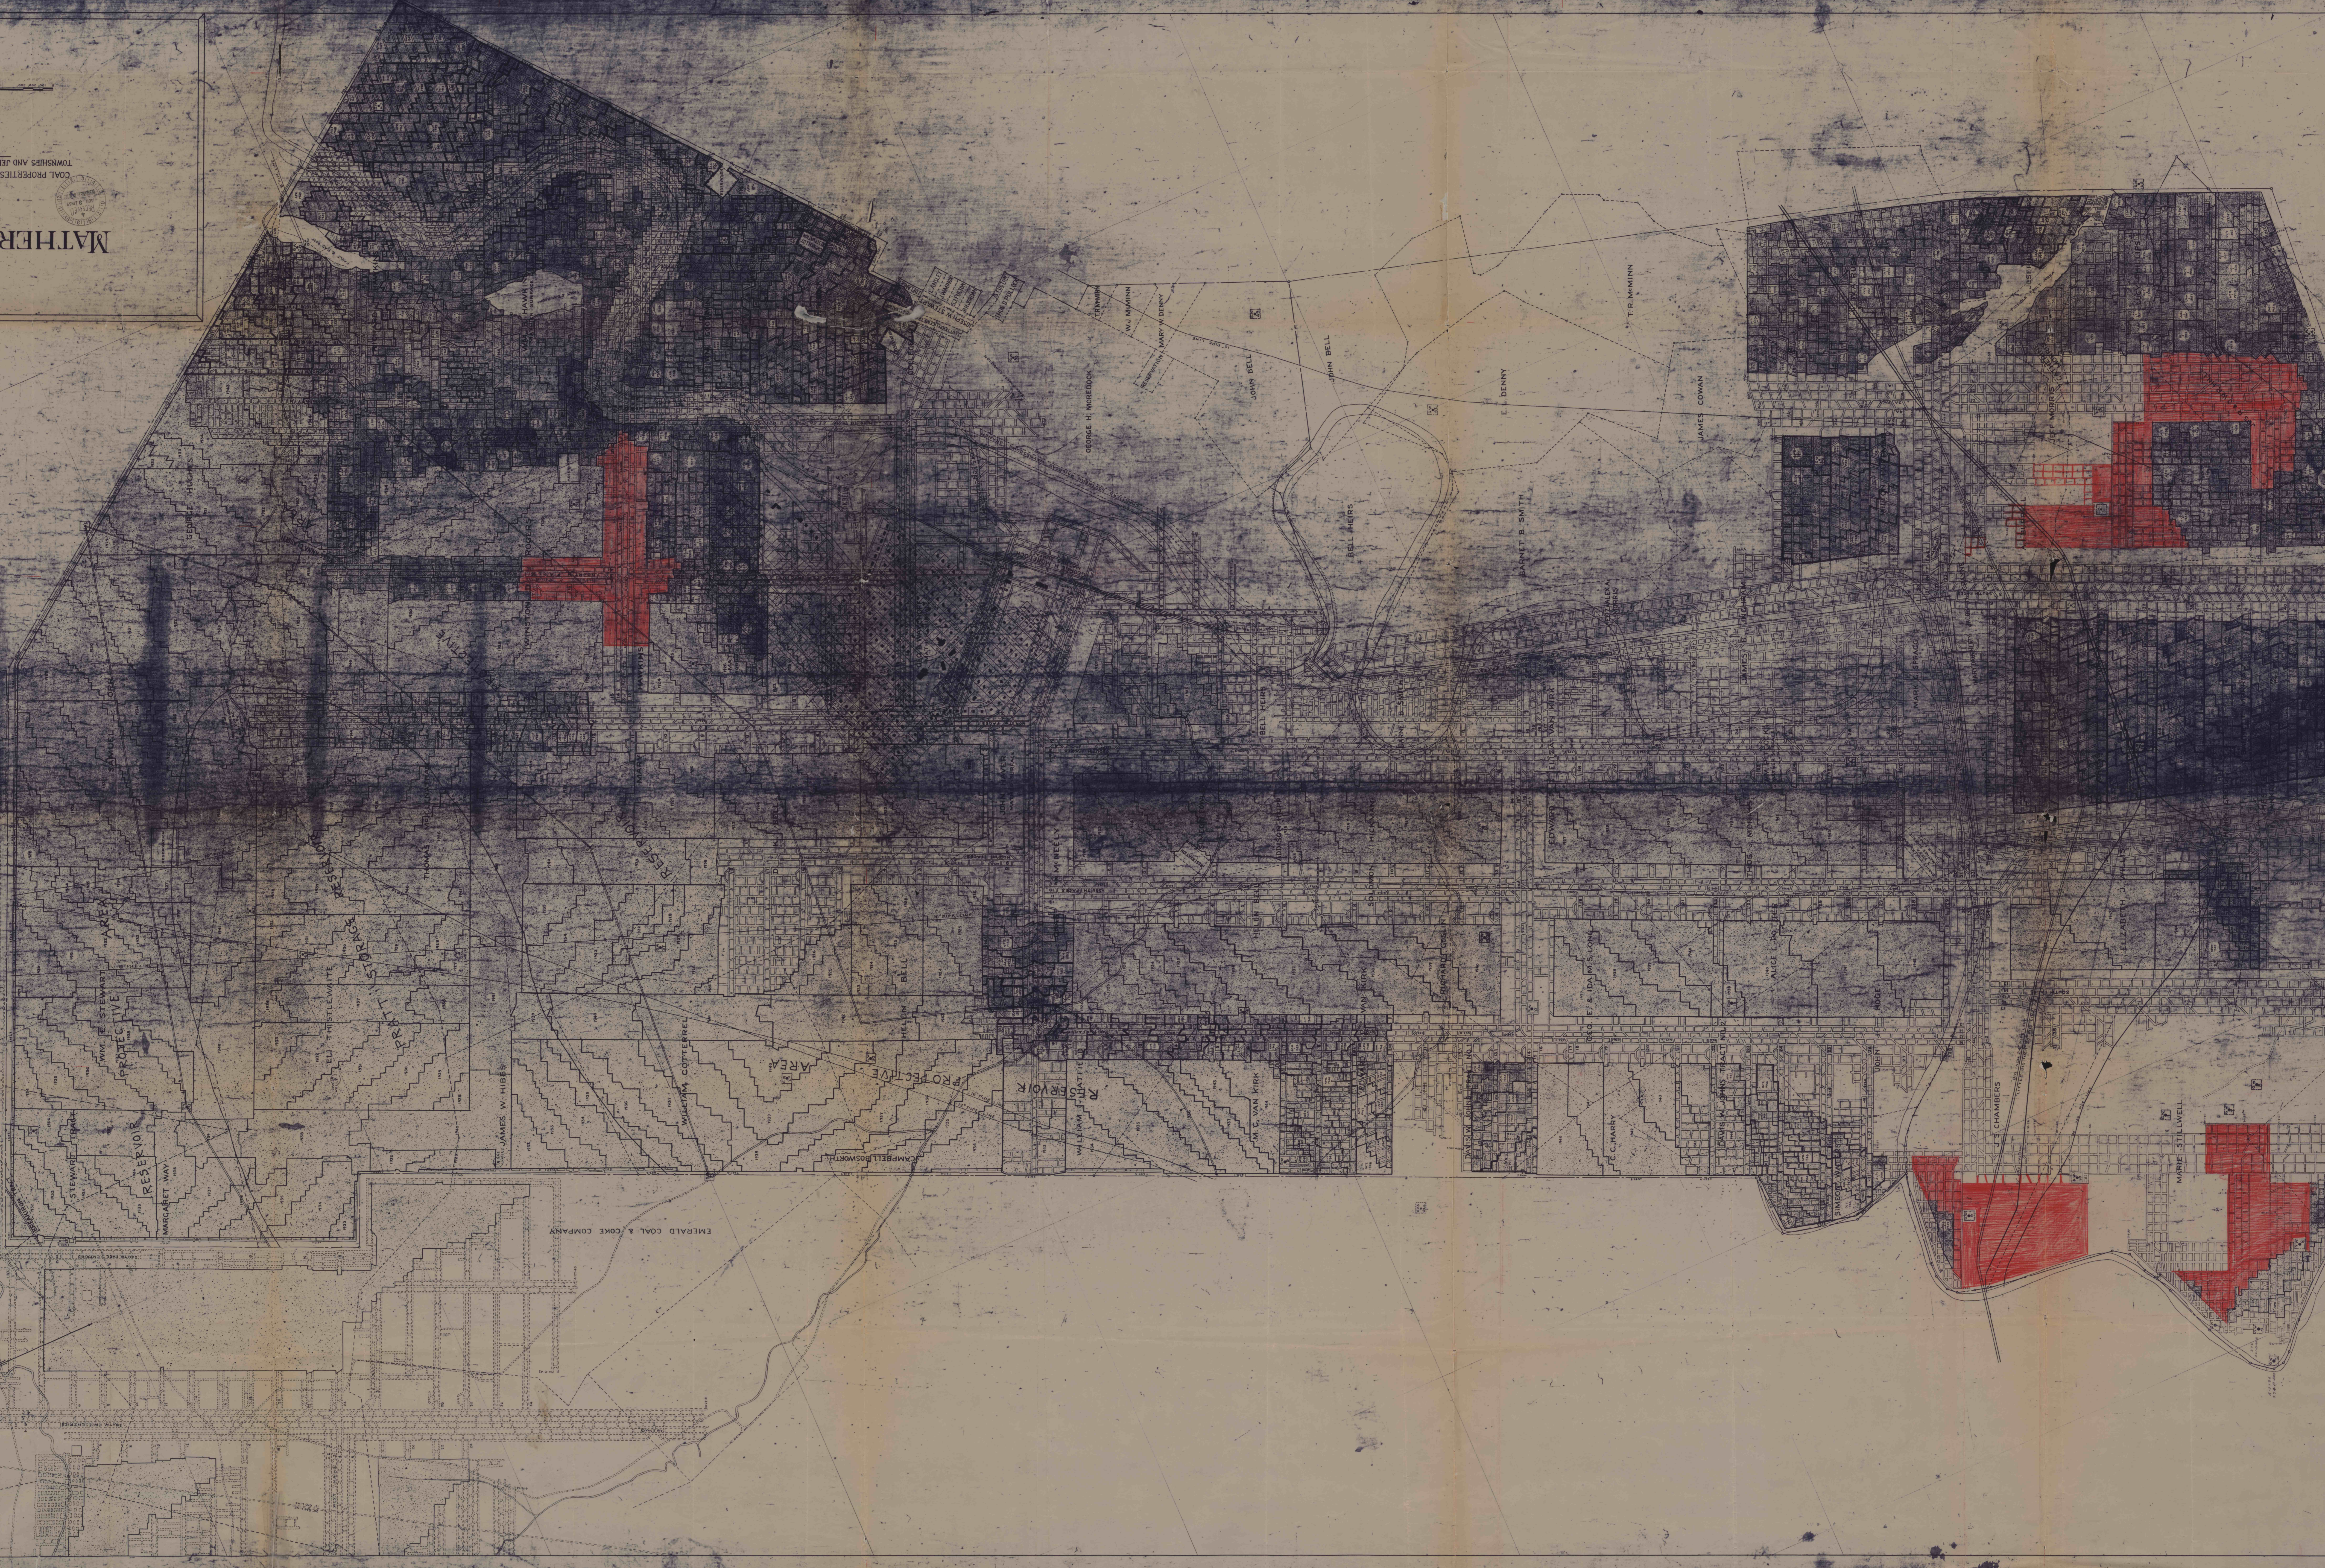

EMERALD COAL & COKE COMPANY

EMERALD COAL & COKE COMPANY

RESERVATION
MARGARET WAY



PROTECTIVE AREA

PROTECTIVE AREA

