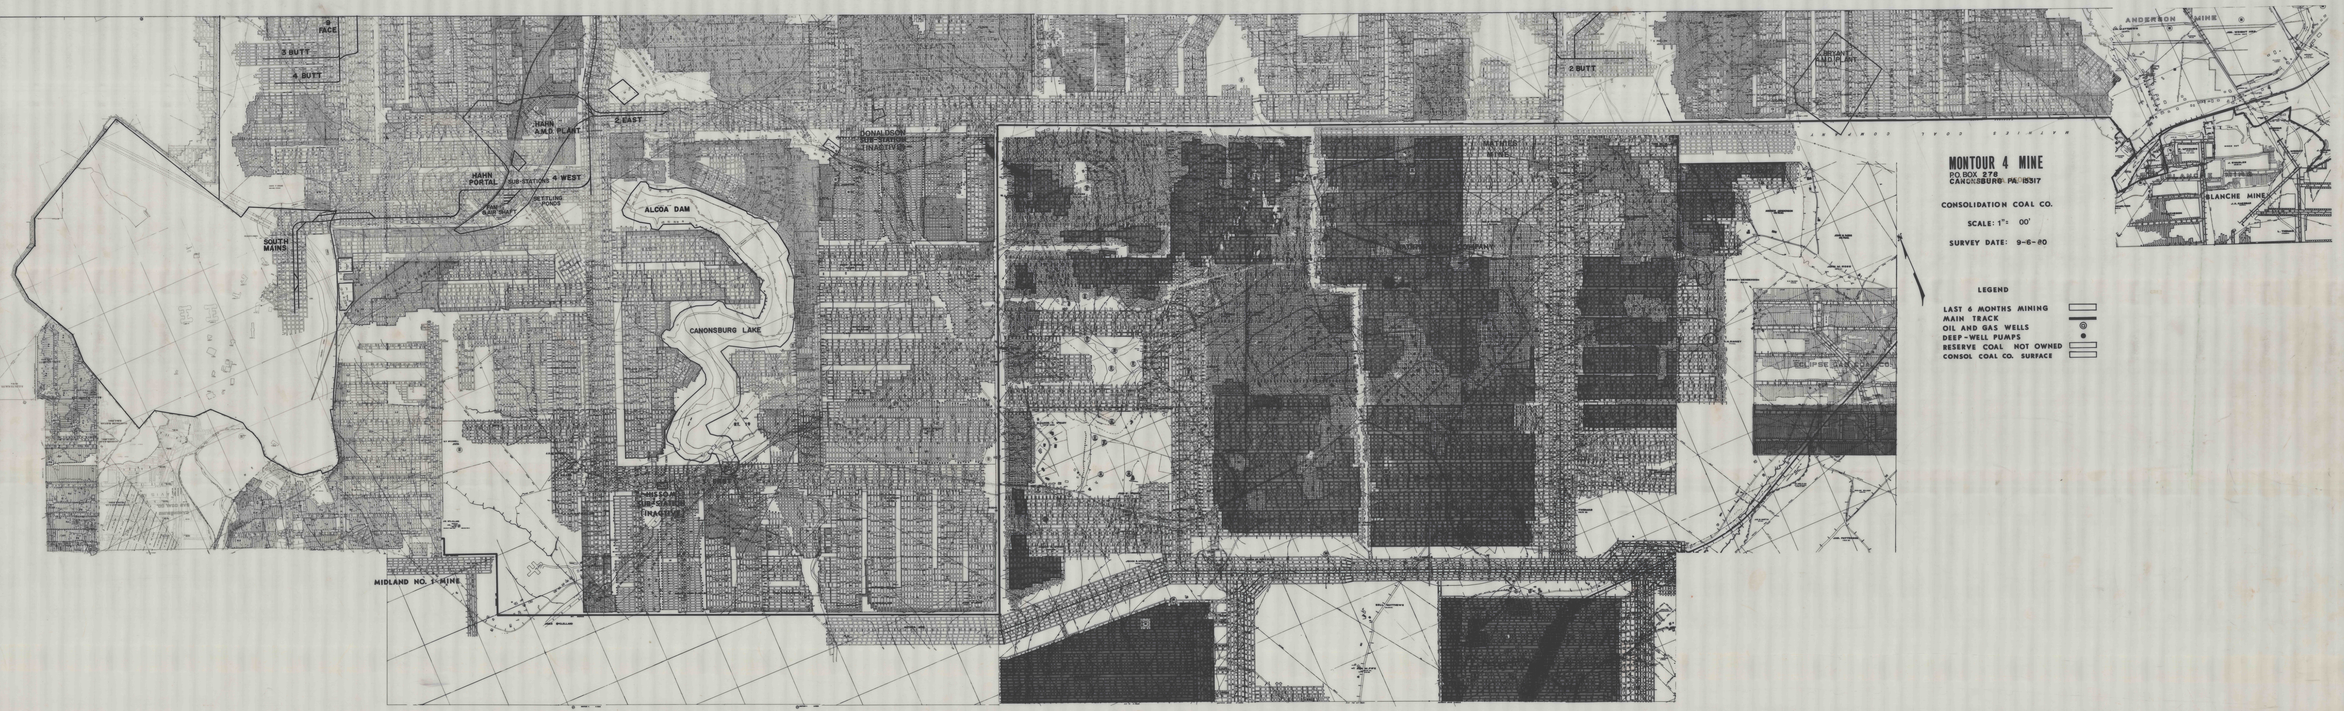
MONTOUR 4 MINE
PO BOX 278
CANONSBURG PA 15317
CONSOLIDATION COAL CO.
SCALE: 1" = 00'
SURVEY DATE: 9-6-80
LEGEND
LAST 6 MONTHS MINING
MAIN TRACK
OIL AND GAS WELLS
DEEP-WELL PUMPS
RESERVE COAL NOT OWNED
CONSOL COAL CO. SURFACE
ANDERSON MINE
BLANCHE MINE
MIDLAND NO. 1 MINE
ALCOA DAM
CANONSBURG LAKE
SOUTH MAINS
HAHN PORTAL
HAHN A.M.D. PLANT
SUB-STATIONS
TAILING POND
2 EAST
4 WEST
3 BUTT
4 BUTT
2 BUTT
DONALDSON SUB-STATION (INACTIVE)
MATHER MINE
BETHANY A.M.D. PLANT