


Dickcey Tract

Outcrop of E. Seam

AREA OF "D" COAL
31.5 ACRES

Outcrop of "D" Seam

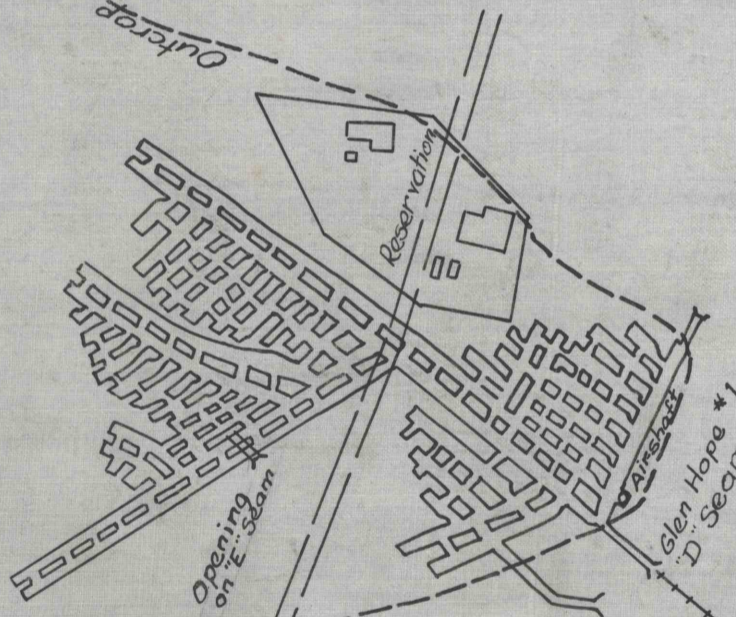


Baer Tract

Dotts Tract

A.W. Patchin Tract

Gravelly Plane

Station
Glen Hope Pa.

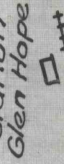

Coal Mining Co.
Private Siding

Smith Tract

GLEN HOPE COAL MINING CO.

WORKINGS ON

A.W. PATCHIN TRACT

GLEN HOPE PA. MAY 29-1920

Scale 1"=300'

R.F.C.