
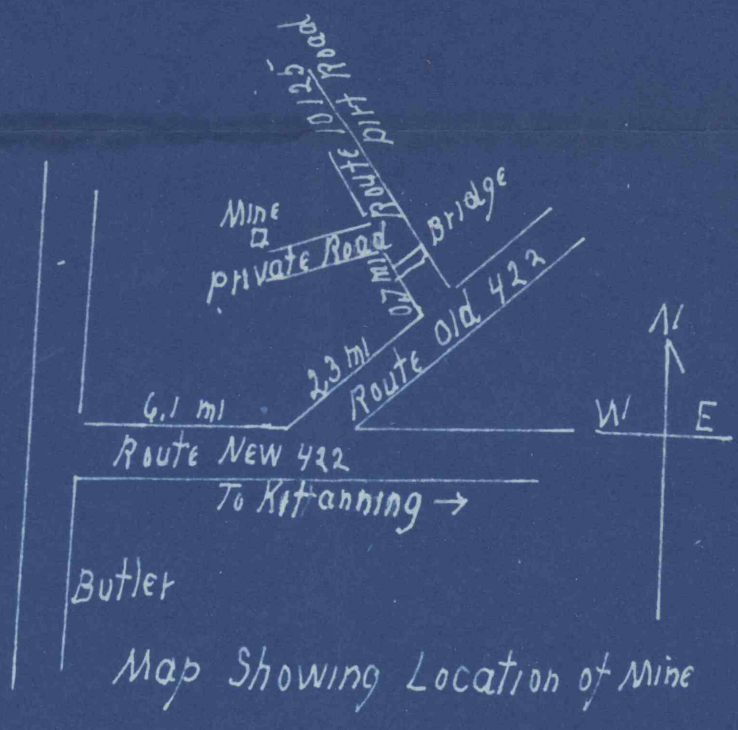


#629  
6-29-99  
C.C.

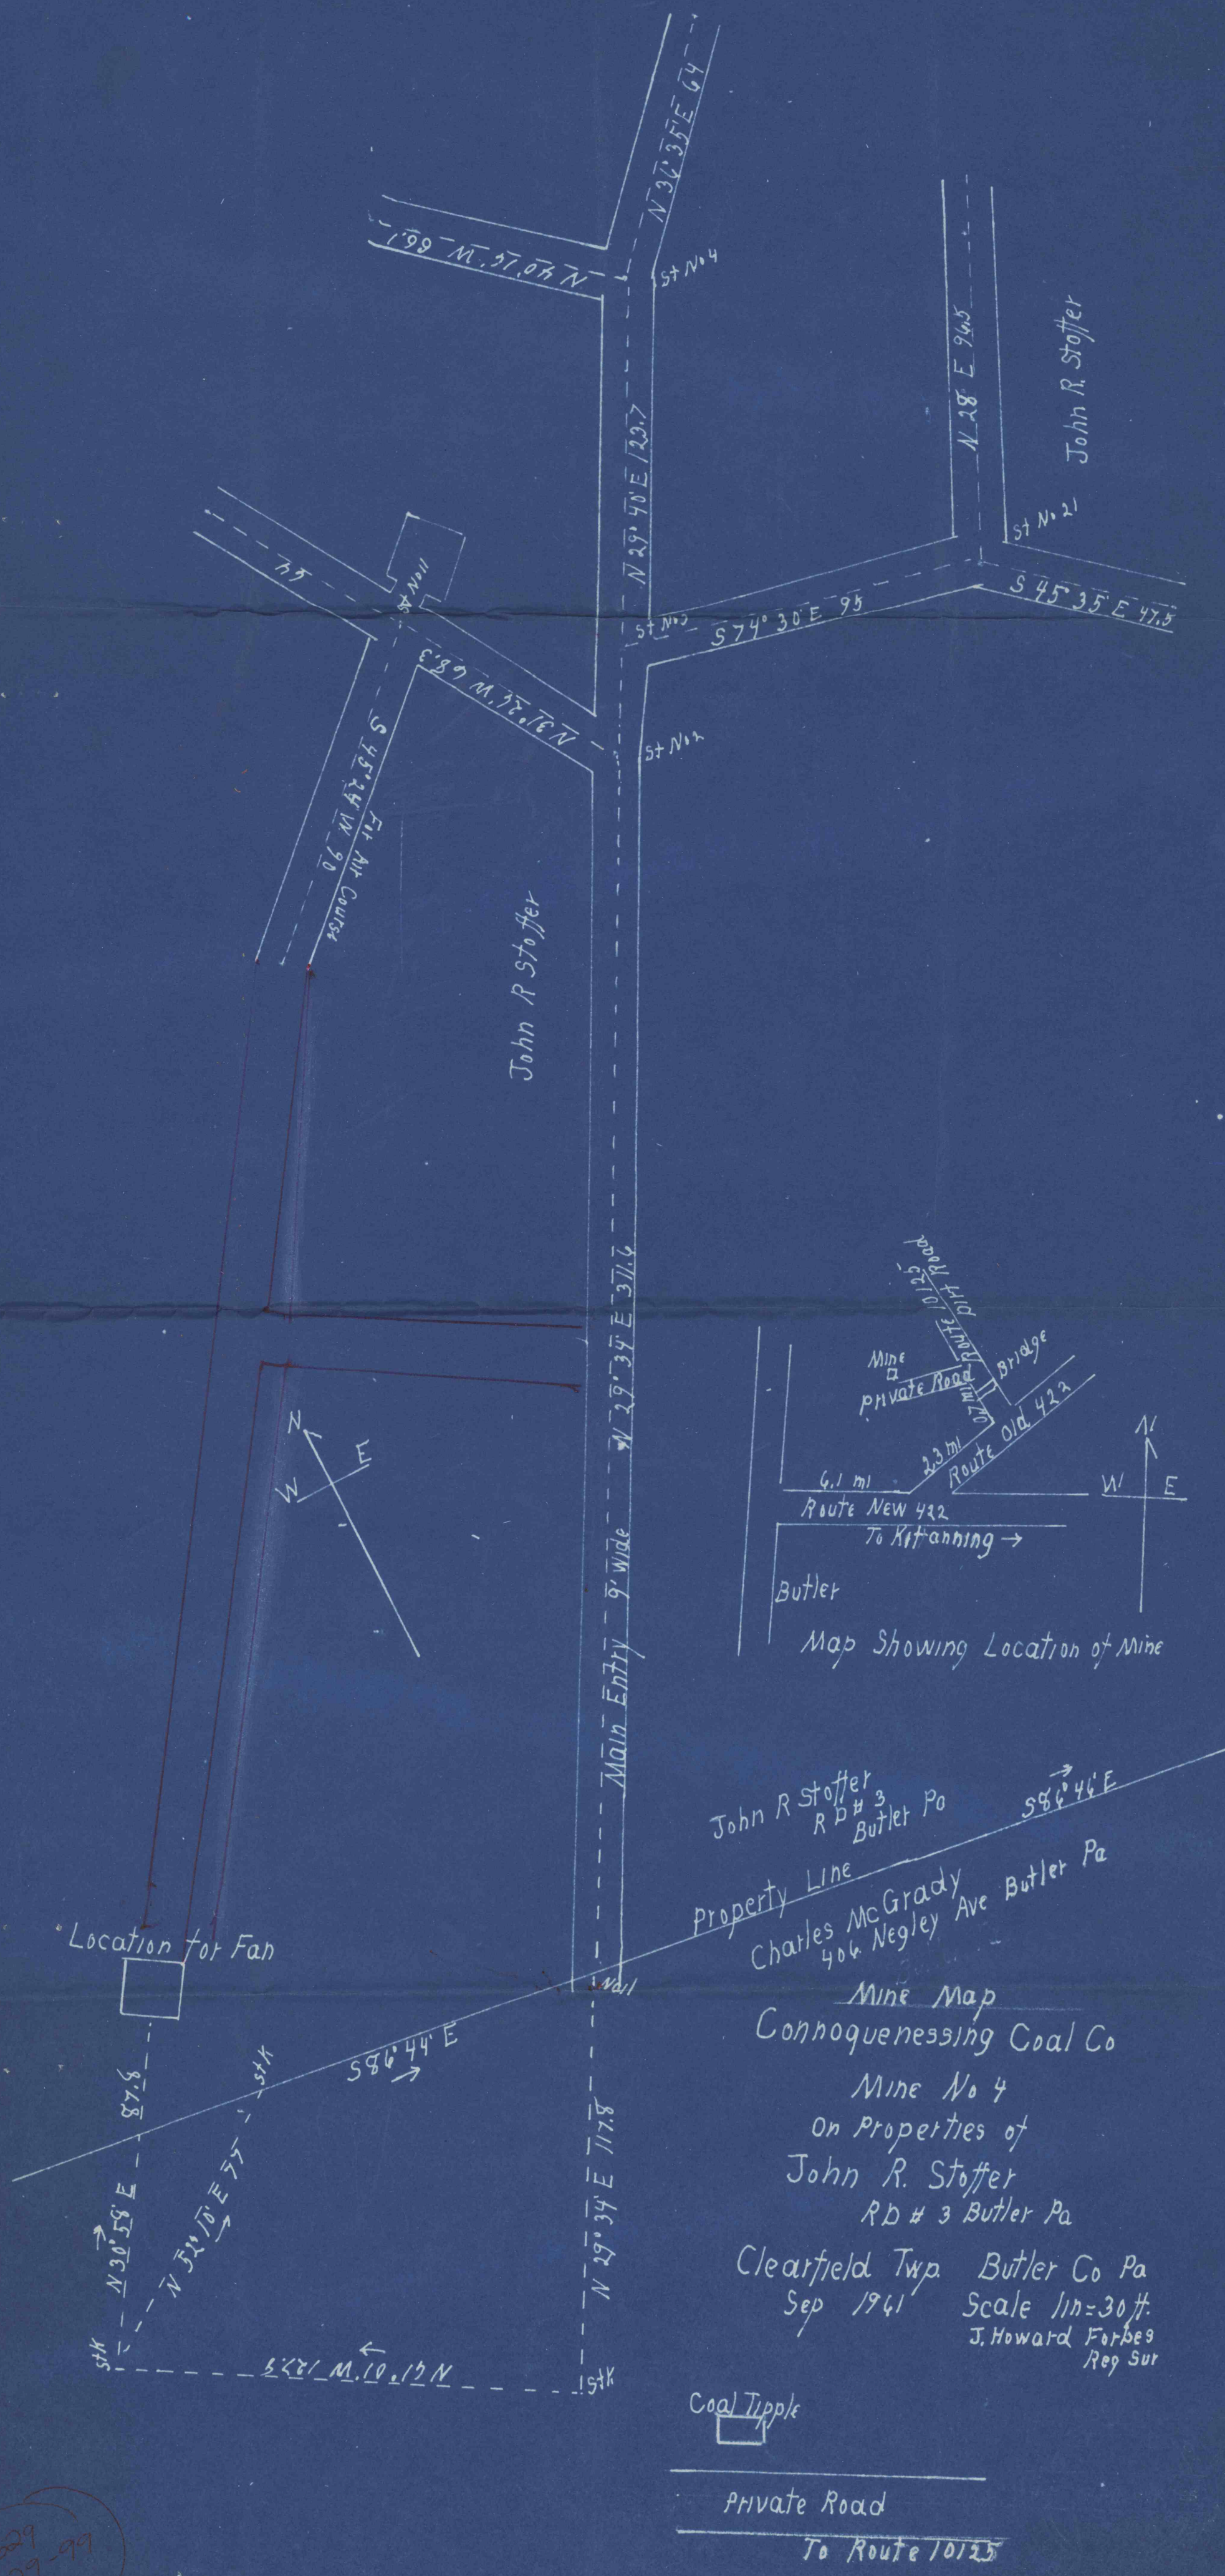

John R Stoffer  
RD # 3  
Butler Pa

Property Line

Charles McGrady  
406 Negley Ave  
Butler Pa

Mine Map  
Connoquenessing Coal Co  
Mine No 4  
On Properties of  
John R. Stoffer  
RD # 3 Butler Pa

Clearfield Twp Butler Co Pa  
Sep 1961 Scale 1in=30ft.  
J. Howard Forbes  
Reg Sur

Coal Tipple

Private Road  
To Route 10125