


— H.C. Stineman Lease —

— Cambria Steel Co. Lease —

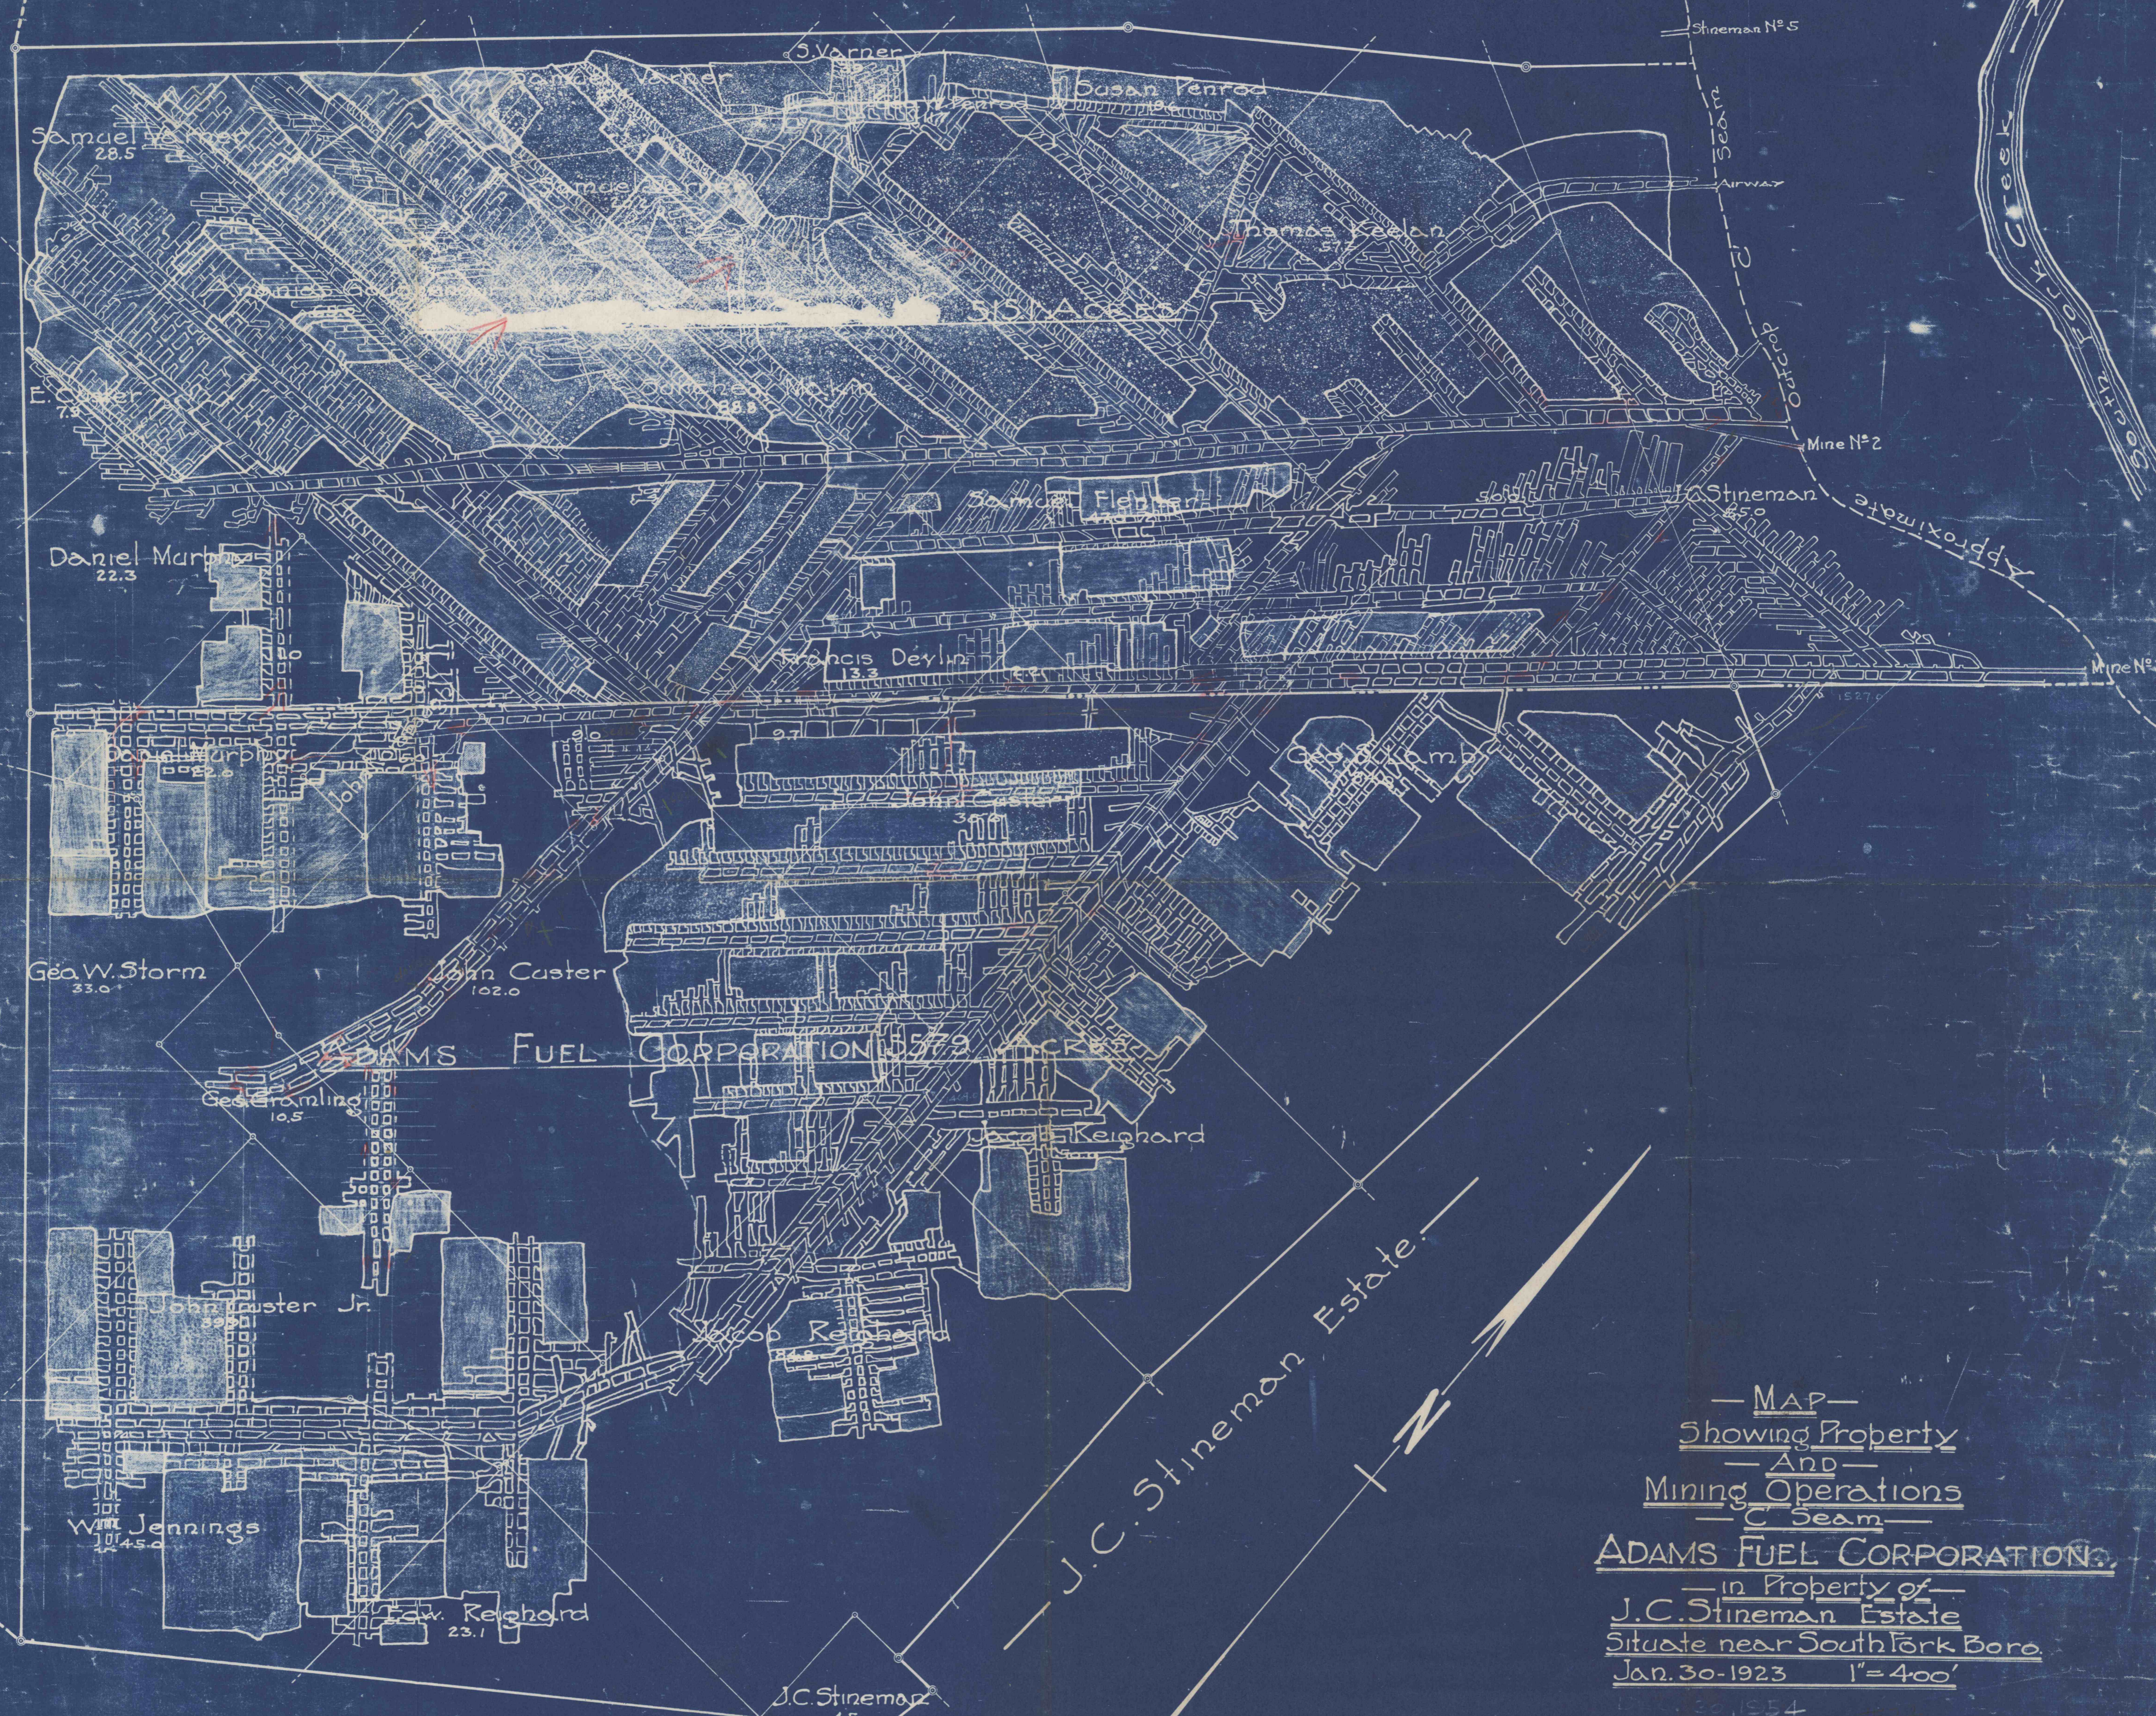

J.C. Stineman Estate

— MAP —
 Showing Property
 — And —
 Mining Operations
 — C Seam —
ADAMS FUEL CORPORATION
 — in Property of —
 J.C. Stineman Estate
 Situate near South Fork Boro.
 Jan. 30-1923 1" = 400'
 1954