


LEGEND

- Coal Exchange Line. ————
- Coal Property Line. ————
- Surface Property Line. ————
- Coal & Surface Property Line. ————
- Creeks. ————
- Oil And Gas Wells. ⊕
- Diamond Drill Holes. °
- Public Roads. ————
- Surface Elevations. 855.5'
- Bottom Of Coal Contours. ————

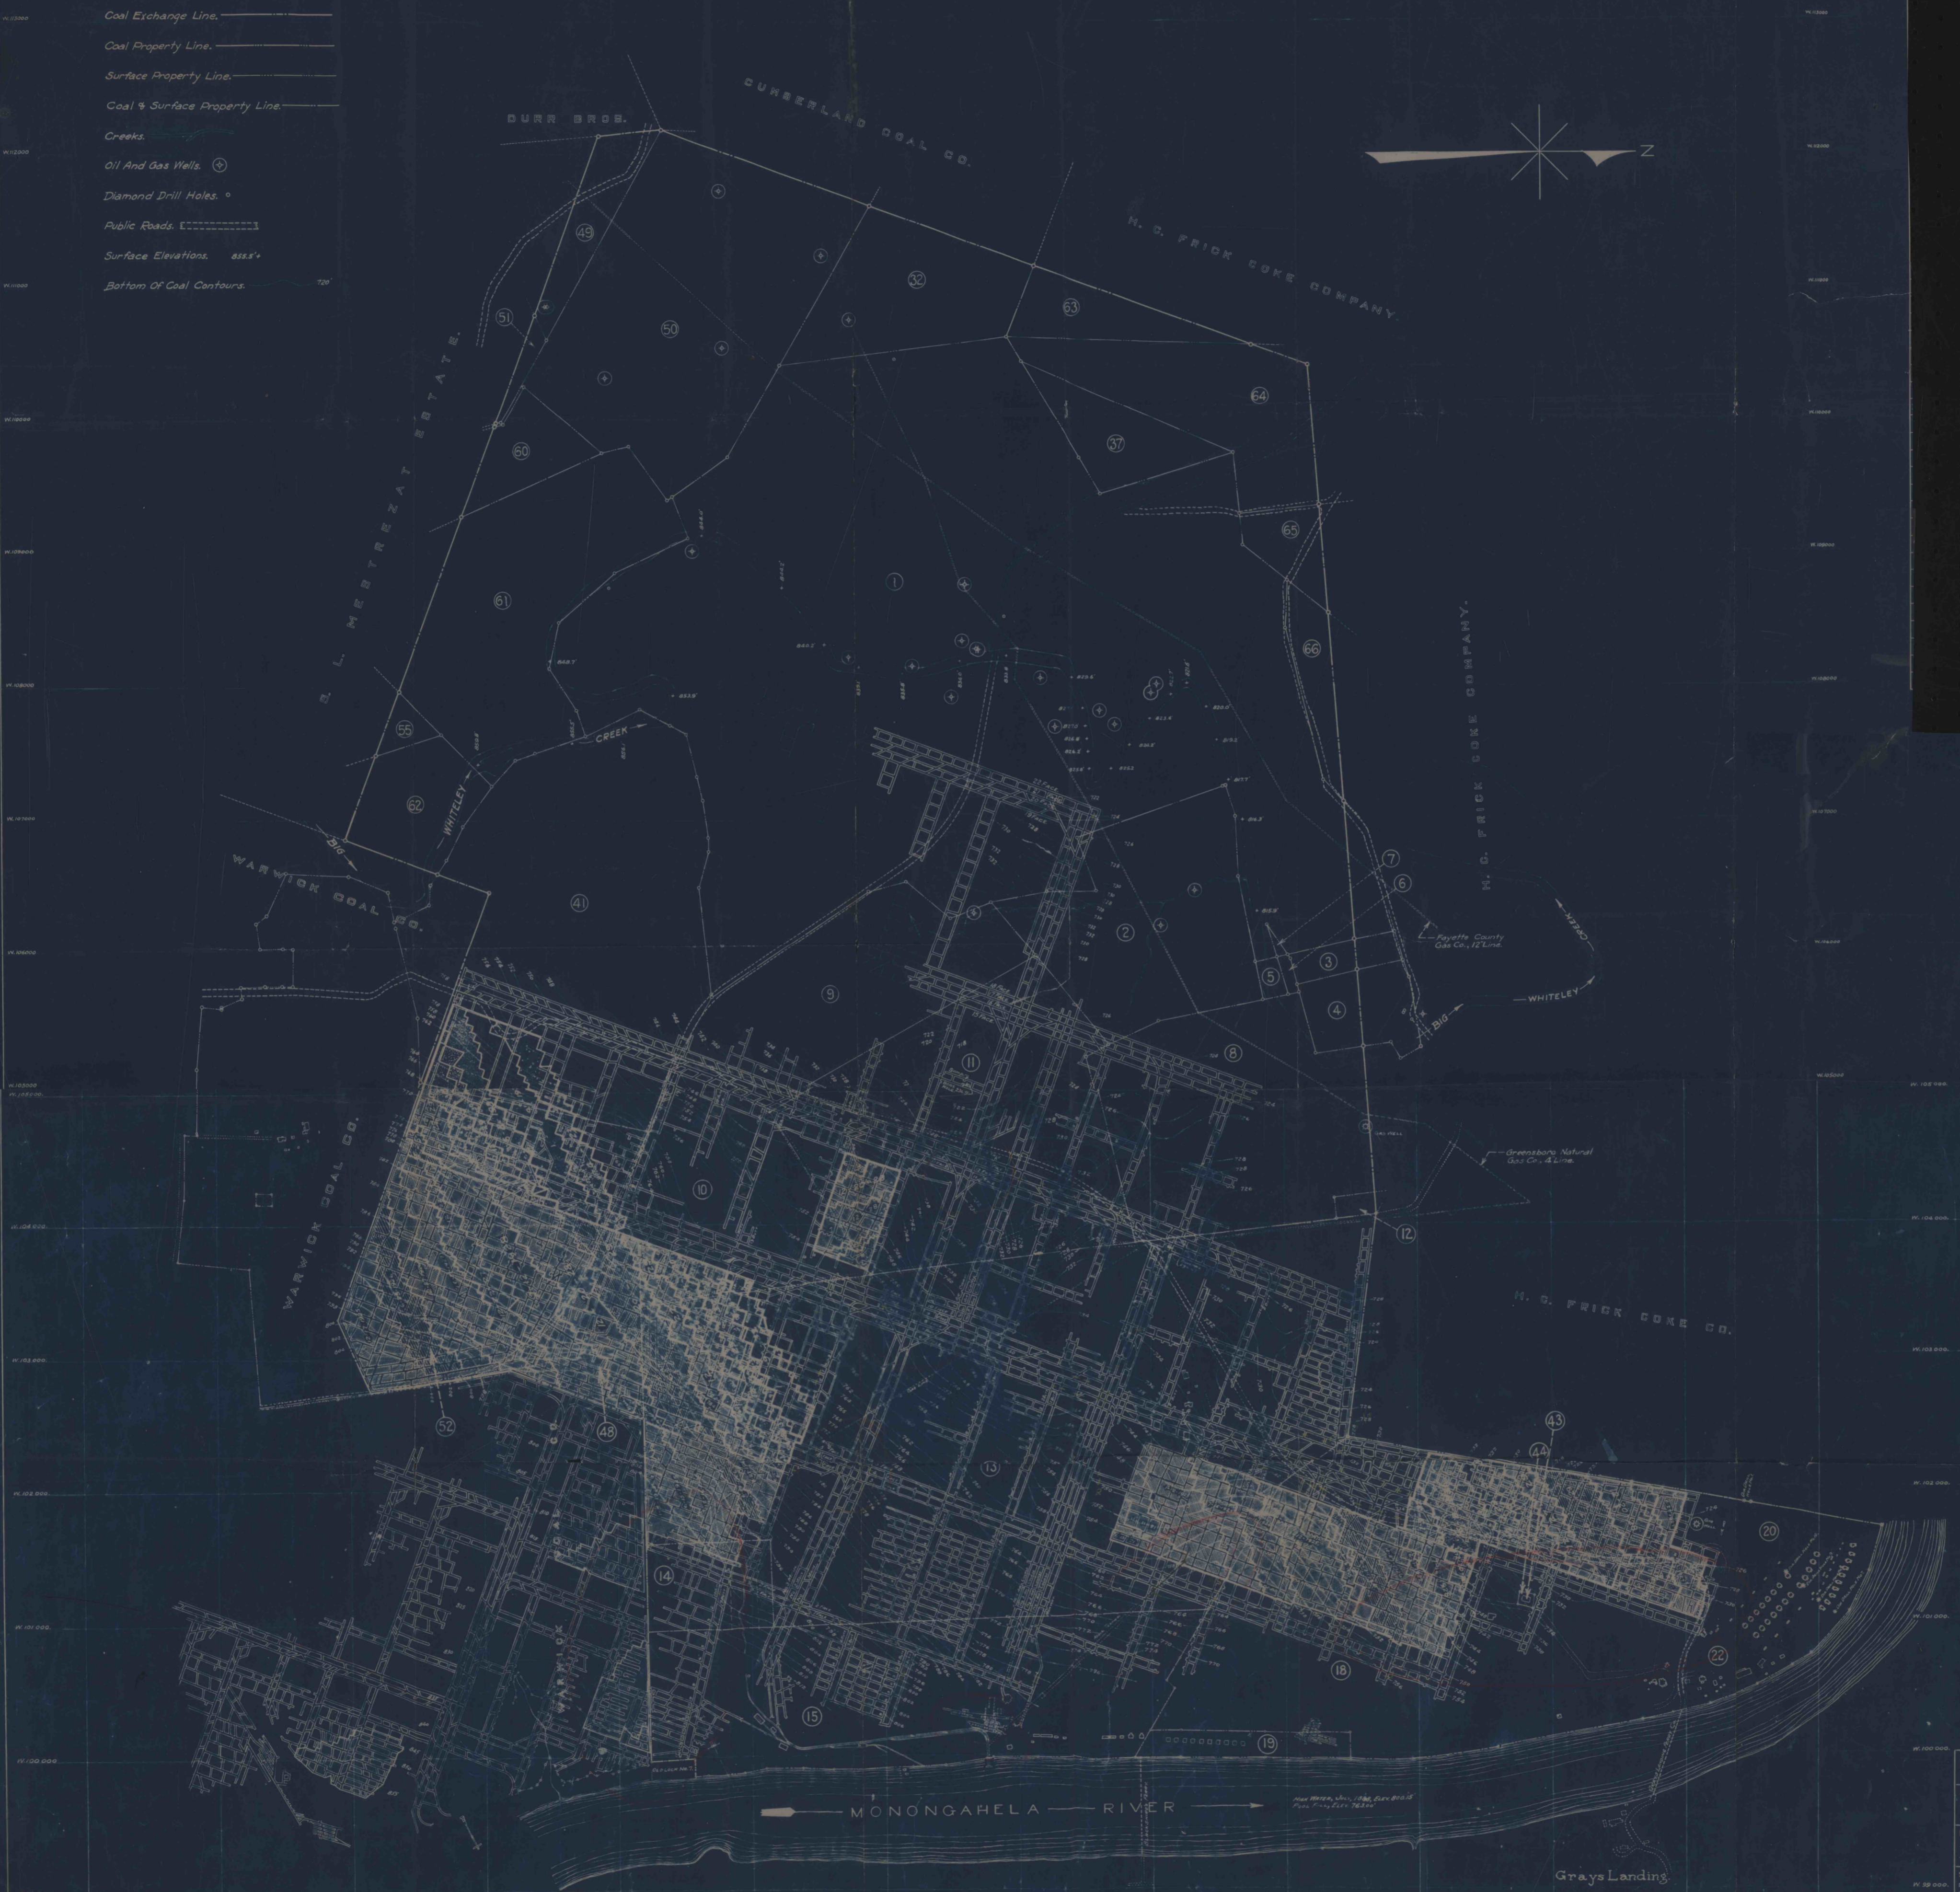

MONESSEN COAL AND COKE CO.  
 ALLIANCE, PA.  
 SUBJECT: CONTOURS SHOWING  
 BOTTOM OF COAL  
 ELEVATIONS,  
 PITTSBURGH COAL FIELD,  
 FOR ALICIA MINE No. 2,  
 MONONGAHELA TOWNSHIP,  
 GREENE COUNTY, PA.  
 SCALE: 1" = 400'  
 DRAWN BY: W. A. P. DATE: JULY 3, 1927.  
 CHECKED BY: C. C. P. DATE: JULY 3, 1927.  
 DATE PRINTED: DRAWING NUMBER:  
 620