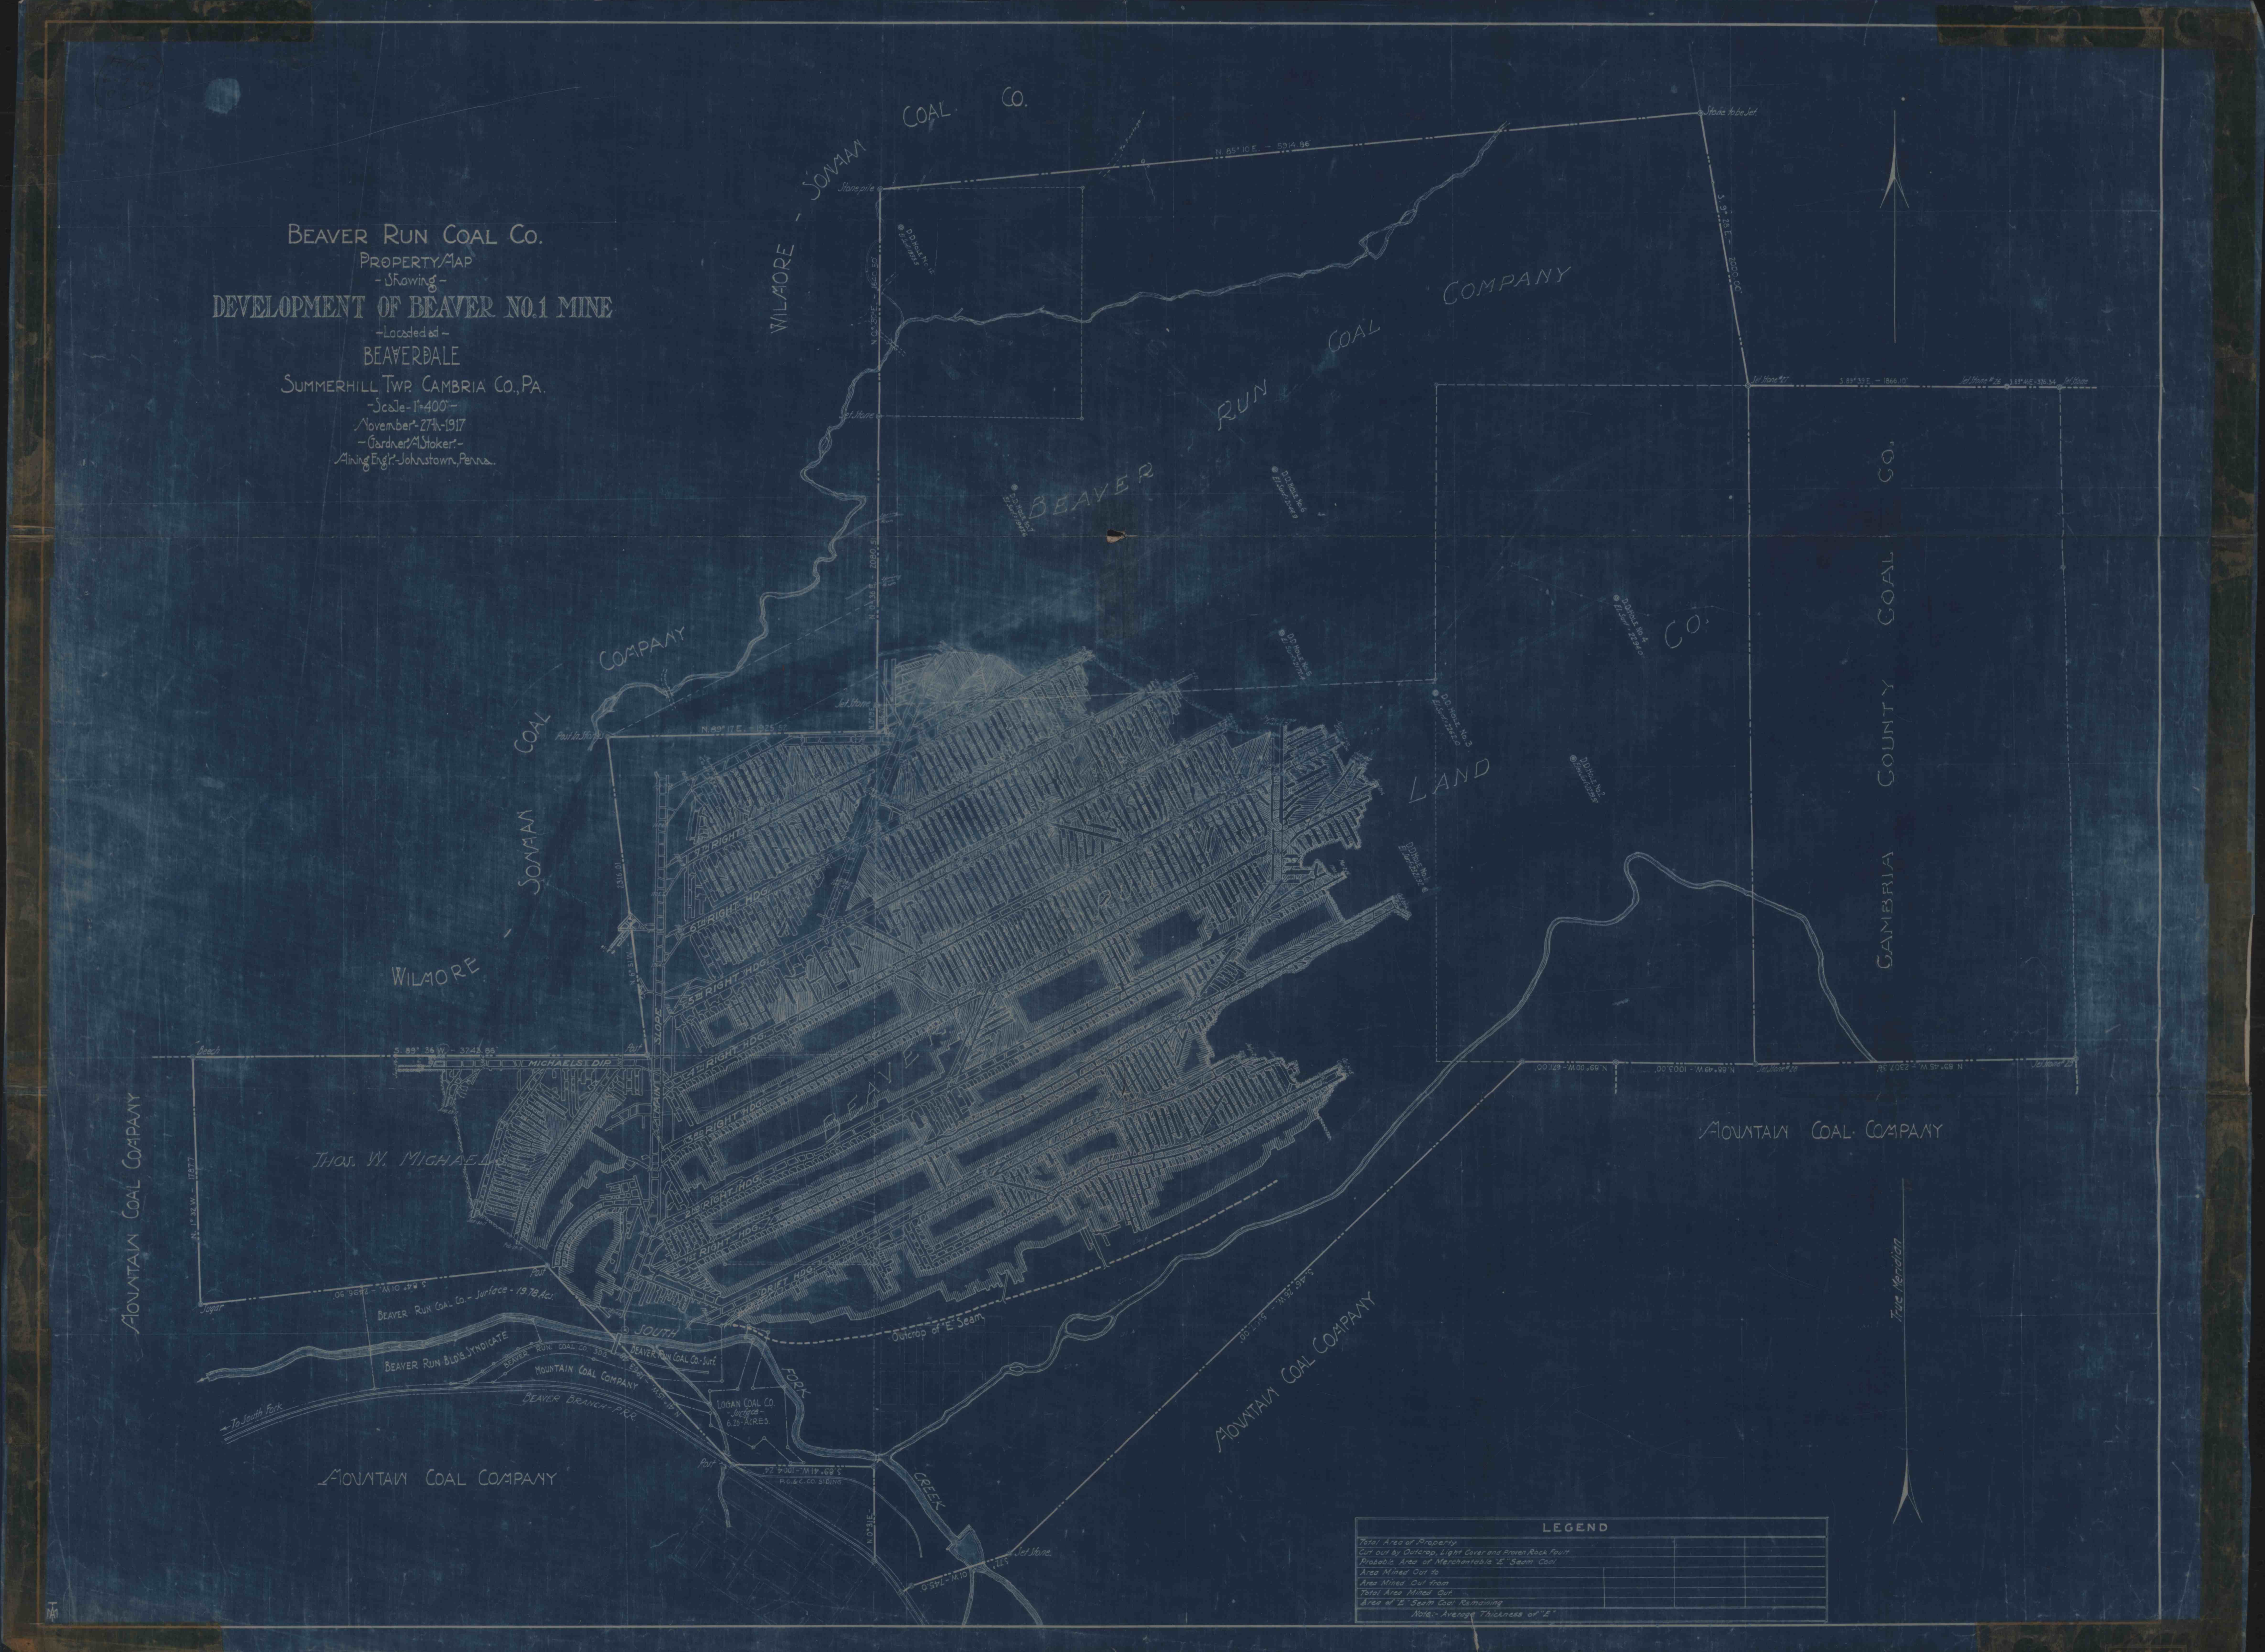

BEAVER RUN COAL CO.
PROPERTY MAP
- Showing -
DEVELOPMENT OF BEAVER NO.1 MINE
- Located at -
BEAVERDALE
SUMMERHILL TWP. CAMBRIA CO., PA.
- Scale - 1"=400' -
November - 27th - 1917
- Gardner M. Stoker -
Mining Eng'r. - Johnstown, Penna.
WILMORE - SONMAN COAL CO.
WILMORE - SONMAN COAL COMPANY
BEAVER RUN COAL COMPANY
BEAVER RUN LAND CO.
CAMBRIA COUNTY COAL CO.
MOUNTAIN COAL COMPANY
THOS. W. MICHAELS
Stone pile
Set Stone
Stone to be Set.
Set Stone #27
Set Stone #26
Set Stone #28
Set Stone #29
Post in Stones
Beech
Sugar
Post
N. 85° 10 E. - 5914.86'
S. 9° 28 E. - 2000.00'
S. 89° 39 E. - 1866.10'
S. 89° 46 E. - 376.34
N. 0° 30' E. - 1640.50'
N. 0° 36 E. - 2080.51'
N. 89° 17 E. - 1925.52'
N. 6° 51 W.
2316.01
S. 89° 36 W. - 3243.86'
N. 1° 32 W. - 1787.7
S. 84° 01 W. - 2496.90'
N. 41° 15 W.
S. 89° 41 W. - 1004.24
N. 0° 31 E.
S. 77° 01 W. - 745.0
S. 46° 26 W. - 5127.00
N. 89° 00 W. - 671.00
N. 88° 49 W. - 1003.00
N. 89° 45 W. - 2307.38'
D.D. HOLE No. 1 El. Surf. 2321.92
D.D. HOLE No. 2 Elev. Surf. 2229.97
D.D. HOLE No. 3 El. Surf. 2262.0
D.D. HOLE No. 4 El. Surf. 2294.0
D.D. HOLE No. 5 El. Surf. 2177.4
D.D. HOLE No. 6 El. Surf. 2044.9
D.D. HOLE No. 7 El. Surf. 1942.6
D.D. HOLE No. 12 El. Surf. 1933.5
MICHAELS DIP
MAIN SLOPE
7th RIGHT
6th RIGHT HDG.
5th RIGHT HDG.
4th RIGHT HDG.
3rd RIGHT HDG.
2nd RIGHT HDG.
1st RIGHT HDG.
DRIFT HDG.
Outcrop of "E" Seam
SOUTH FORK CREEK
Beaver Run Coal Co. - Surface - 19.78 Acs.
Beaver Run Bld'g. Syndicate
Beaver Run Coal Co. Sdg.
Beaver Run Coal Co. - Surf.
Mountain Coal Company
Beaver Branch - P.R.R.
To South Fork
LOGAN COAL CO. - Surface - 6.26 Acres.
P.C.&C. CO. SIDING
True Meridian
LEGEND
Total Area of Property
Cut out by Outcrop, Light Cover and Proven Rock Fault
Probable Area of Merchantable "E" Seam Coal
Area Mined Out to
Area Mined Out from
Total Area Mined Out
Area of "E" Seam Coal Remaining
Thickness of "E"