


- Surface Land Over Mine
- Extent Operations Under Permit 75A
- Workings for Six Months 12 A. Oct. 18, 1966 to Apr. 18, 1967
- Area shown on 100 ft.

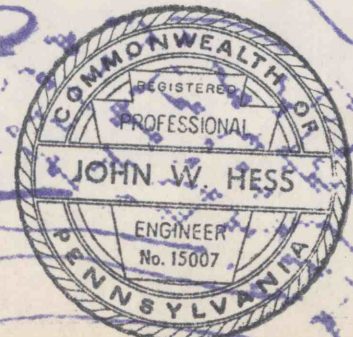

BELFORD COAL CO.
 #9 Cannel Mine
 Girard Twp, Clearfield Co., Pa.
 SCALE - 1 inch = 400 feet
 Oct. 17, 1966
 John W. Hess

H. D. Woolridge

Leontes Mills

Strip Mine

Murray Cem

Sch
Girard Twp.

Kristianson & Johnson
coal Co
47 A.

#9 Cannel mine
Seam
ele: 1363

A. A. Murray Est
163A

Paul G. Smith and
Christon Zindel

Shawville Coal Co - 50A

Moble & Rougeau

Norman Jurg

Russell Feykiv

Lingle Coal Co.

Lingle Coal Co.
112A

1560

1400-

1300

1500

1500

1552

1410

1266

1459

Op. period

7633

Normal
RISE
1%

North
1" = 400'

unmarked
stream

TP Deer Creek

PHOENIX

STRIP

Worked














