

BETHENERGY MINES INC.
ELLSWORTH DIVISION
MINE NO. 58


AMWELL TWP. WASHINGTON COUNTY
 WEST BETHLEM TWP. WASHINGTON COUNTY
 SCALE 1:400' SURVEY DATE 3-7-88

LEGEND

- 5 YEAR PERMIT AREA & SUBSIDENCE
- CONTROL PLAN AREA
- ▲ PRE 1966 HOUSE
- AN POST 1966 HOUSE
- T PRE 1966 TRAILER
- TN POST 1966 TRAILER
- B BARN
- C GARAGE
- D OUTBUILDING
- CB COMMERCIAL BUILDING
- PB PUBLIC BUILDING
- SUPPORT AREA
- PILLARS IN PLACE
- GAS WELL
- GAS LINE

Dept. of Environmental Resources
 Military District Office
 SEP 10 1991

DOUGLAS PATTERSON

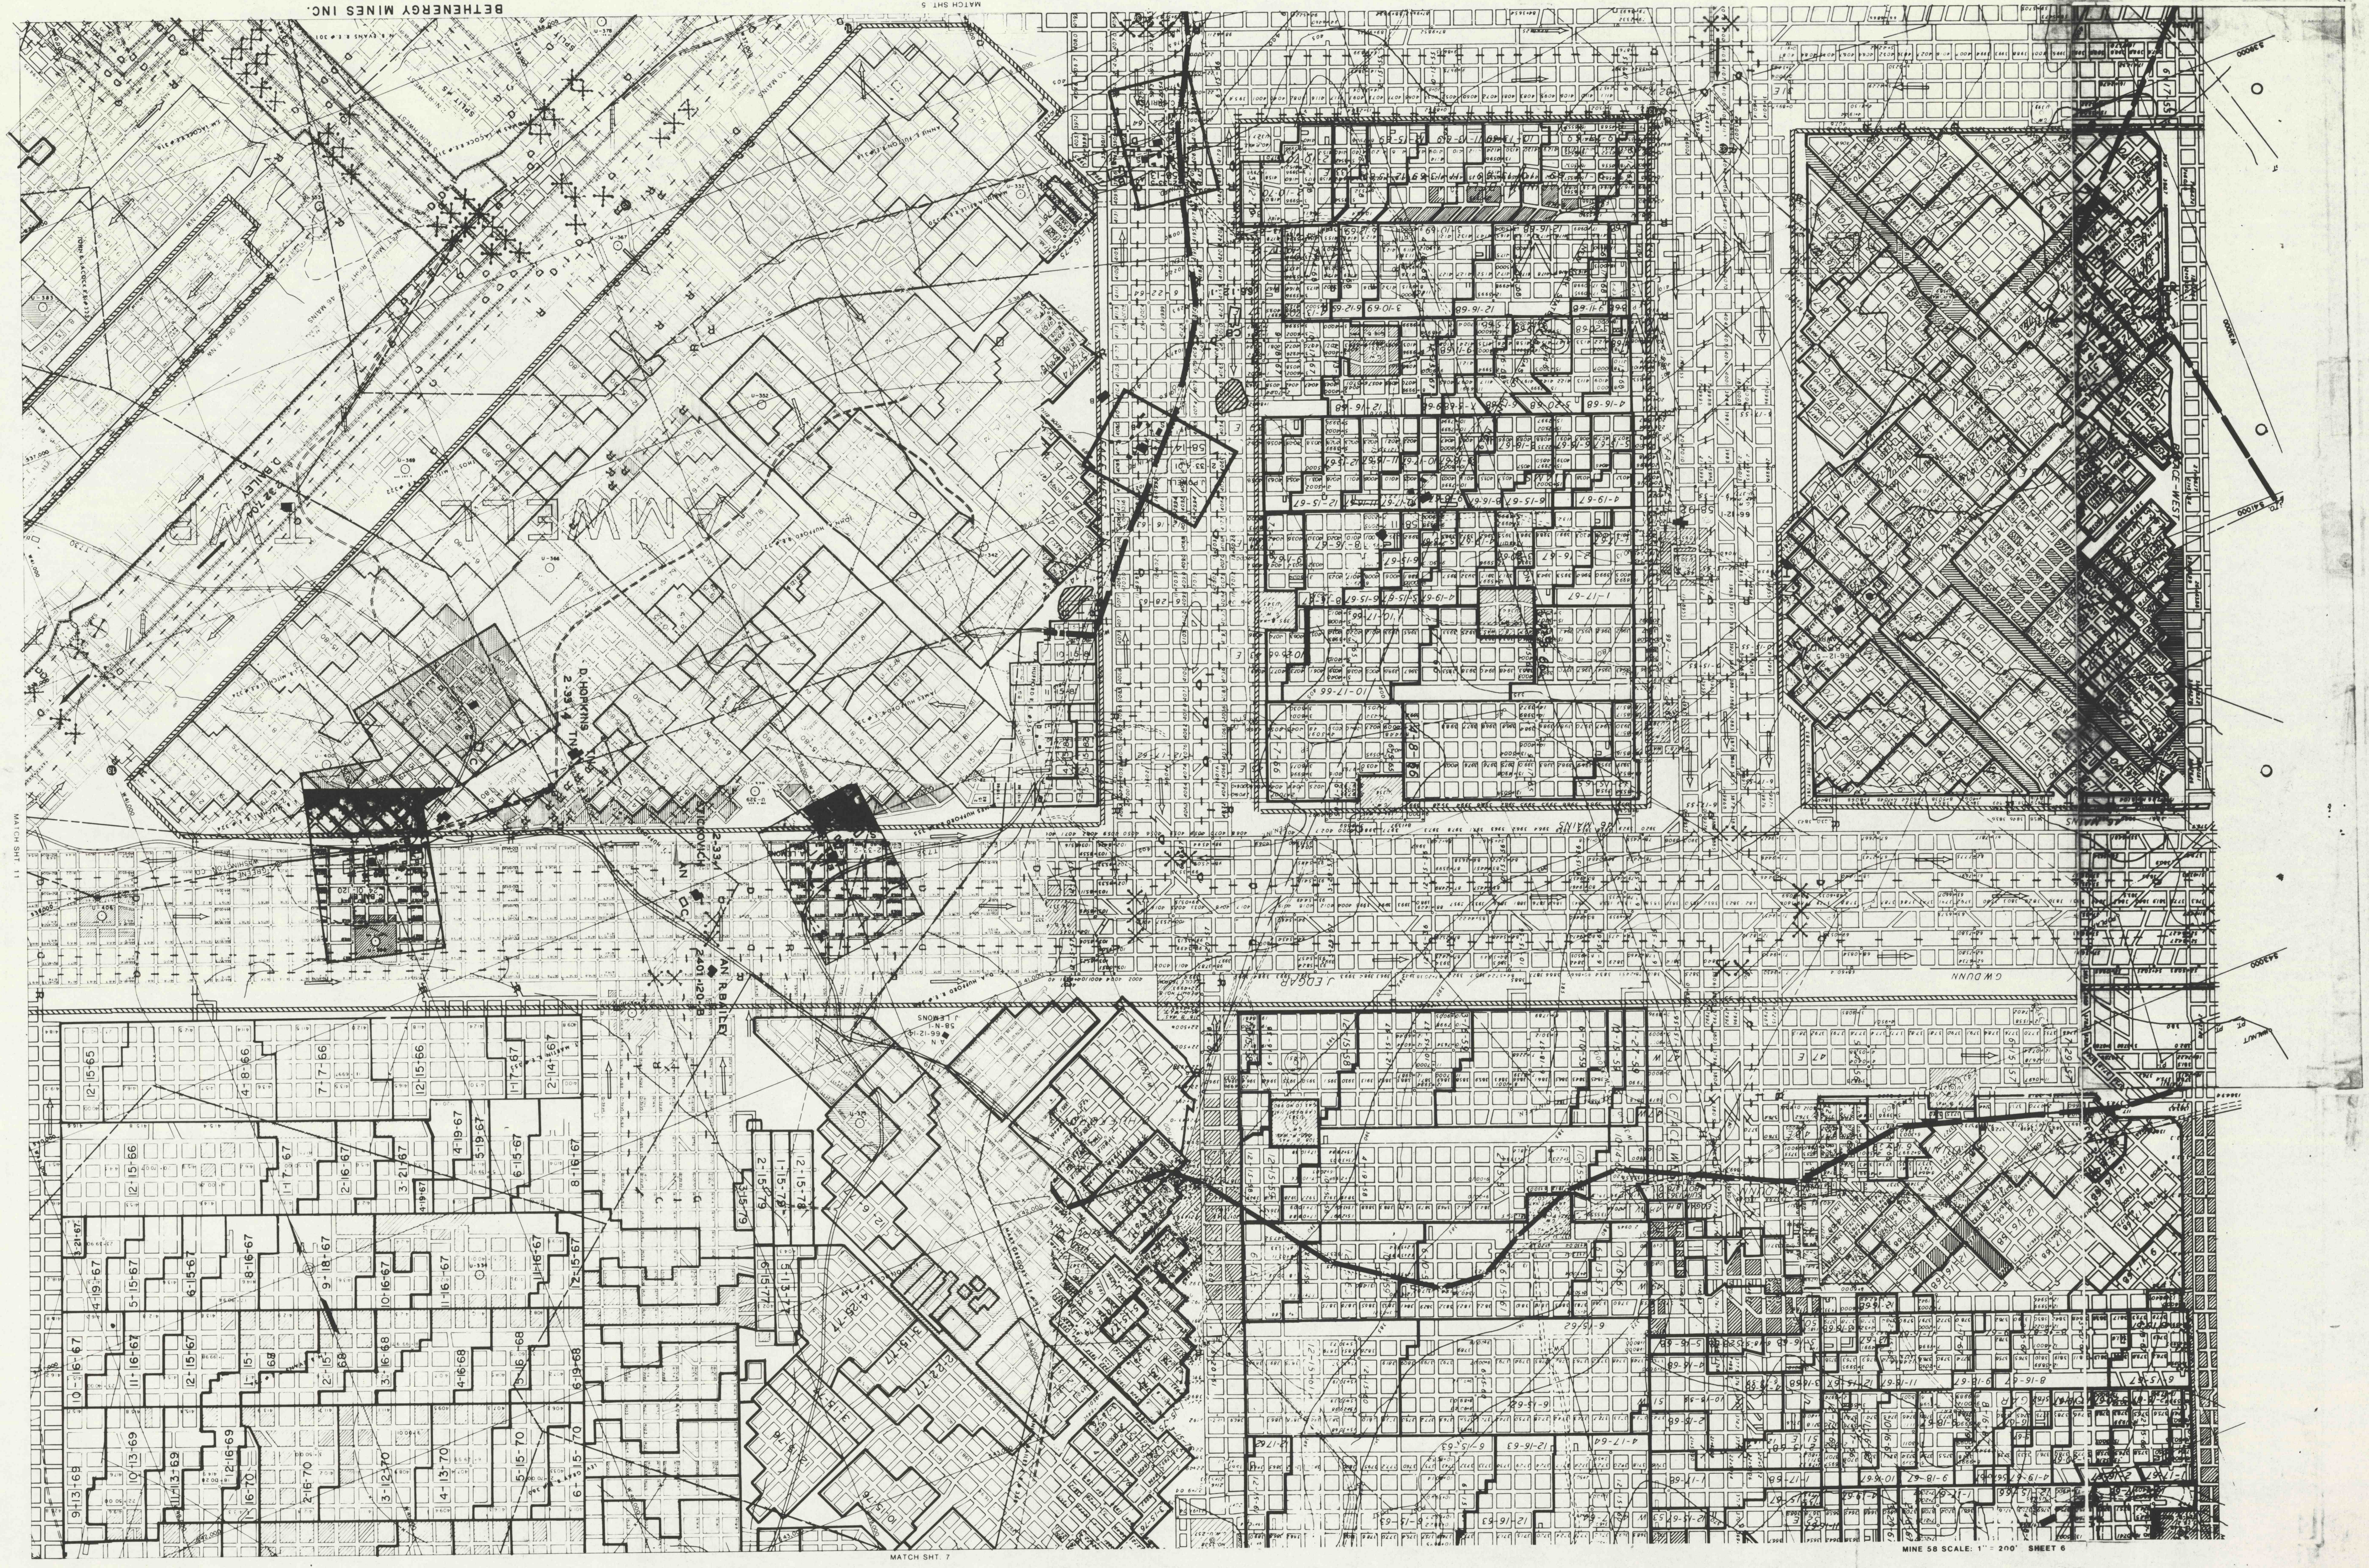

BETHENERGY MINES INC.
 ELLSWORTH DIVISION
 PGM COAL MINE 58
 SCALE: 1"=400' NOV. 1987
 SHEET 6