


BETHEMERGY MINES INC.  
 ELLSWORTH DIVISION  
 MINE NO. 58  
 AMWELL TWP. WASHINGTON COUNTY  
 WEST BETHEMER TWP. WASHINGTON COUNTY  
 SCALE 1"=400' SURVEY DATE 3-7-88  
 PITTSBURGH COAL SEAM

**LEGEND**

- ▬ MINE BOUNDARY
- ▨ 5 YEAR PERMIT AREA & SUBSIDIARY CONTROL PLAN AREA
- ▲ PRE 1966 HOUSE
- AN POST 1966 HOUSE
- T PRE 1966 TRAILER
- TN POST 1966 TRAILER
- B BARN
- C GARAGE
- D OUTBUILDING
- CB COMMERCIAL BUILDING
- PB PUBLIC BUILDING
- SUPPORT AREA
- ▨ PILLARS IN PLACE
- GAS WELL
- - - GAS LINE

RECEIVED  
 SEP 10 1991  
 Dept. of Environmental Resources  
 Bureau of Geology & Mineral Resources

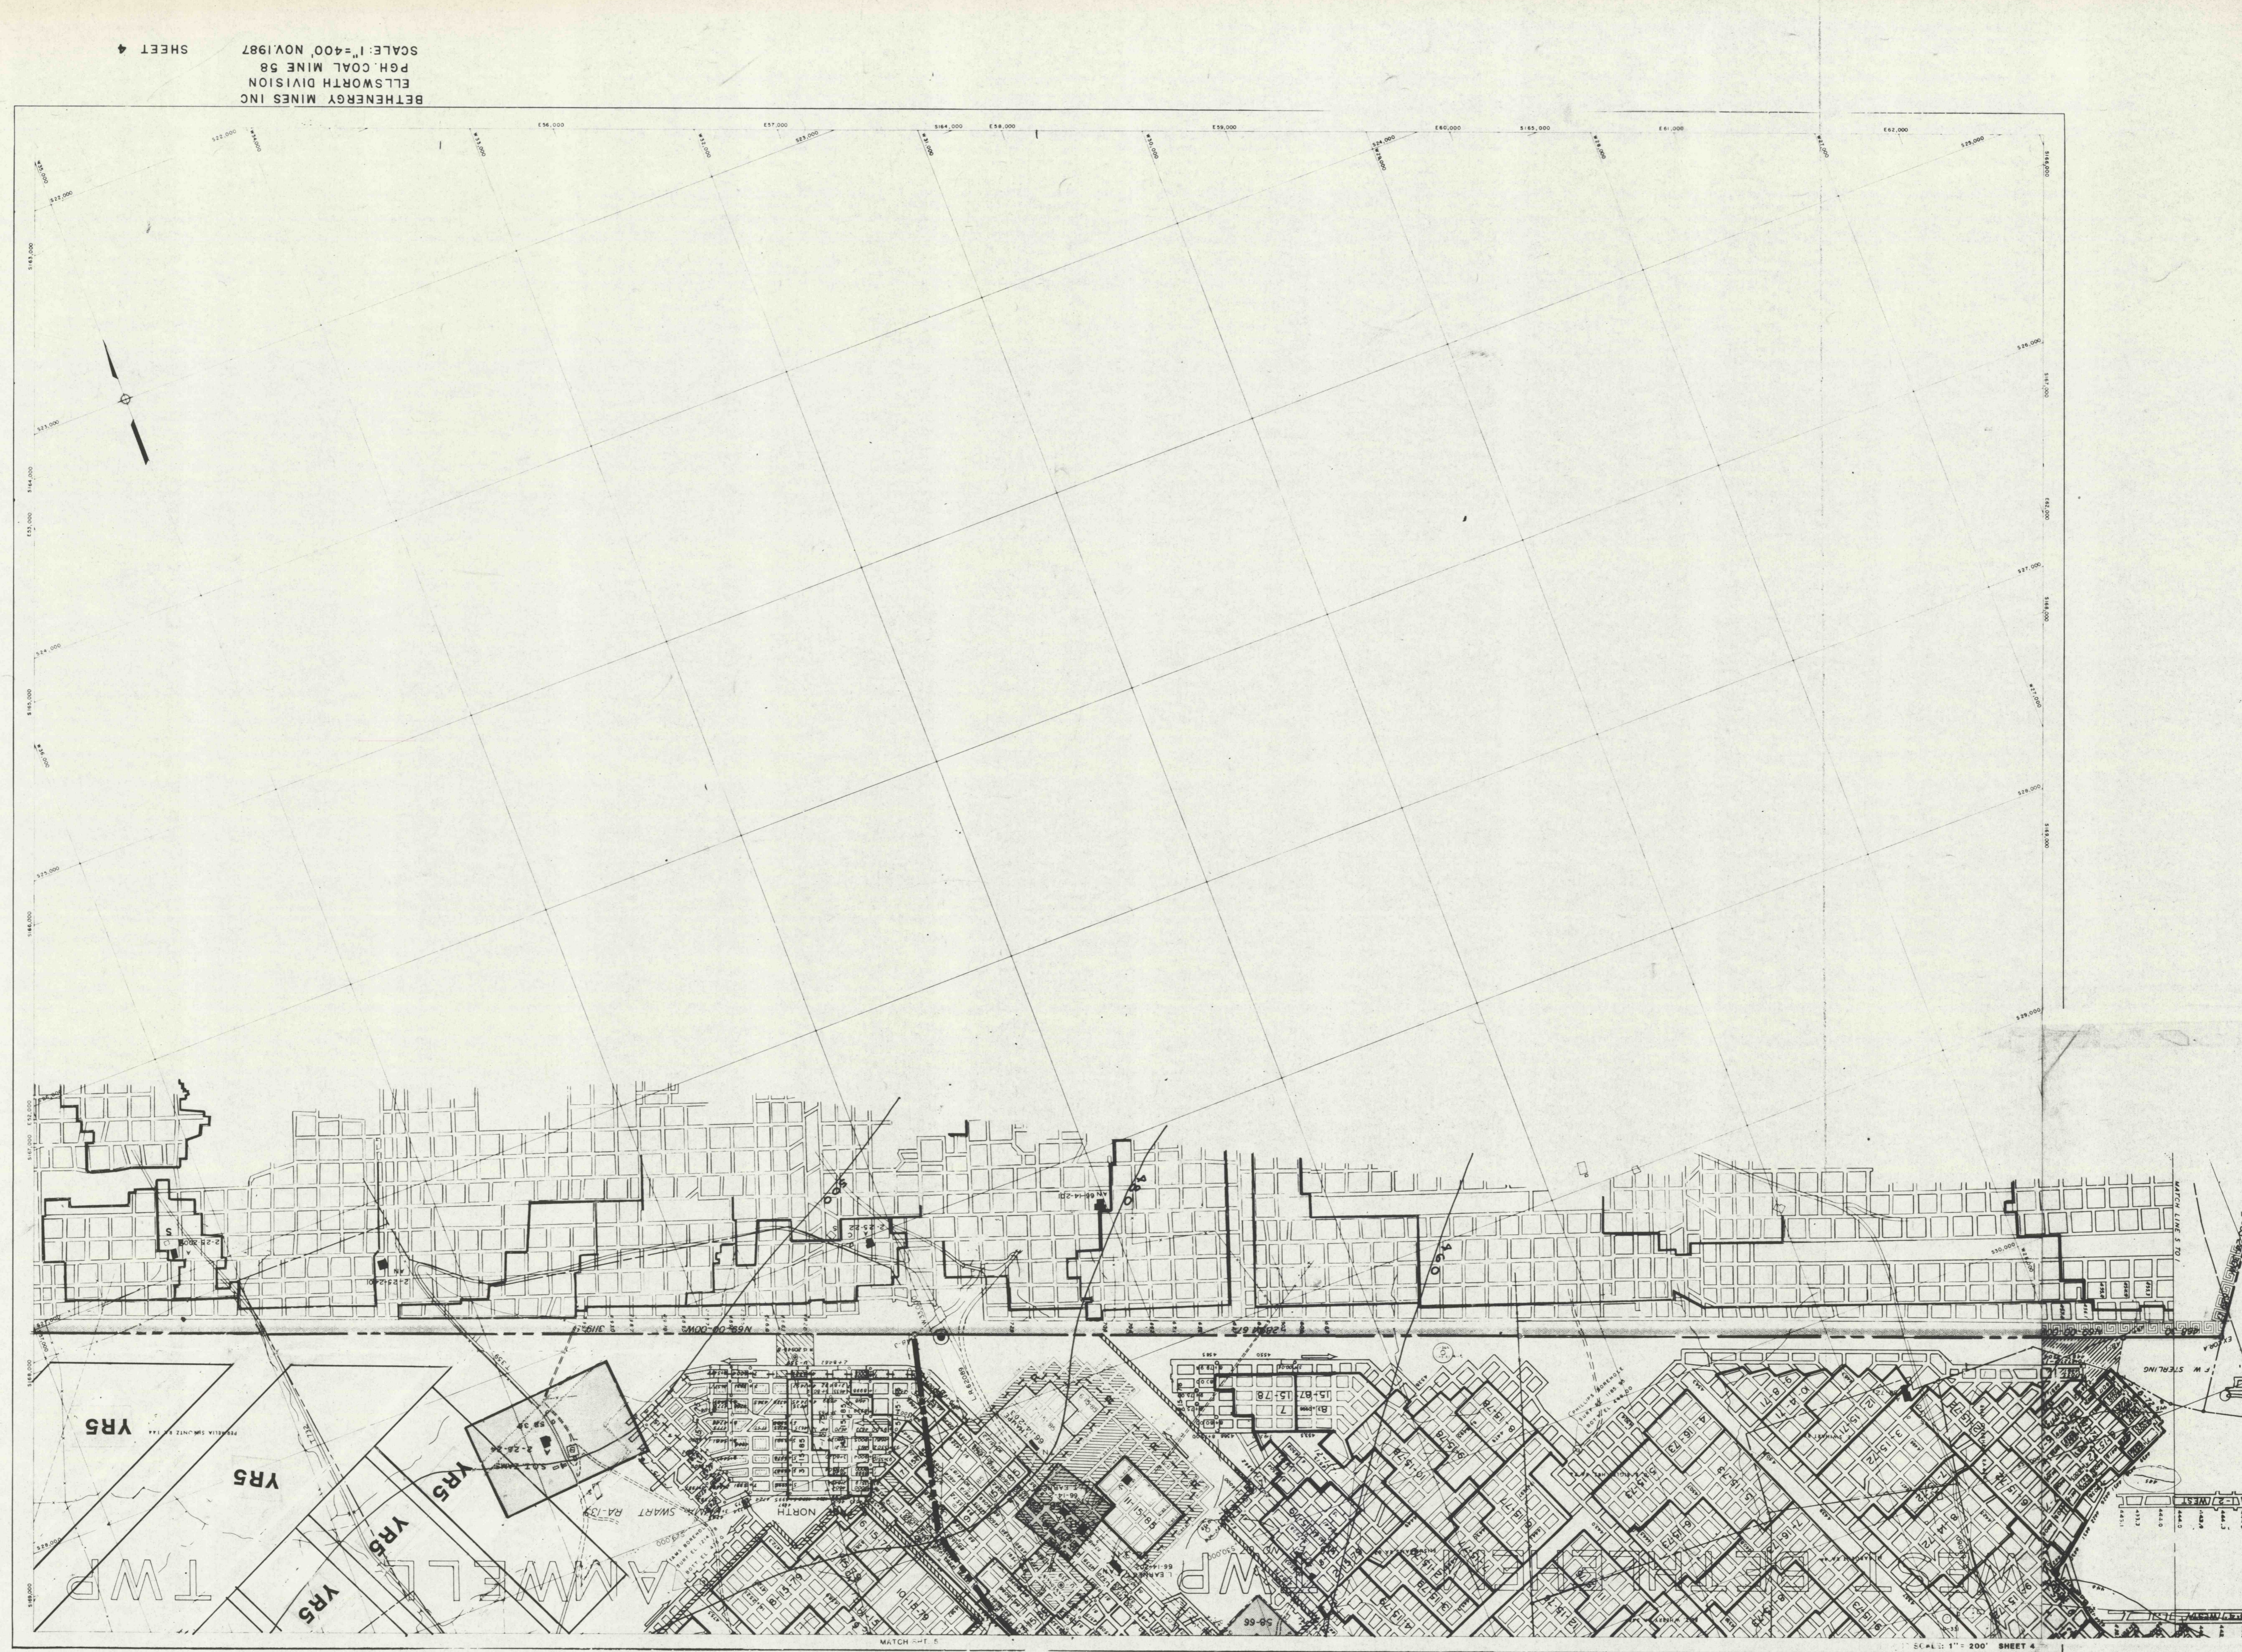

BETHEMERGY MINES INC  
 ELLSWORTH DIVISION  
 PGM COAL MINE 58  
 SCALE: 1"=400' NOV/1987  
 SHEET 4

SCALE: 1" = 200' SHEET 4