


SHEET No 3



**BETHLEHEM MINES INC.**  
ELLSWORTH DIVISION  
MINE NO. 58


WASHINGTON COUNTY  
WEST BETHLEHEM TWP.  
GREEN COUNTY  
MORGAN TWP.  
WASHINGTON TWP.  
SCALE 1"=400'  
SURVEY DATE 3-7-88

**LEGEND**

- ▨ MINE BOUNDARY & SUBSIDENCE
- ▨ 5 YEAR PERMIT AREA & SUBSIDENCE
- ▨ CONTROL PLAN AREA
- ▨ A PRE 1966 HOUSE
- ▨ AN POST 1966 HOUSE
- ▨ T PRE 1966 TRAILER
- ▨ TN POST 1966 TRAILER
- ▨ B BARN
- ▨ C GARAGE
- ▨ D OUTBUILDING
- ▨ CB COMMERCIAL BUILDING
- ▨ PB PUBLIC BUILDING
- SUPPORT AREA
- ▨ PILLARS IN PLACE

DEPT. OF ENVIRONMENTAL RESOURCES  
McMurry District Office  
SEP 10 1991  
RECEIVED

PITTSBURGH COAL SEAM

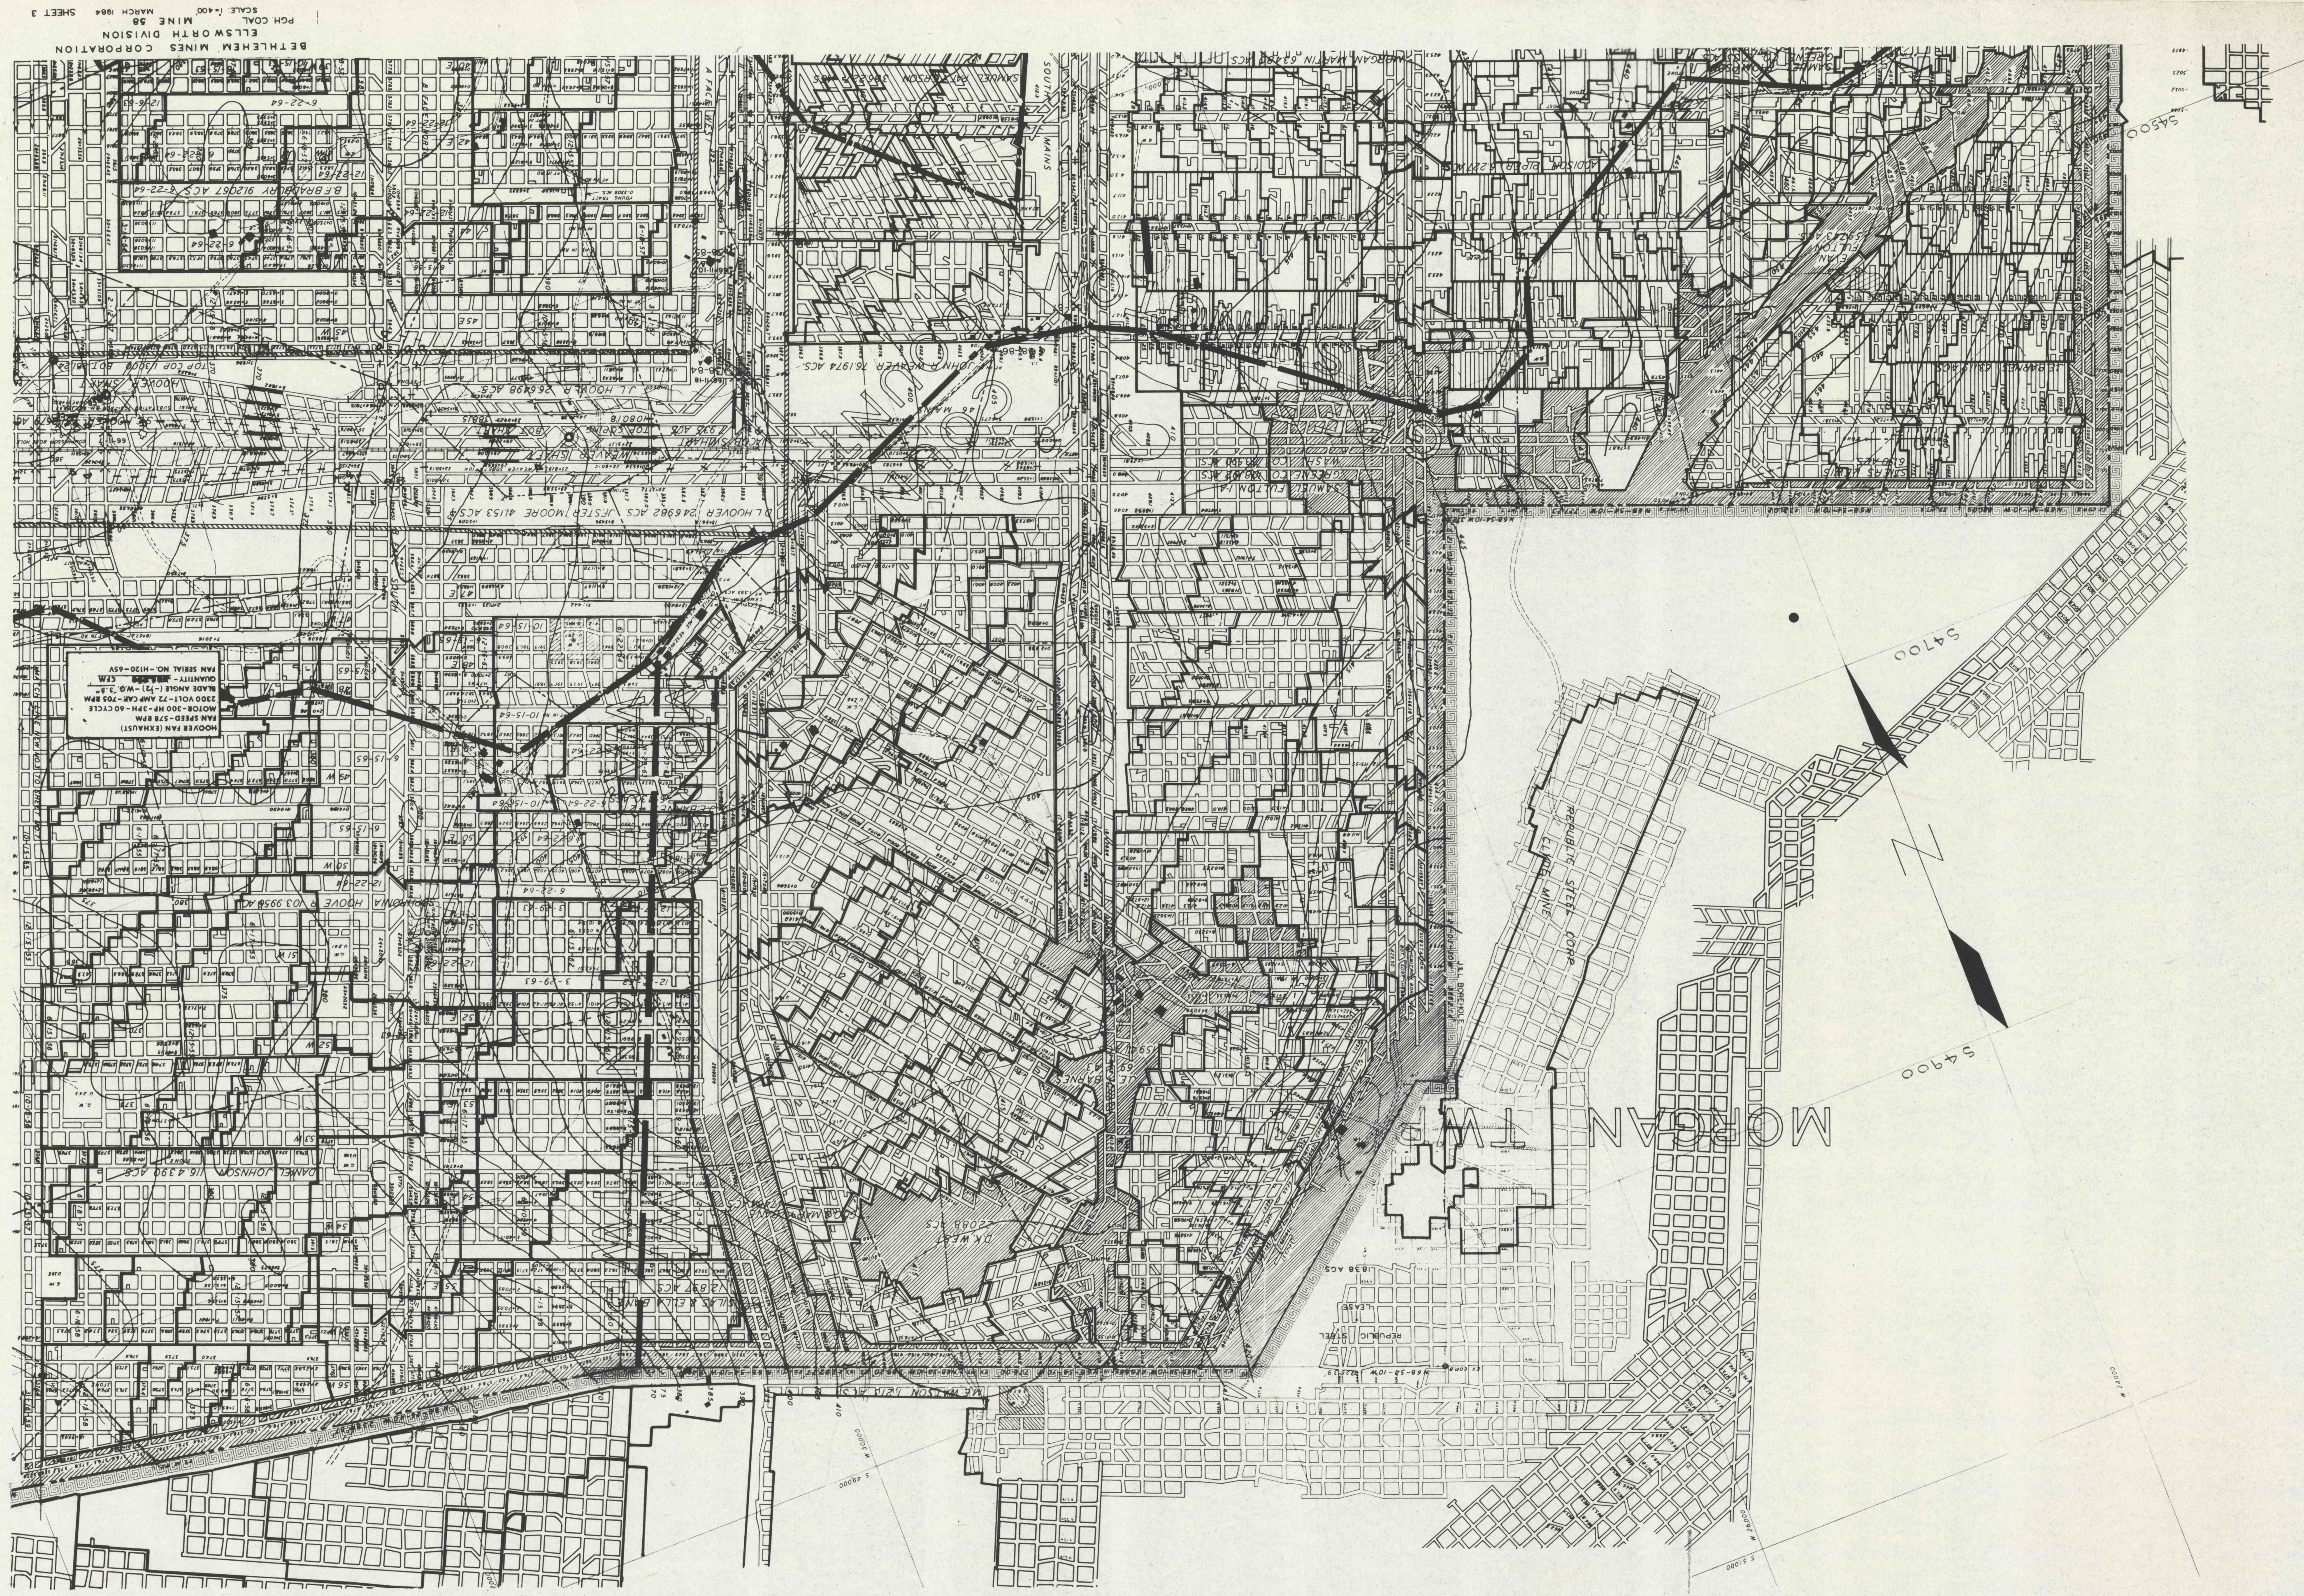

BETHLEHEM MINES CORPORATION  
 ELLSWORTH DIVISION  
 PCH COAL MINE, MARCH 1988  
 SCALE 1"=400'  
 SHEET 3